PARENT PARCEL: 10-00-006-118-026

CHILD PARCEL: XX-XX-XXX-XXX-XXX

STARTING POINT: INTERSECTION OF C/L OF BUTTERNUT RIDGE RD. AND WEST LINE OF TOWN OF LEPORTE PLAT

17-03674-D

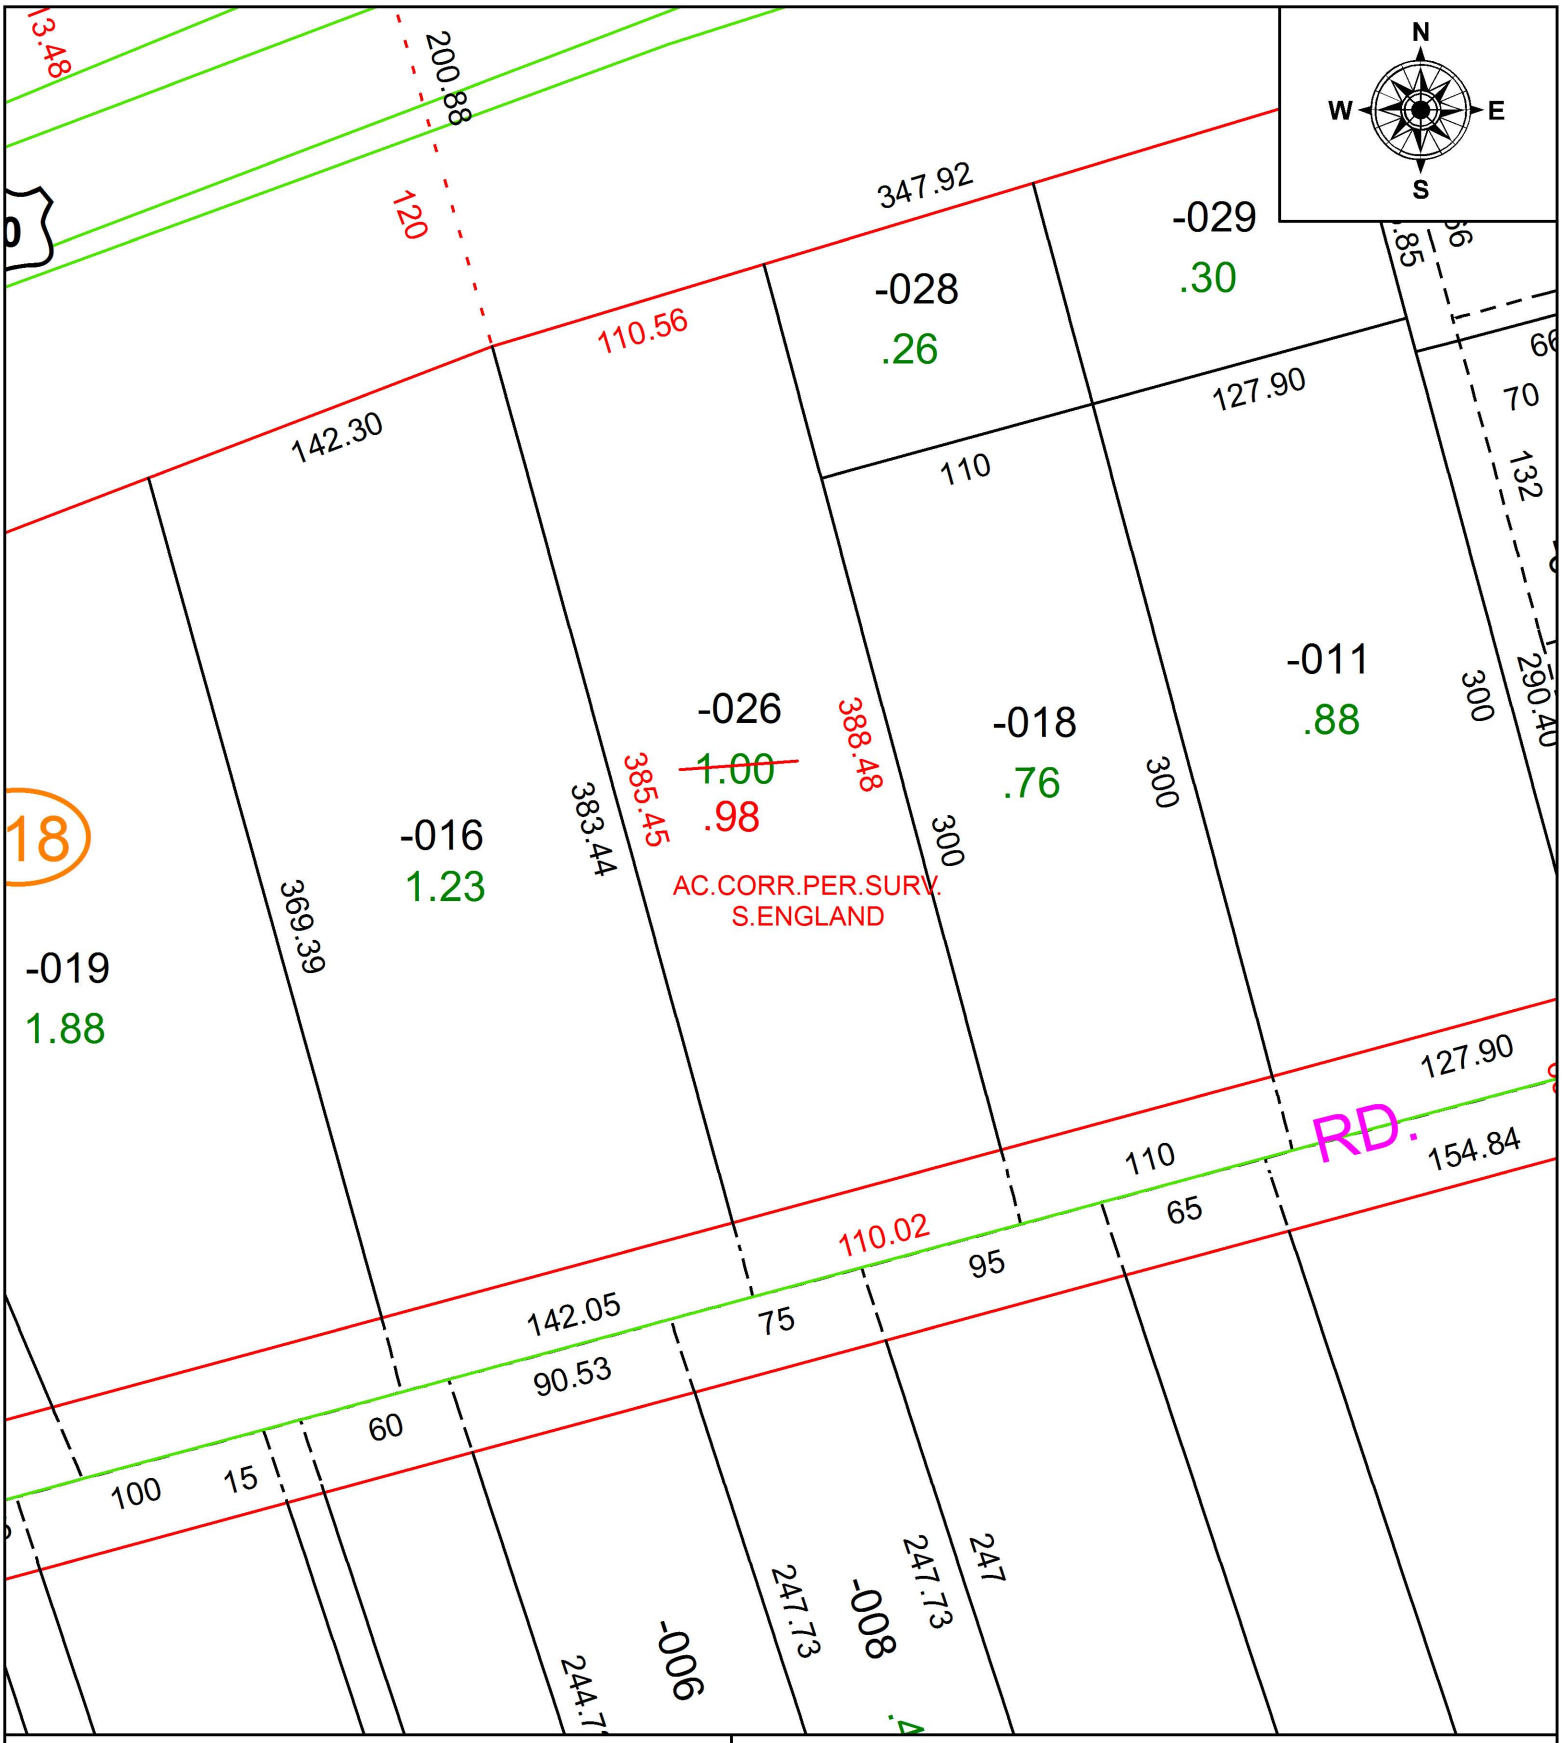

SPLITS/DEEDS PROCESSED

LORAIN COUNTY TAX MAP DEPARTMENT
226 MIDDLE AVE. ELYRIA, OH

SURVEYED BY: SCOTT A. ENGLAND
CLOSURE: 1: 106,539
MAP PAGE(S): 10-00-006
APPOVED BY: RRM **DATE:** 5-18-17
SCALE: 1" = 75 **PRIOR INSTRUMENT:** 20140510786