PARENT PARCEL: 02-01-003-116-167

CHILD PARCEL: 02-01-003-116-168, -169

STARTING POINT: INTERSECTION OF C/L OF SUNSET AVE. AND C/L OF RIVERBEND DR.

17-03674

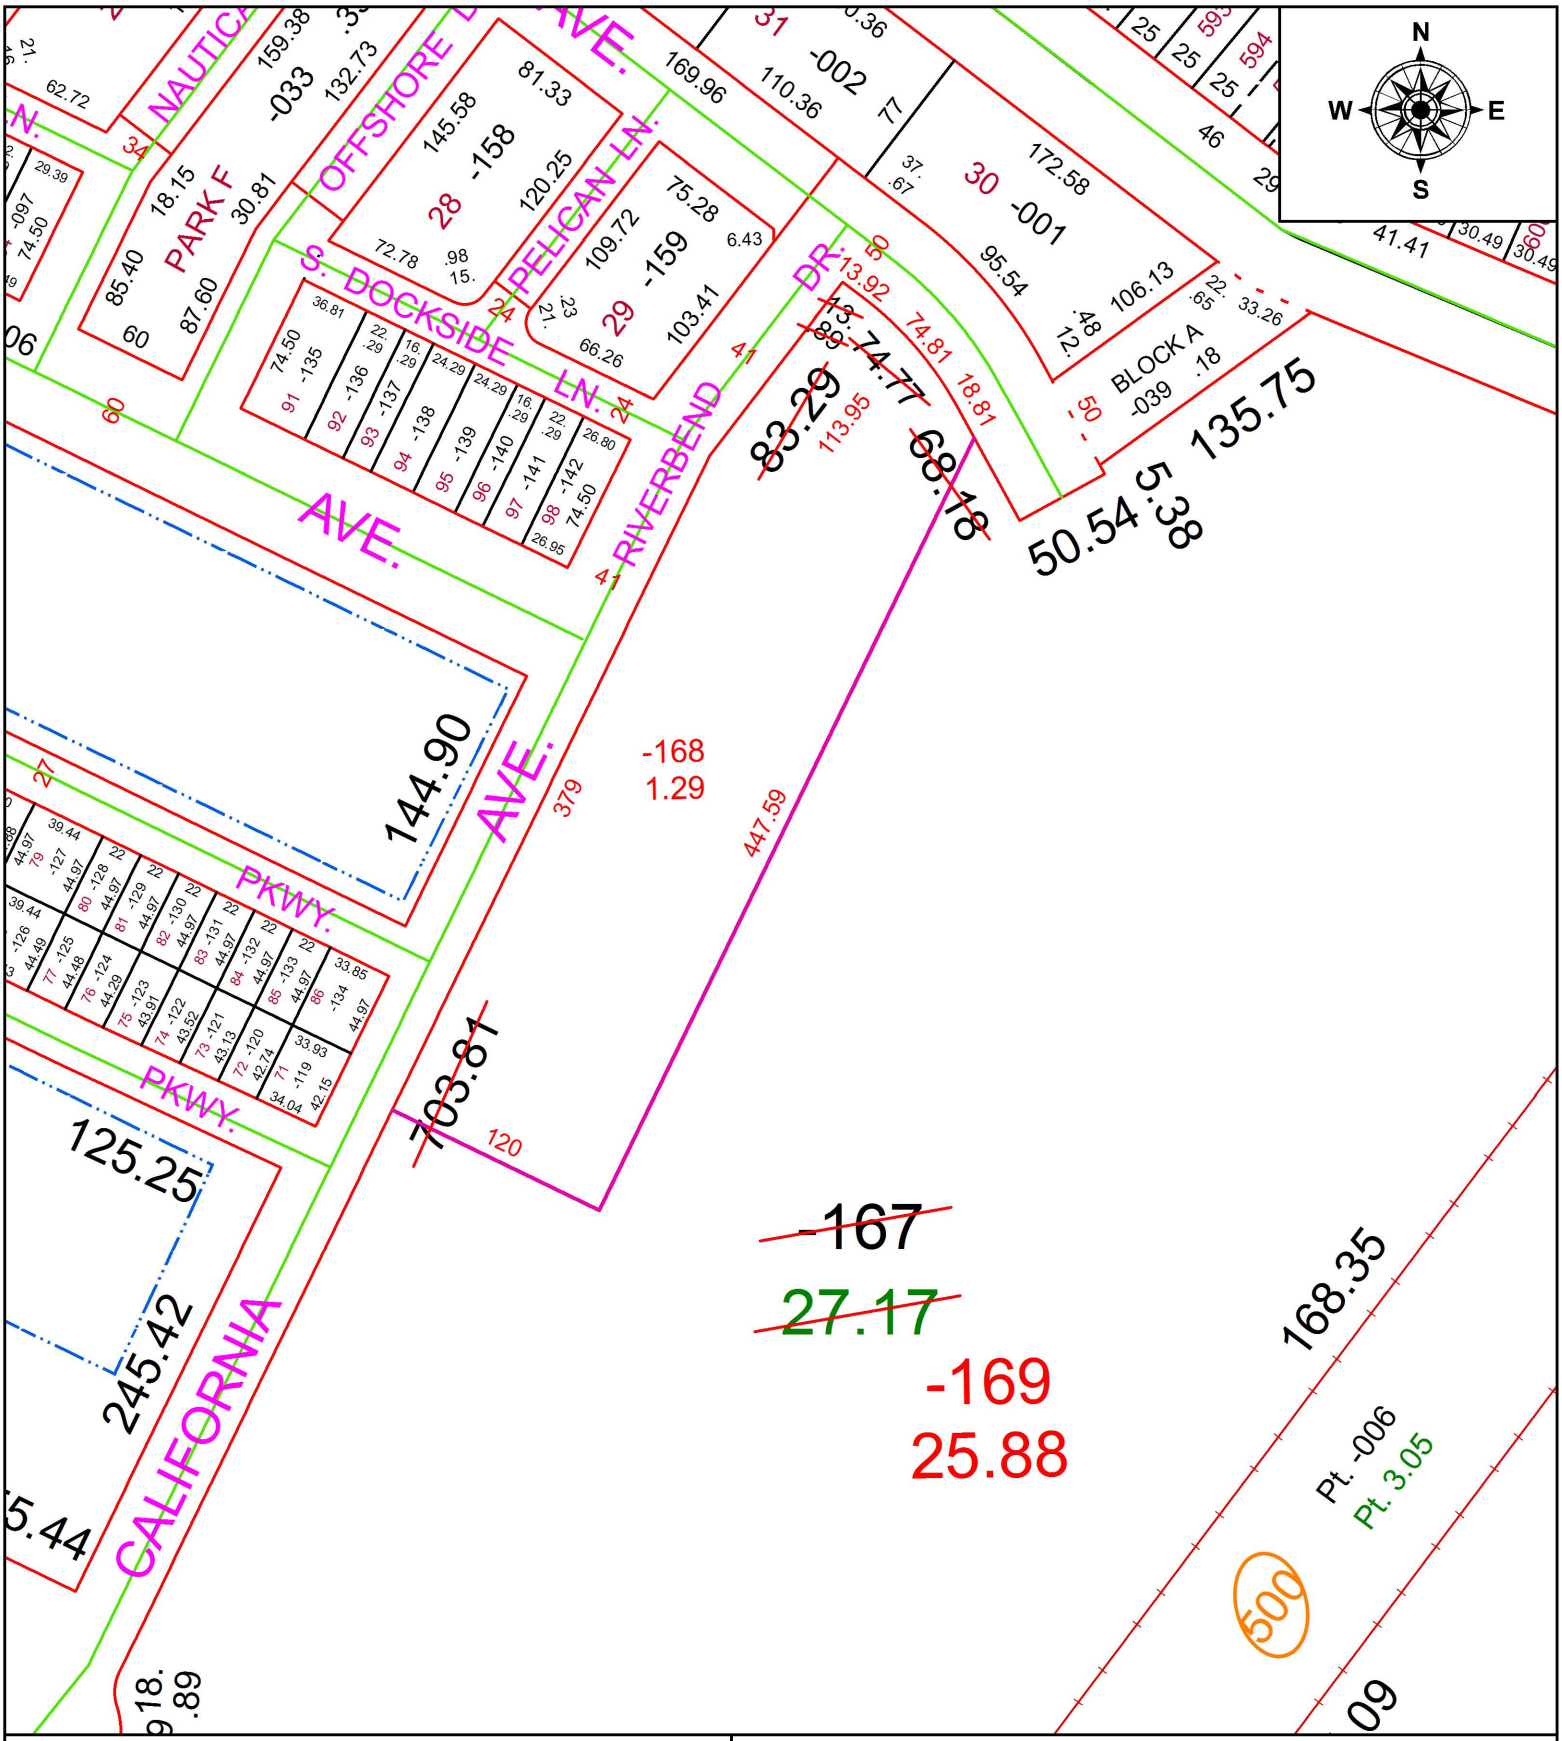

SPLITS/DEEDS PROCESSED

LORAIN COUNTY TAX MAP DEPARTMENT
226 MIDDLE AVE. ELYRIA, OH

SURVEYED BY: AMY M. KELLY
CLOSURE: 1: 150,247
MAP PAGE(S): 2-01-003
APPOVED BY: RRM **DATE:** 6-1-17
SCALE: 1" = 100 **PRIOR INSTRUMENT:** PV 67/28-30