PARENT PARCEL: 04-00-013-000-386, -489, -490, -559, 04-00-012-103-337

CHILD PARCEL: 04-00-013-000-585 THRU -589, 04-00-012-103-337

STARTING POINT: INTERSECTION OF C/L OF S.R. 83 AND C/L OF SOUTH PARK DR.

17-03676

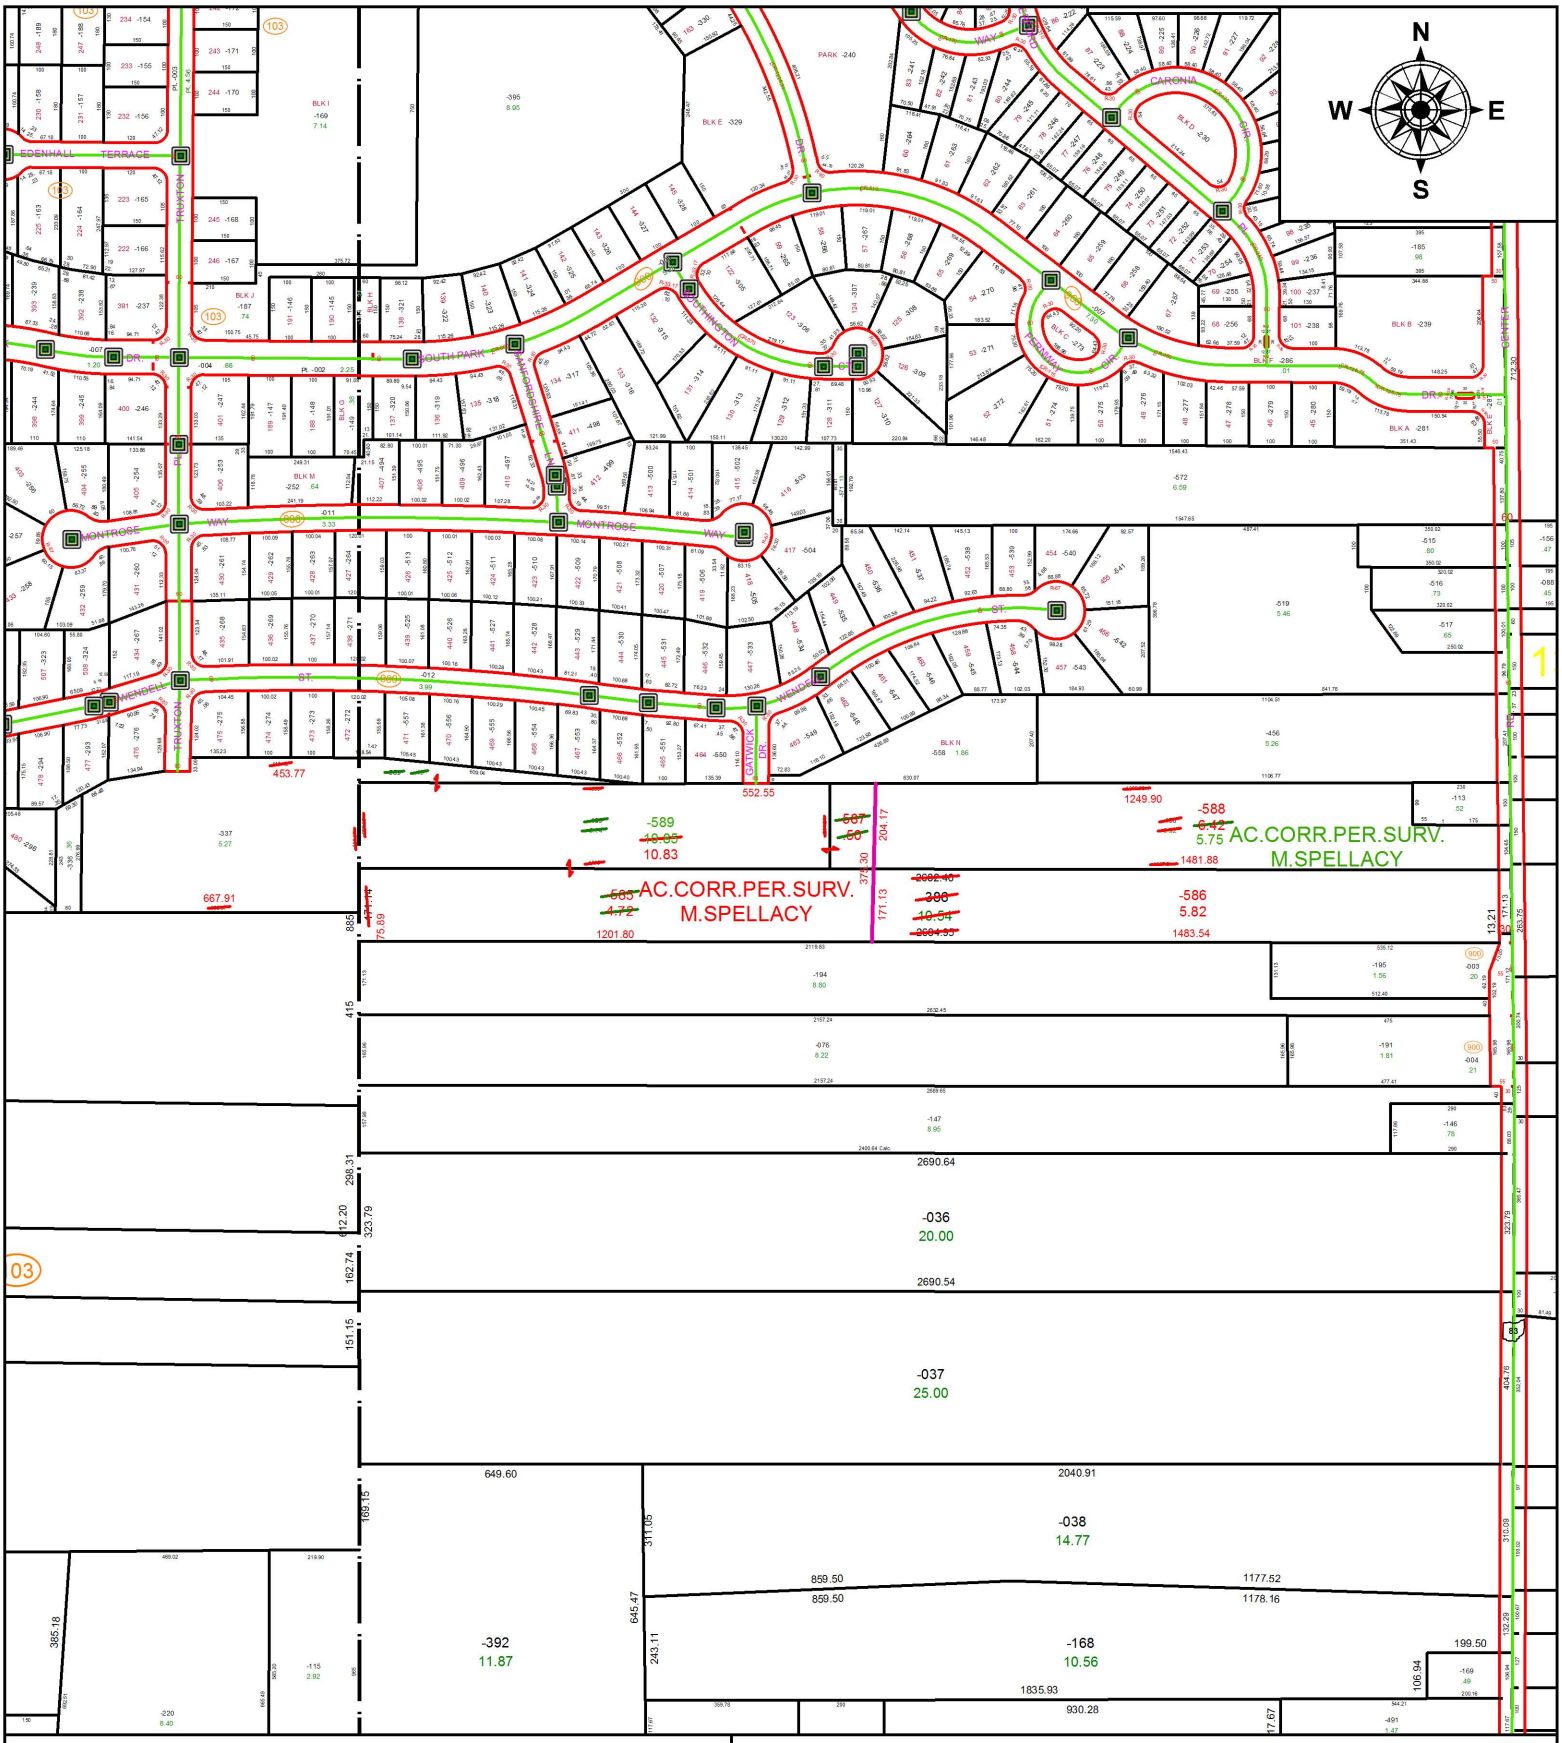

SPLITS/DEEDS PROCESSED

LORAIN COUNTY TAX MAP DEPARTMENT
226 MIDDLE AVE. ELYRIA, OH

SURVEYED BY: MICHAEL P. SPELLACY
CLOSURE: 1: 863,071
MAP PAGE(S): 4-00-013
APPOVED BY: RRM **DATE:** 6-12-17
SCALE: 1" = 450 **PRIOR INSTRUMENT:** 20150548574