PARENT PARCEL: 18-00-004-000-001

CHILD PARCEL: XX-XX-XXX-XXX-XXX

STARTING POINT: SOUTHWEST CORNER OF O.L.4

17-03678-X

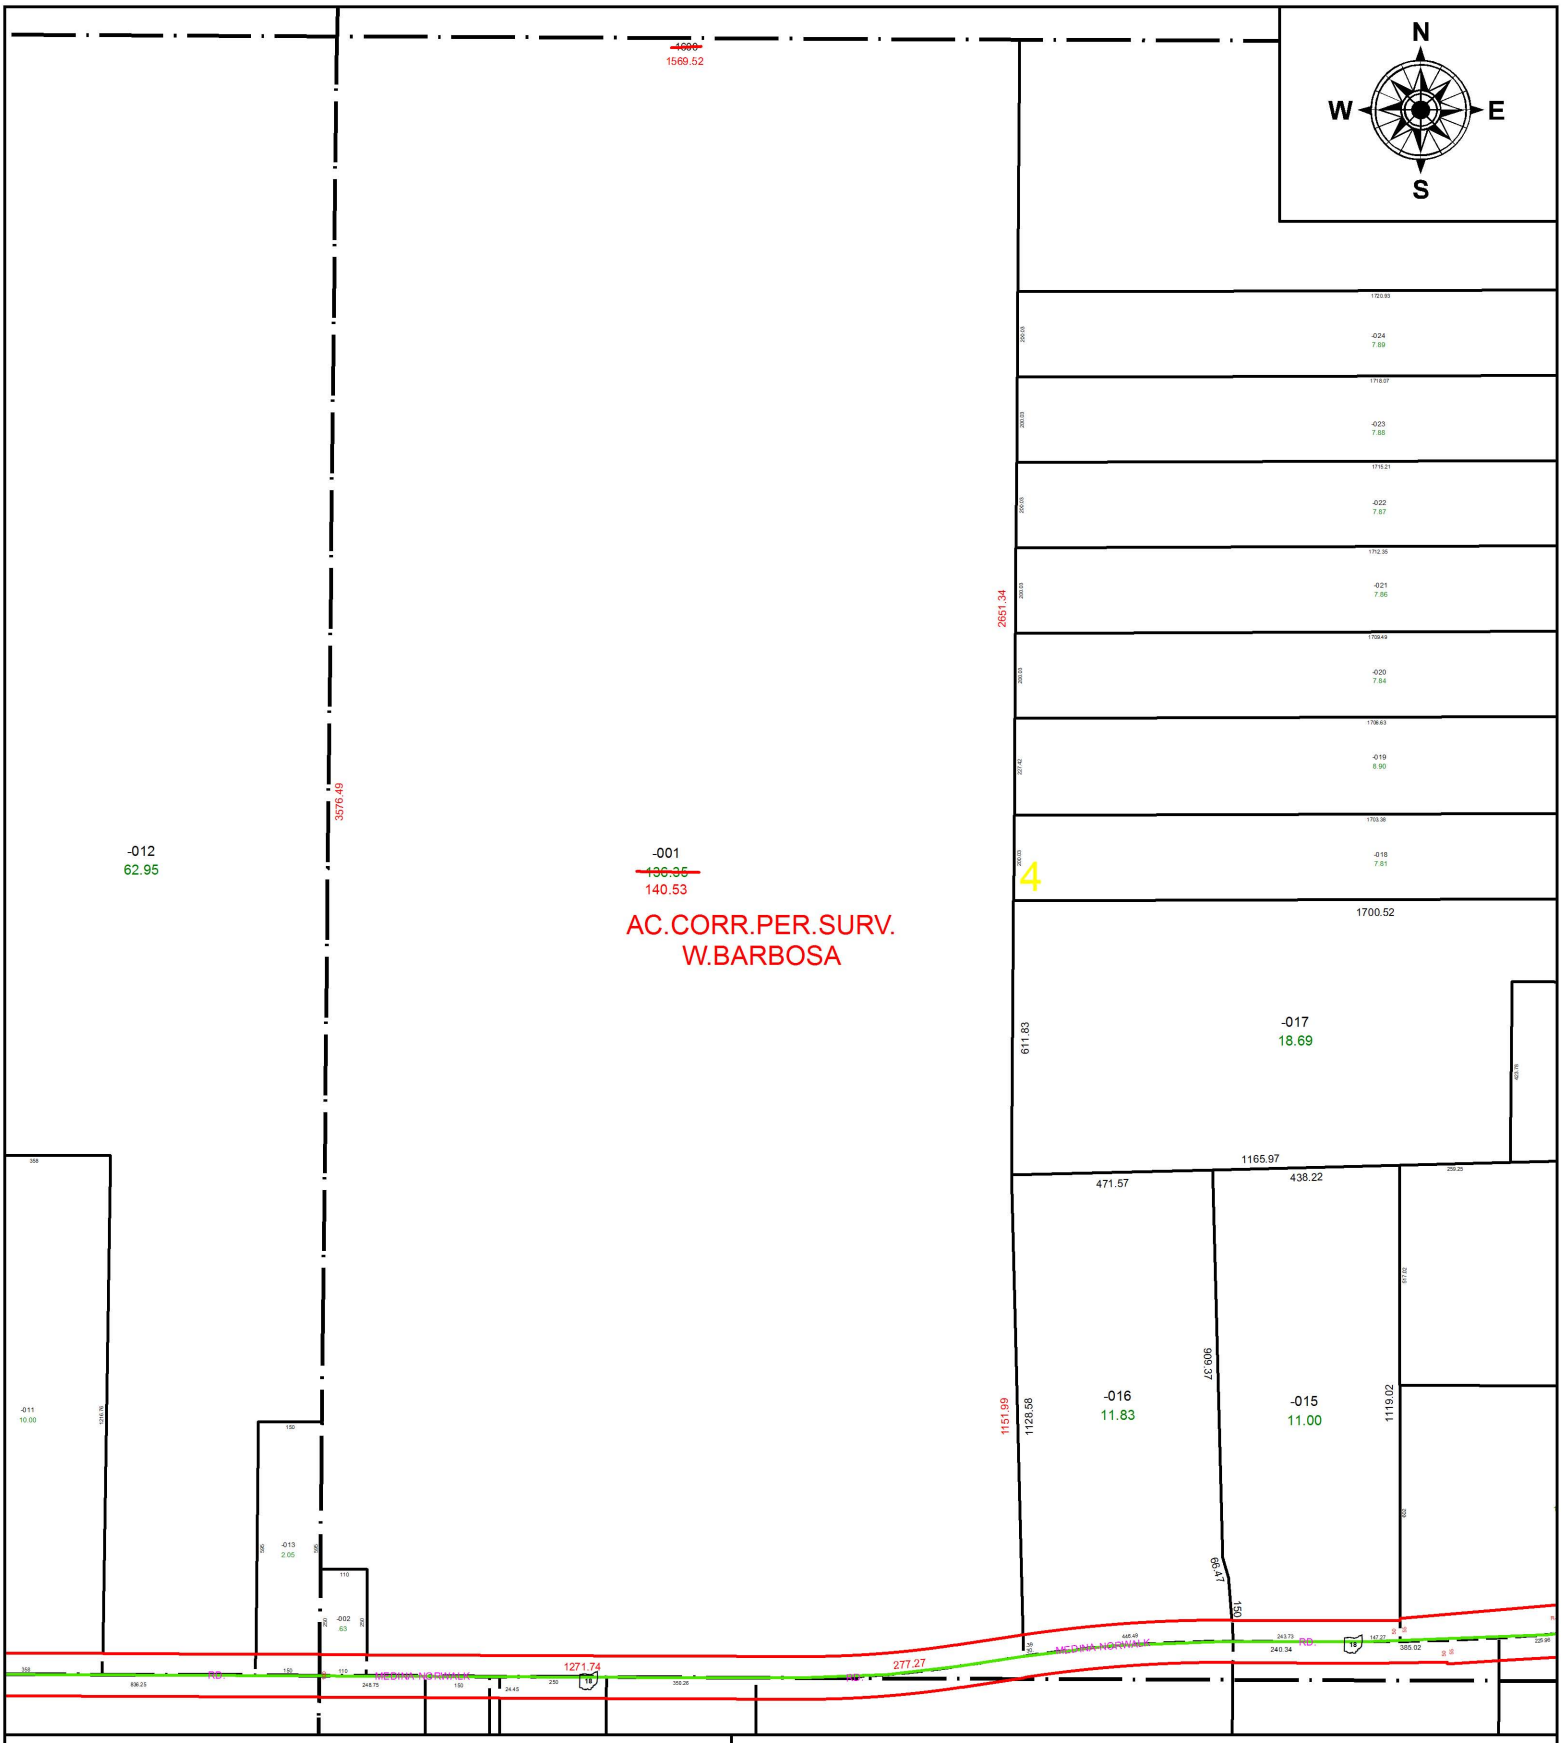

SPLITS/DEEDS PROCESSED

LORAIN COUNTY TAX MAP DEPARTMENT
226 MIDDLE AVE. ELYRIA, OH

SURVEYED BY: WILFREDO BARBOSA

CLOSURE: 1: 1,630,794

MAP PAGE(S): 18-D

APPOVED BY: RRM **DATE:** 5-22-17

SCALE: 1" = 450 **PRIOR INSTRUMENT:** 20160590985