PARENT PARCEL: 11-00-016-000-003, -055, -057, -082

CHILD PARCEL: XX-XX-XXX-XXX-XXX

STARTING POINT: INTERSECTION OF C/L OF S.R.82 AND C/L OF REED RD.

17-03680-D

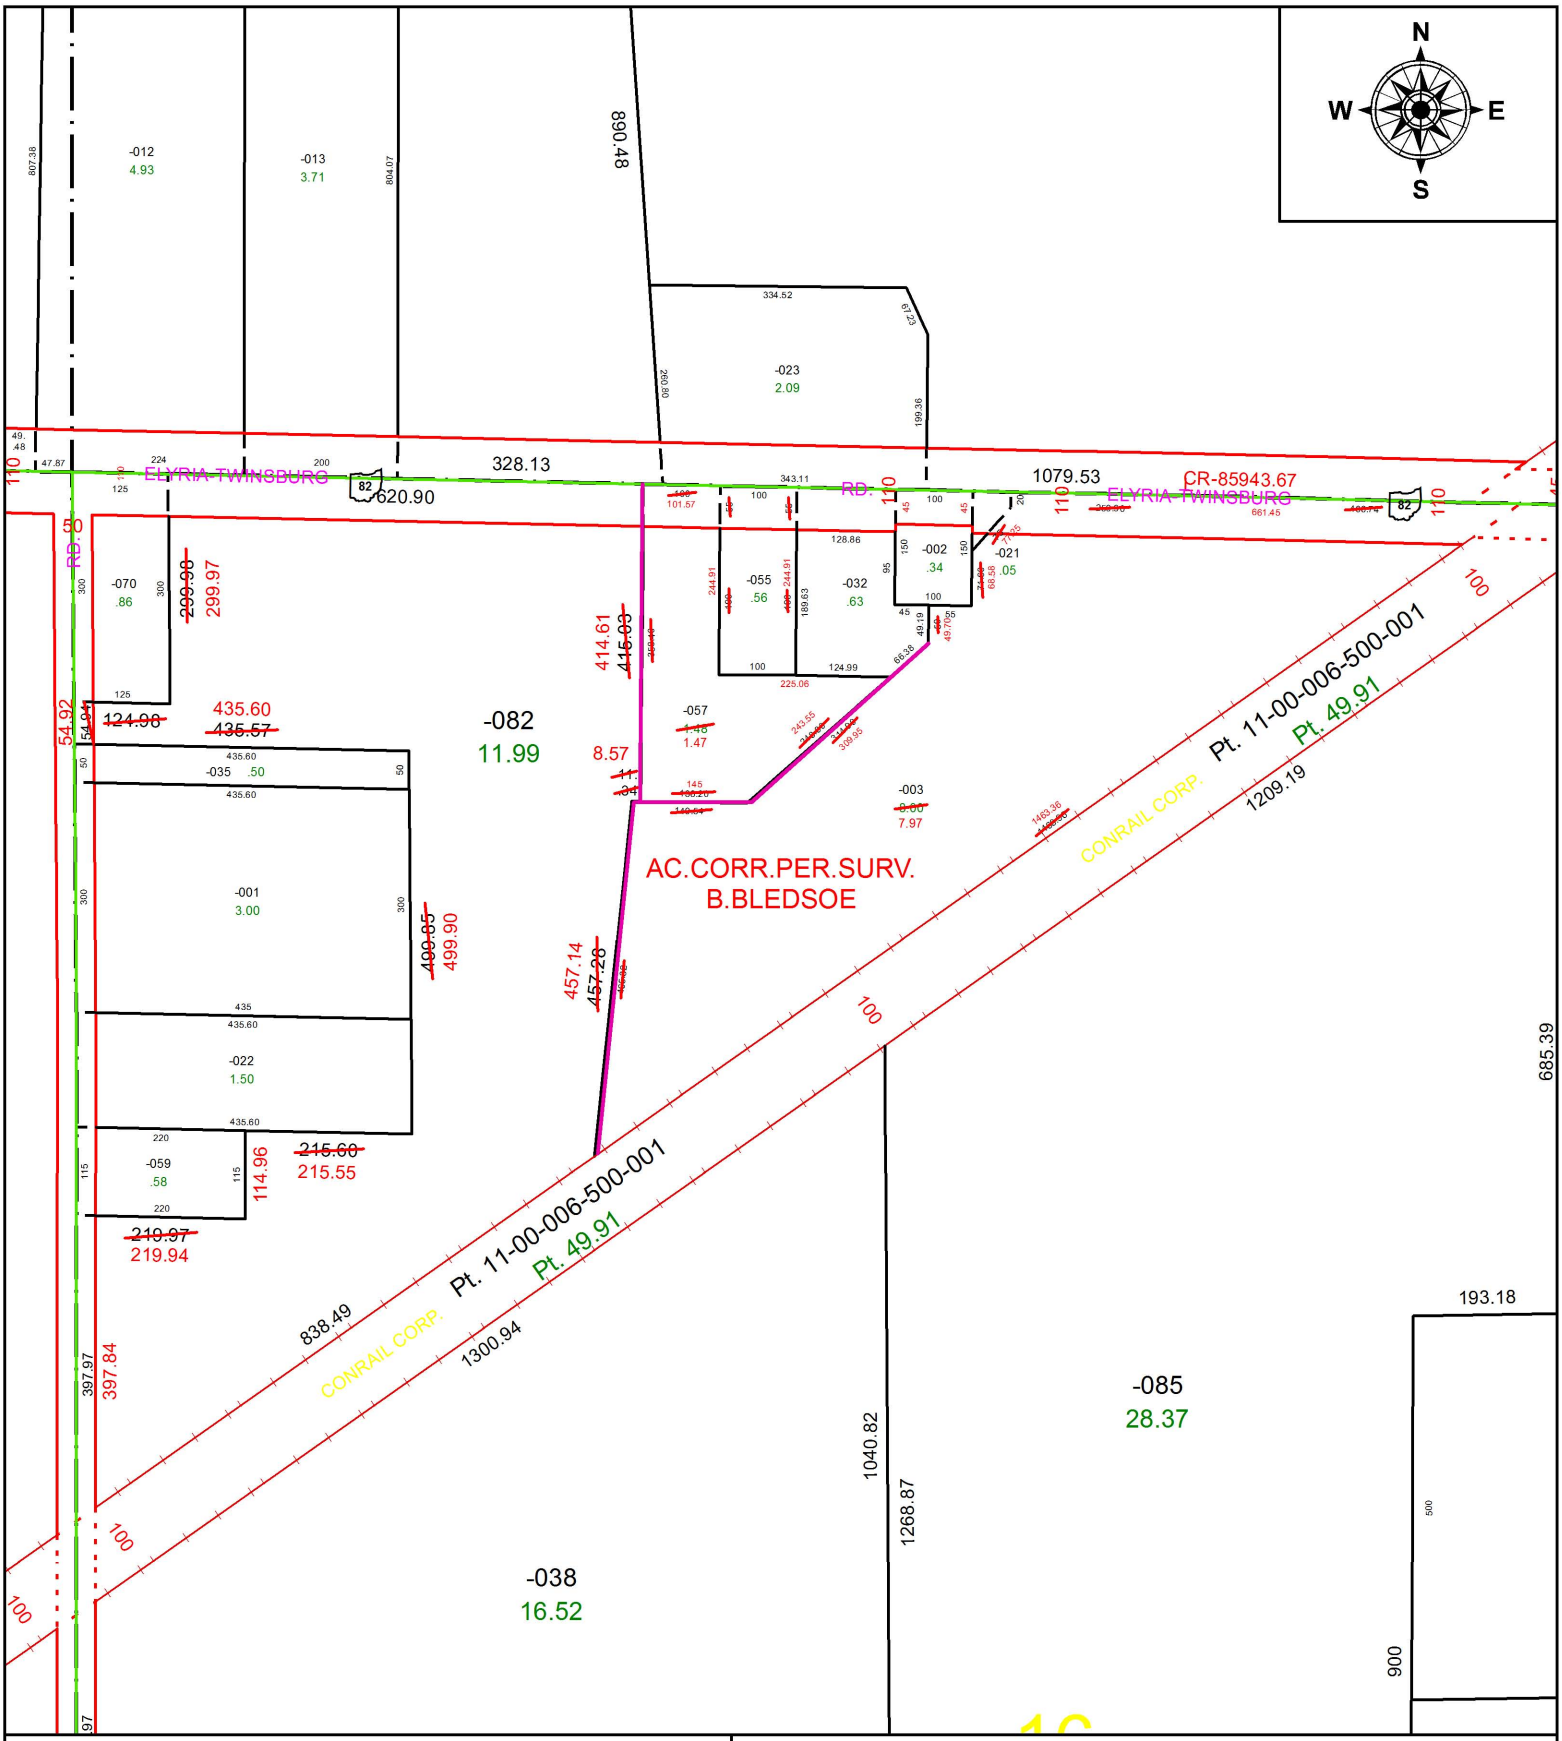

SPLITS/DEEDS PROCESSED

LORAIN COUNTY TAX MAP DEPARTMENT
226 MIDDLE AVE. ELYRIA, OH

SURVEYED BY: BEN BLEDSOE
CLOSURE: 1: 162,237
MAP PAGE(S): 11-00-016
APPOVED BY: RRM **DATE:** 5-24-17
SCALE: 1" = 250 **PRIOR INSTRUMENT:** 20120429308