PARENT PARCEL: 12-00-004-000-017, -018

CHILD PARCEL: 12-00-004-000-142

STARTING POINT: INTERSECTION OF C/L OF CLARKE RD. AND EAST LINE OF LORAIN COUNTY

17-03680

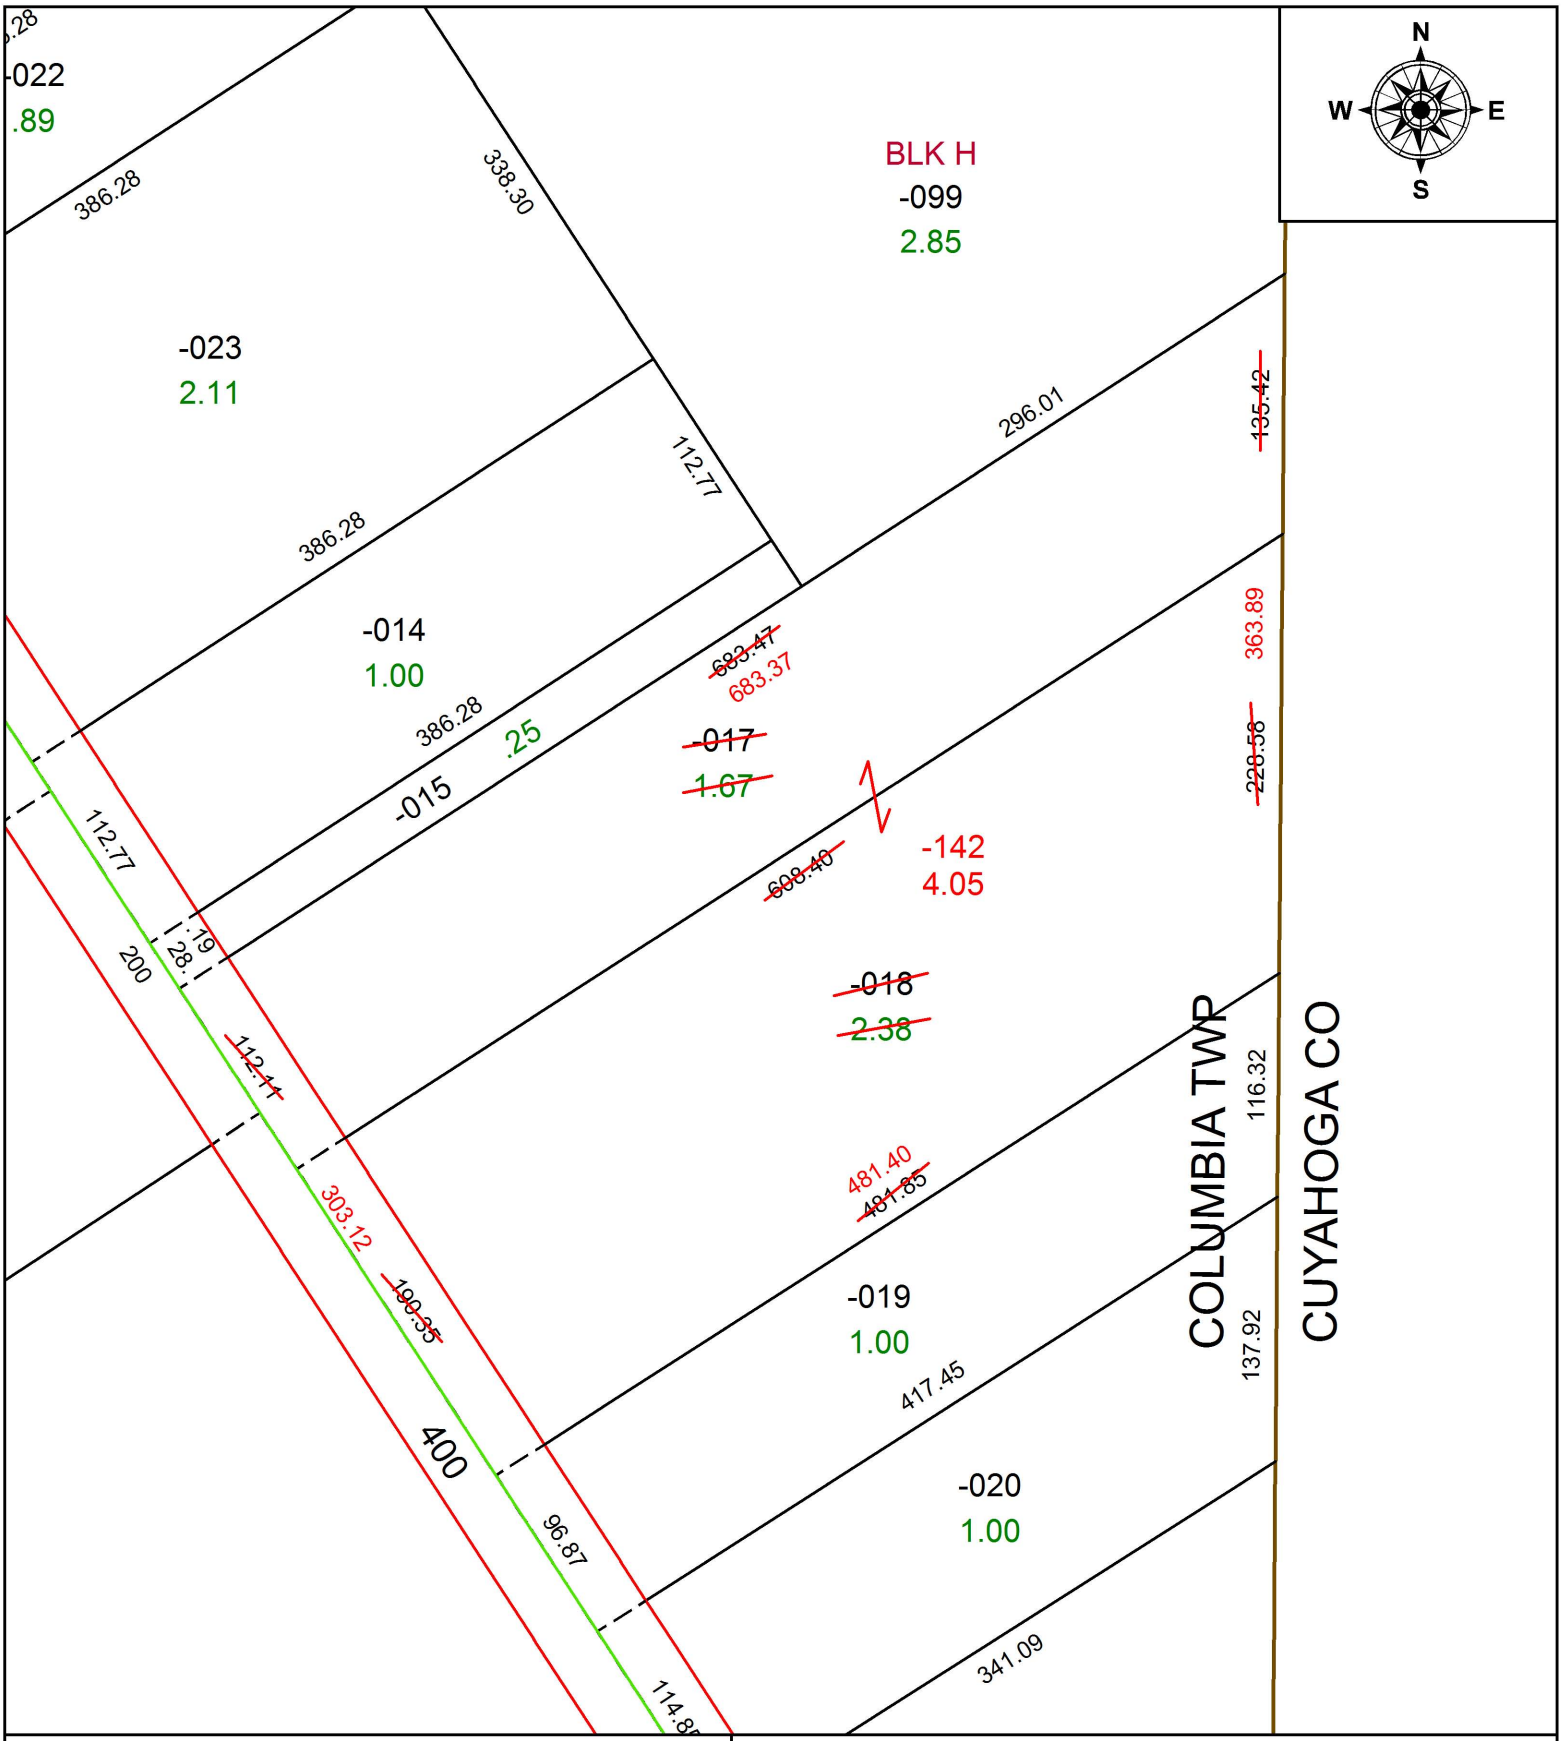

SPLITS/DEEDS PROCESSED

LORAIN COUNTY TAX MAP DEPARTMENT
226 MIDDLE AVE. ELYRIA, OH

SURVEYED BY: STAN R. LOCH
CLOSURE: 1: 298,597
MAP PAGE(S): 12-00-004
APPOVED BY: RRM **DATE:** 6-21-17
SCALE: 1" = 100 **PRIOR INSTRUMENT:** 20170619350