PARENT PARCEL: 03-00-097-101-027, 03-00-098-112-005

CHILD PARCEL: 03-00-097-101-032, -033, .03-00-098-112-006, -007

STARTING POINT: INTERSECTION OF WEST LINE OF FULTON RD. AND SOUTH LINE OF E.28TH ST.

17-03681

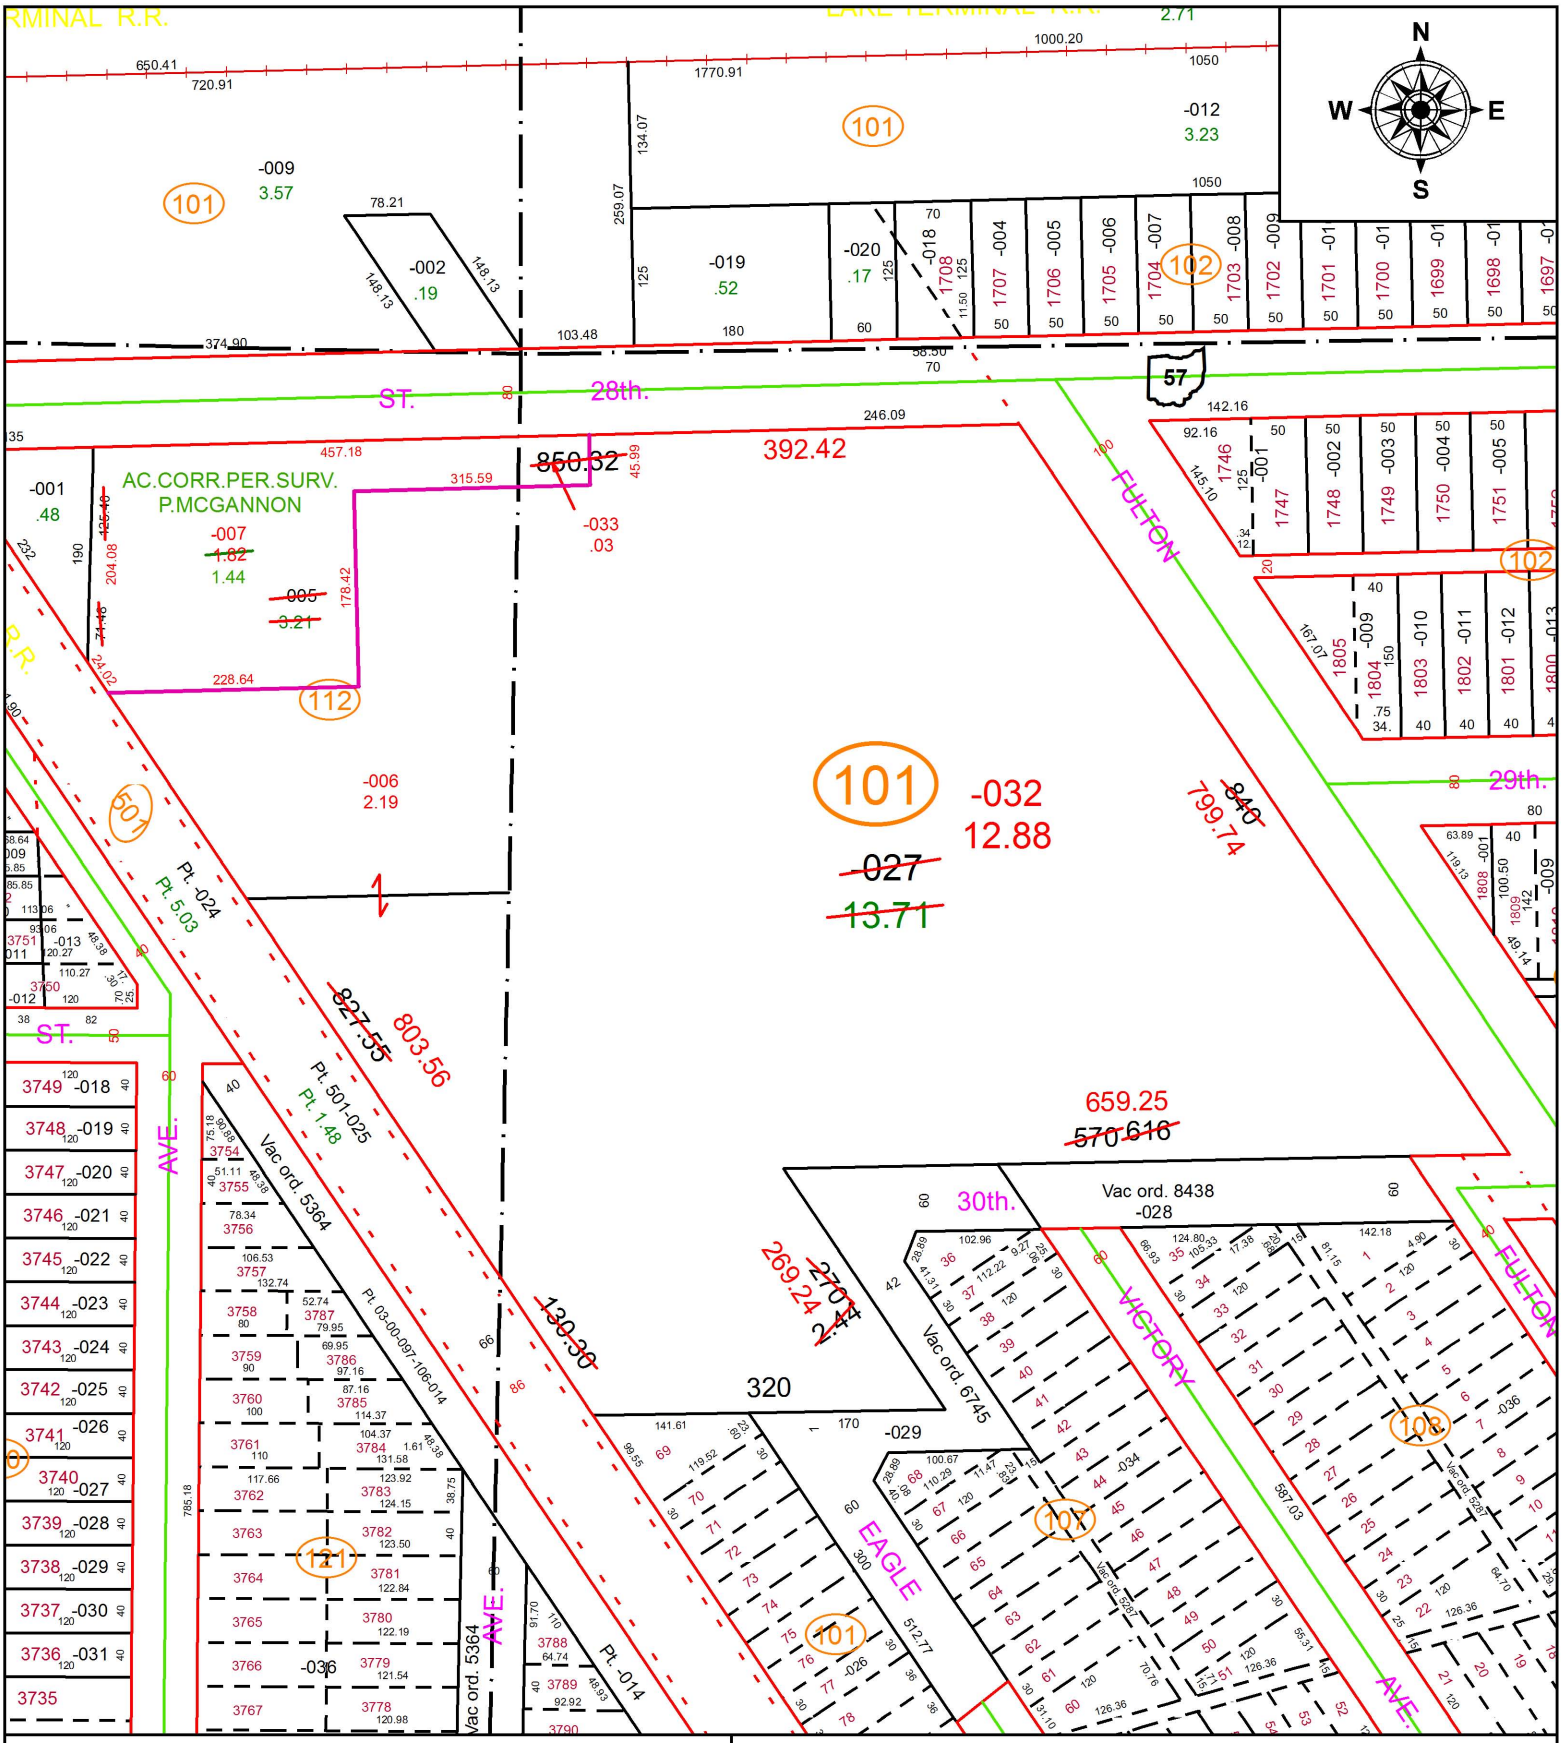

SPLITS/DEEDS PROCESSED

LORAIN COUNTY TAX MAP DEPARTMENT
226 MIDDLE AVE. ELYRIA, OH

SURVEYED BY: PATRICK A. MCGANNON
CLOSURE: 1: 169,384
MAP PAGE(S): 3-00-097
APPOVED BY: RRM **DATE:** 6-22-17
SCALE: 1" = 175 **PRIOR INSTRUMENT:** DV 1225 PG 229