PARENT PARCEL: 11-00-072-000-015

CHILD PARCEL: 11-00-072-000-084, -085, 11-00-073-000-041

STARTING POINT: INTERSECTION OF C/L OF BUTTERNUT RIDGE RD. AND C/L OF DURKEE RD.

17-03683

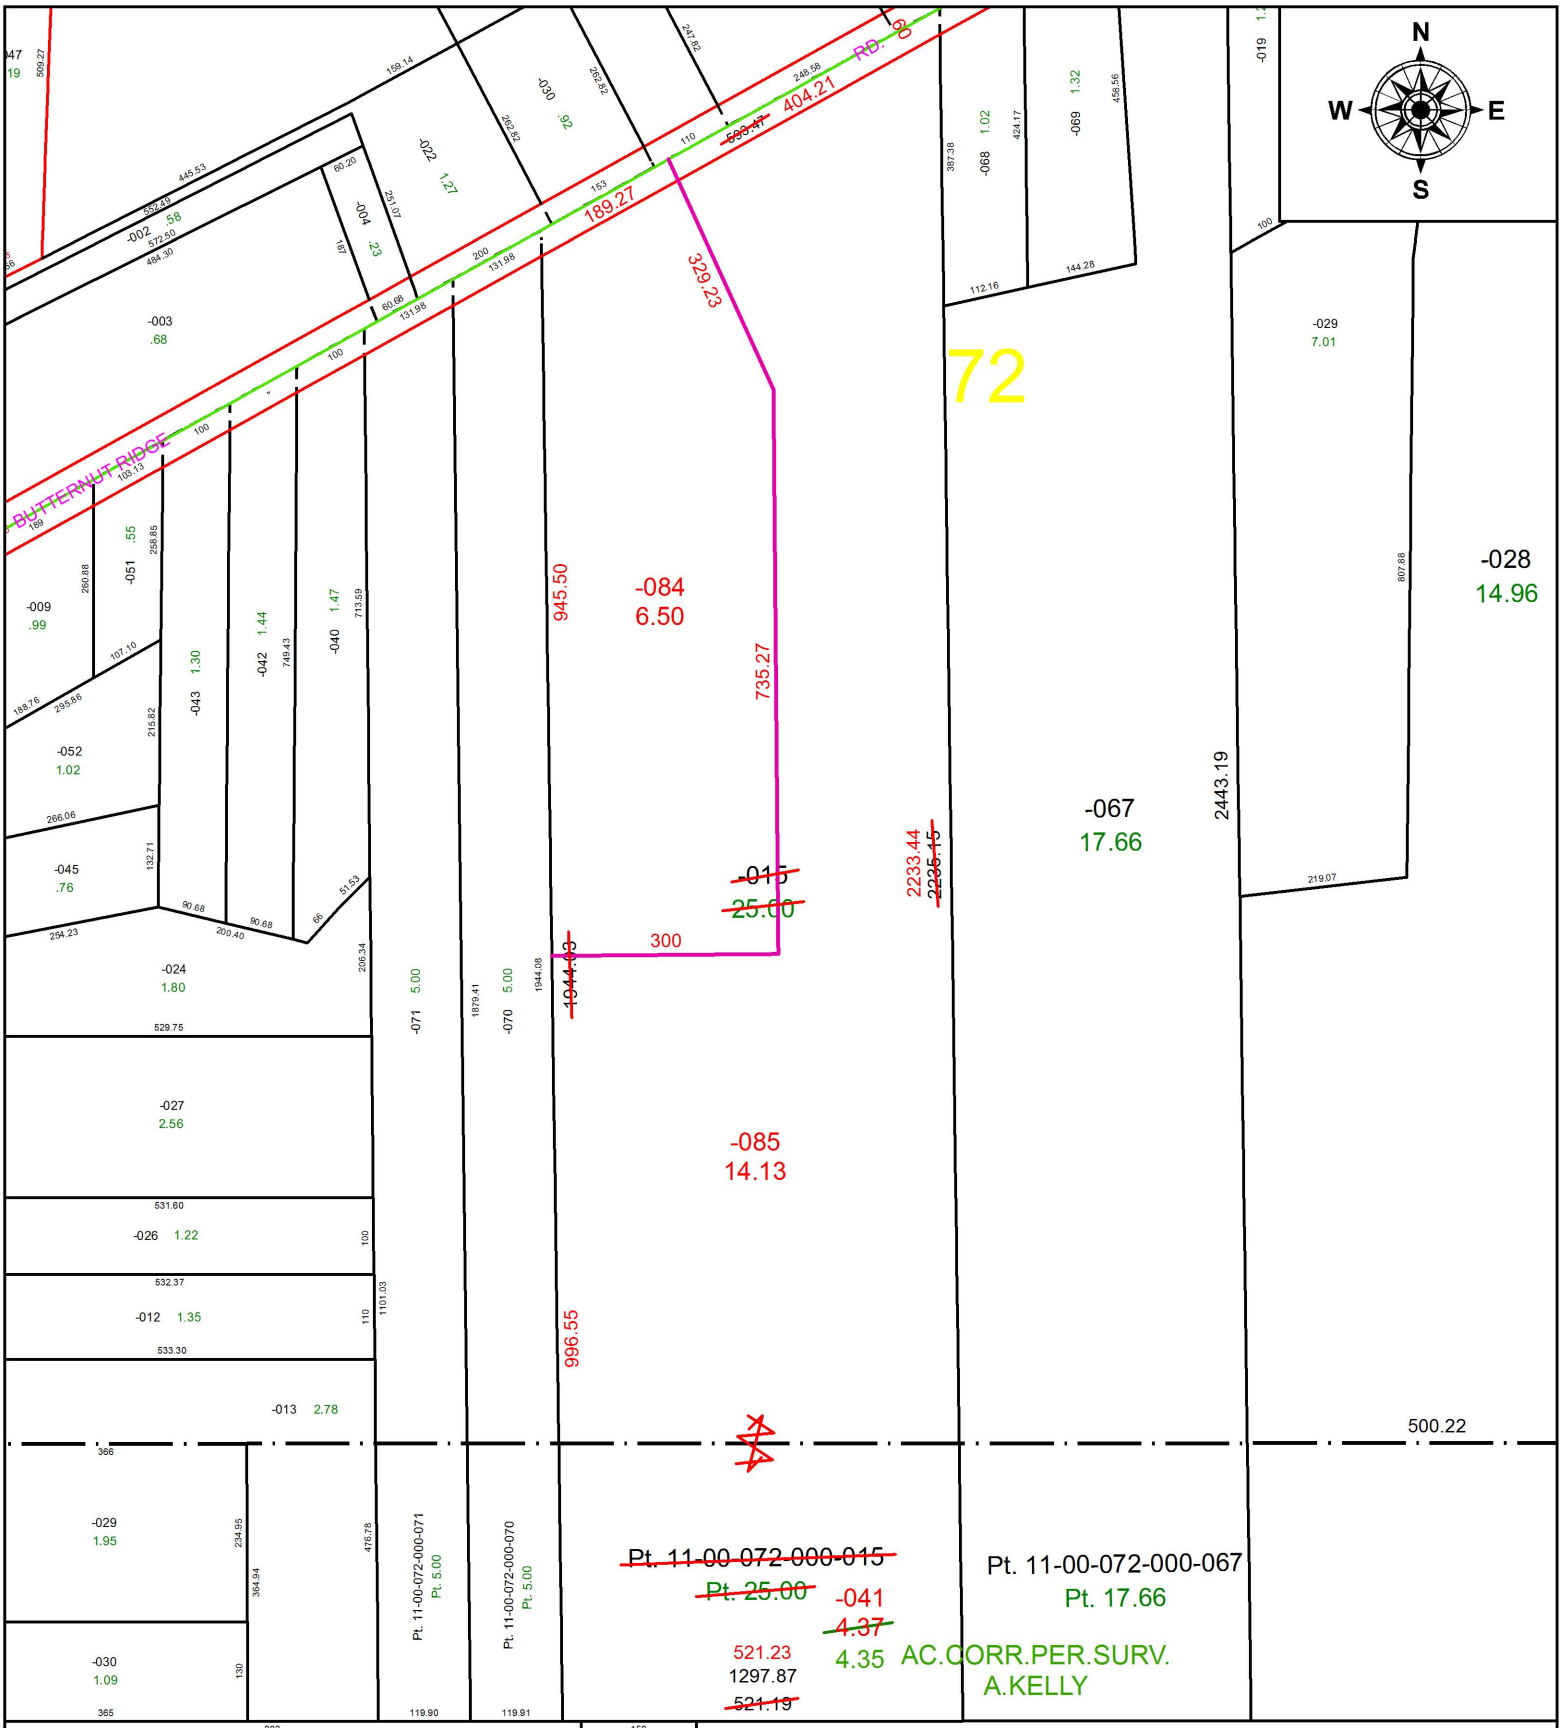

SPLITS/DEEDS PROCESSED

LORAIN COUNTY TAX MAP DEPARTMENT
226 MIDDLE AVE. ELYRIA, OH

SURVEYED BY: AMY M. KELLY
CLOSURE: 1: 619,618
MAP PAGE(S): 11-00-072
APPOVED BY: RRM **DATE:** 3-23-17
SCALE: 1" = 250 **PRIOR INSTRUMENT:** DV 1107 PG.84