**PARENT PARCEL:** 01-00-043-000-003,01-00-044-000-009

**CHILD PARCEL:** XX-XX-XXX-XXX-XXX

**STARTING POINT:** INTERSECTION OF C/L OF CLAUS RD. AND C/L OF NORTH RIDGE RD.

# 17-03686-X

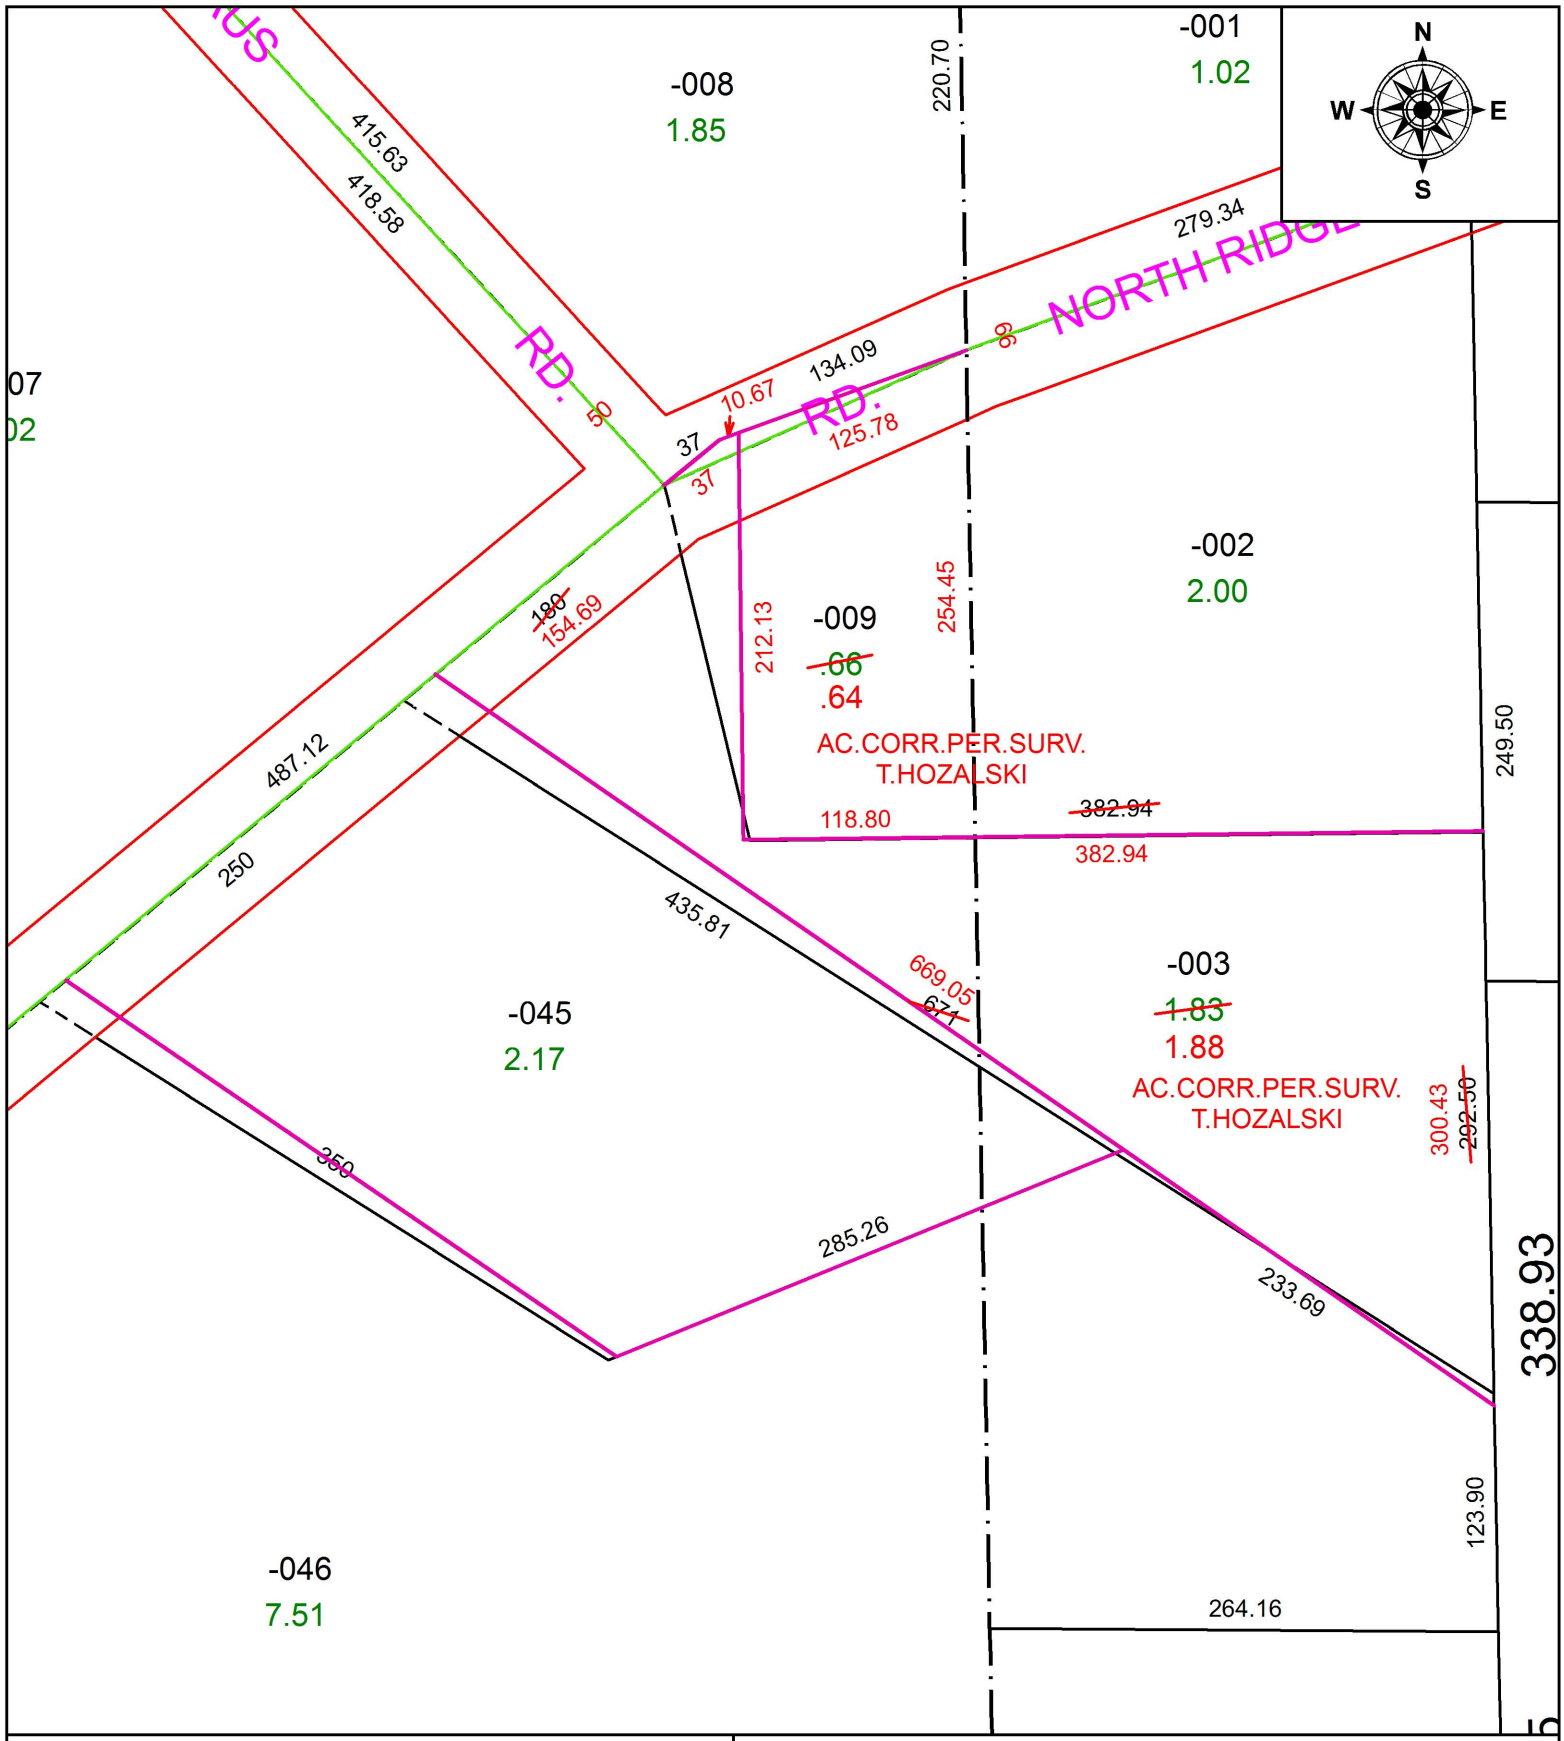


**SPLITS/DEEDS PROCESSED**

LORAIN COUNTY TAX MAP DEPARTMENT
226 MIDDLE AVE. ELYRIA, OH

**SURVEYED BY:** TIMOTHY D. HOZALSKI
**CLOSURE:** 1: 268,060
**MAP PAGE(S):** 1-00-043
**APPOVED BY:** RRM **DATE:** 6-5-17
**SCALE:** 1" = 100 **PRIOR INSTRUMENT:** OR 184/766