PARENT PARCEL: 04-00-011-107-055, -168, -243
CHILD PARCEL: 04-00-011-107-245 THRU -248
STARTING POINT: INTERSECTION OF C/L OF DETROIT RD. AND C/L OF LONG RD.

17-03689

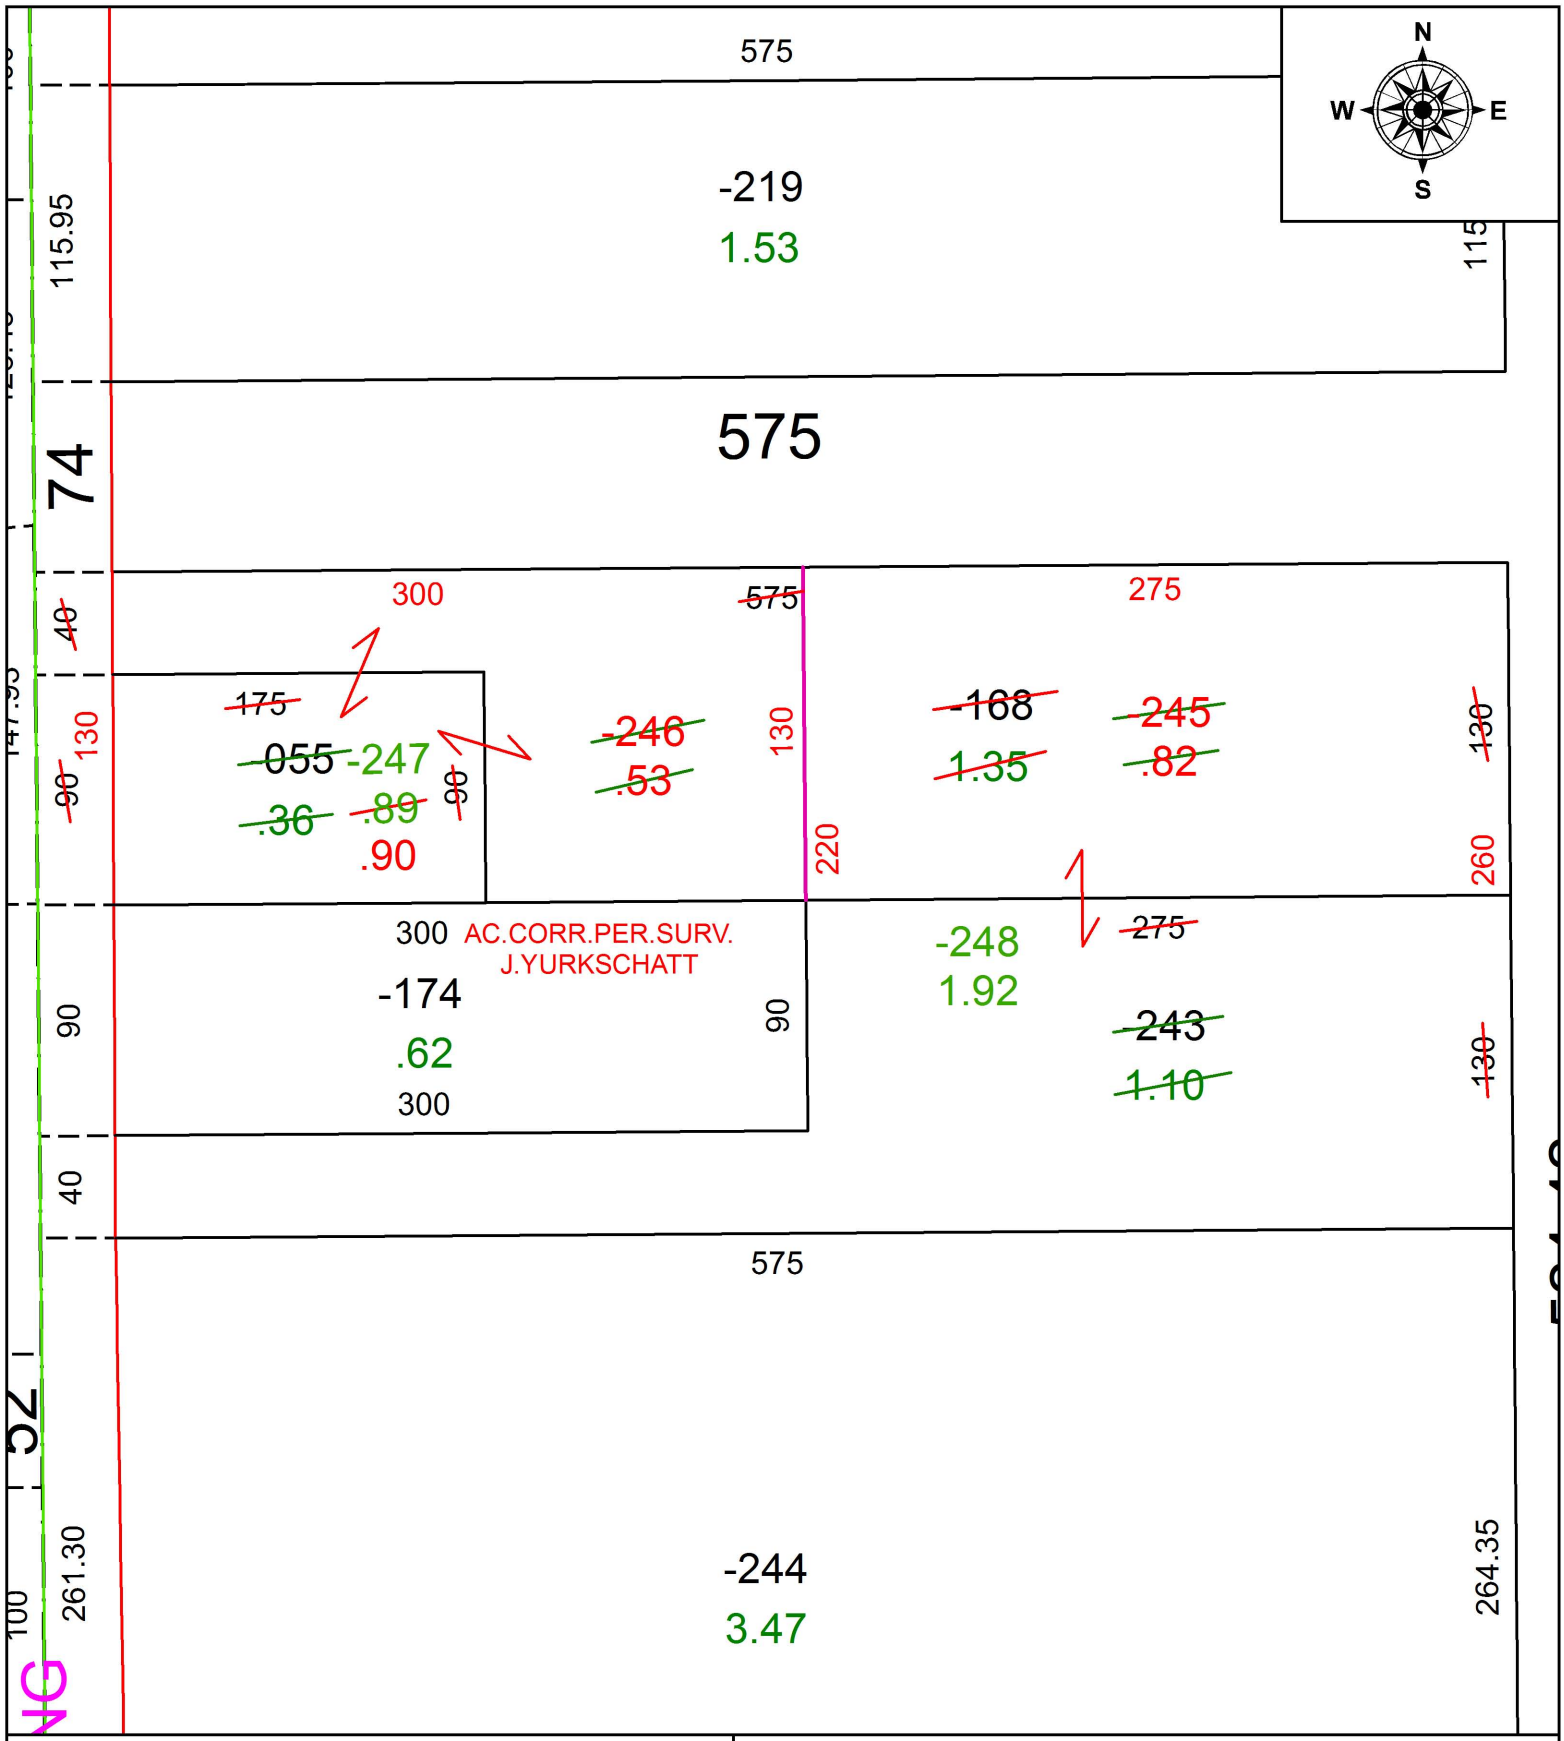

SPLITS/DEEDS PROCESSED
LORAIN COUNTY TAX MAP DEPARTMENT
226 MIDDLE AVE. ELYRIA, OH

SURVEYED BY: JAMES P. YURKSCHATT
CLOSURE: 1: 2147483648
MAP PAGE(S): 4-00-011
APPOVED BY: RRM **DATE:** 7-11-17
SCALE: 1" = 75 **PRIOR INSTRUMENT:** 19980512038