PARENT PARCEL: 10-00-023-102-002, -067
CHILD PARCEL: 10-00-023-102-069 THRU -073
STARTING POINT: INTERSECTION OF C/L OF S.R. 301 AND C/L OF BANKS RD.

17-03692

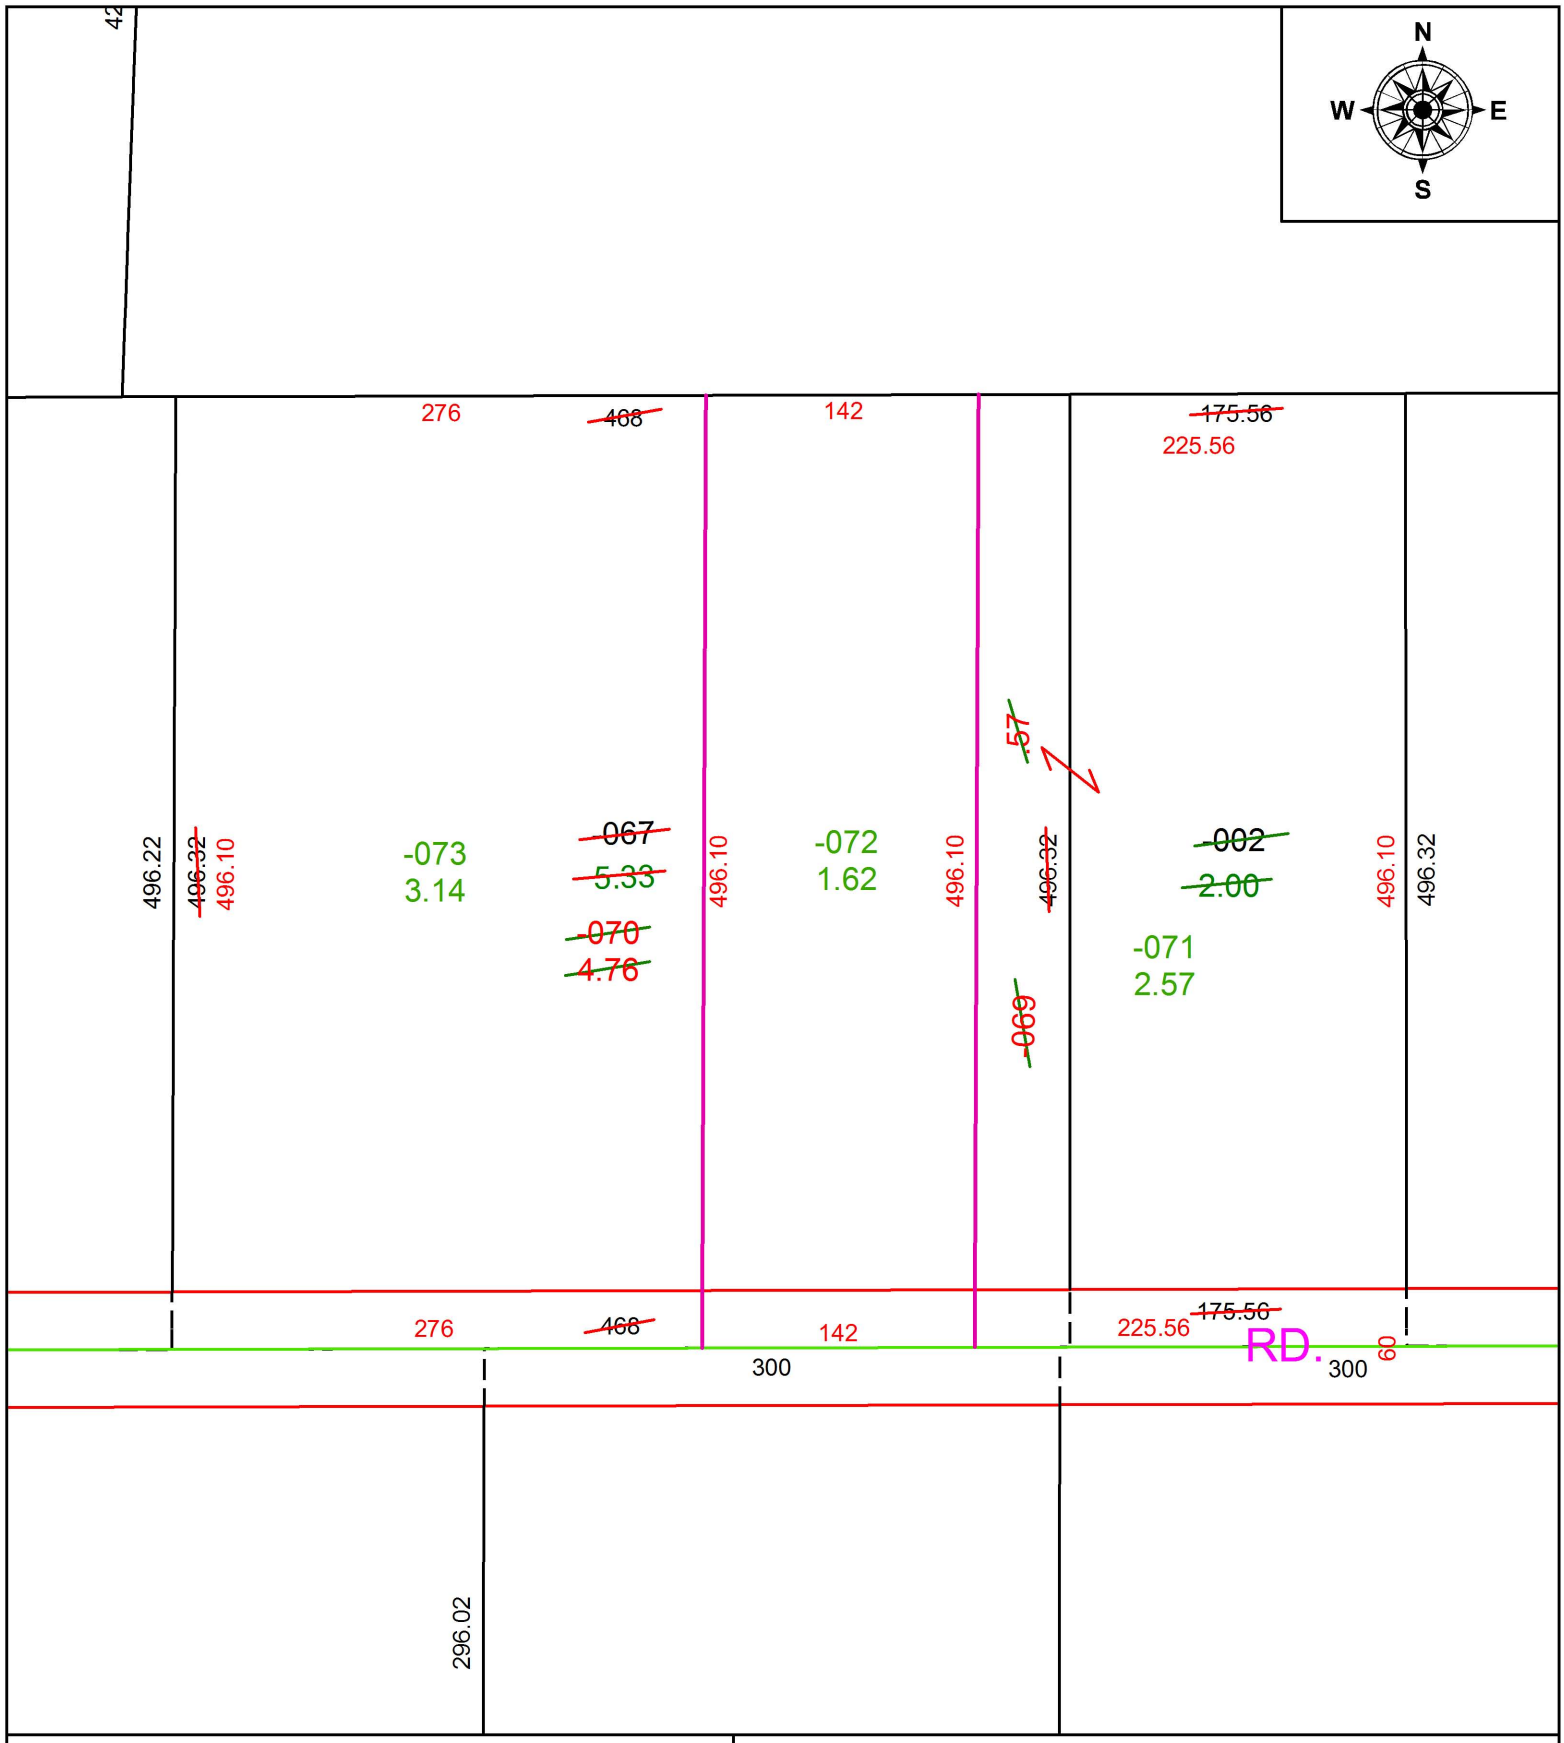

SPLITS/DEEDS PROCESSED
LORAIN COUNTY TAX MAP DEPARTMENT
226 MIDDLE AVE. ELYRIA, OH

SURVEYED BY: RICHARD D. CARLSON
CLOSURE: 1: 2147483648
MAP PAGE(S): 10-00-023
APPOVED BY: RRM **DATE:** 7-13-17
SCALE: 1" = 100 **PRIOR INSTRUMENT:** 20160577539