PARENT PARCEL: 04-00-029-000-891, -892

CHILD PARCEL: 04-00-029-000-936, -937

STARTING POINT: INTERSECTION OF C/L OF WOODBRIDGE WAY AND C/L OF WINNERS CIR.

17-03695

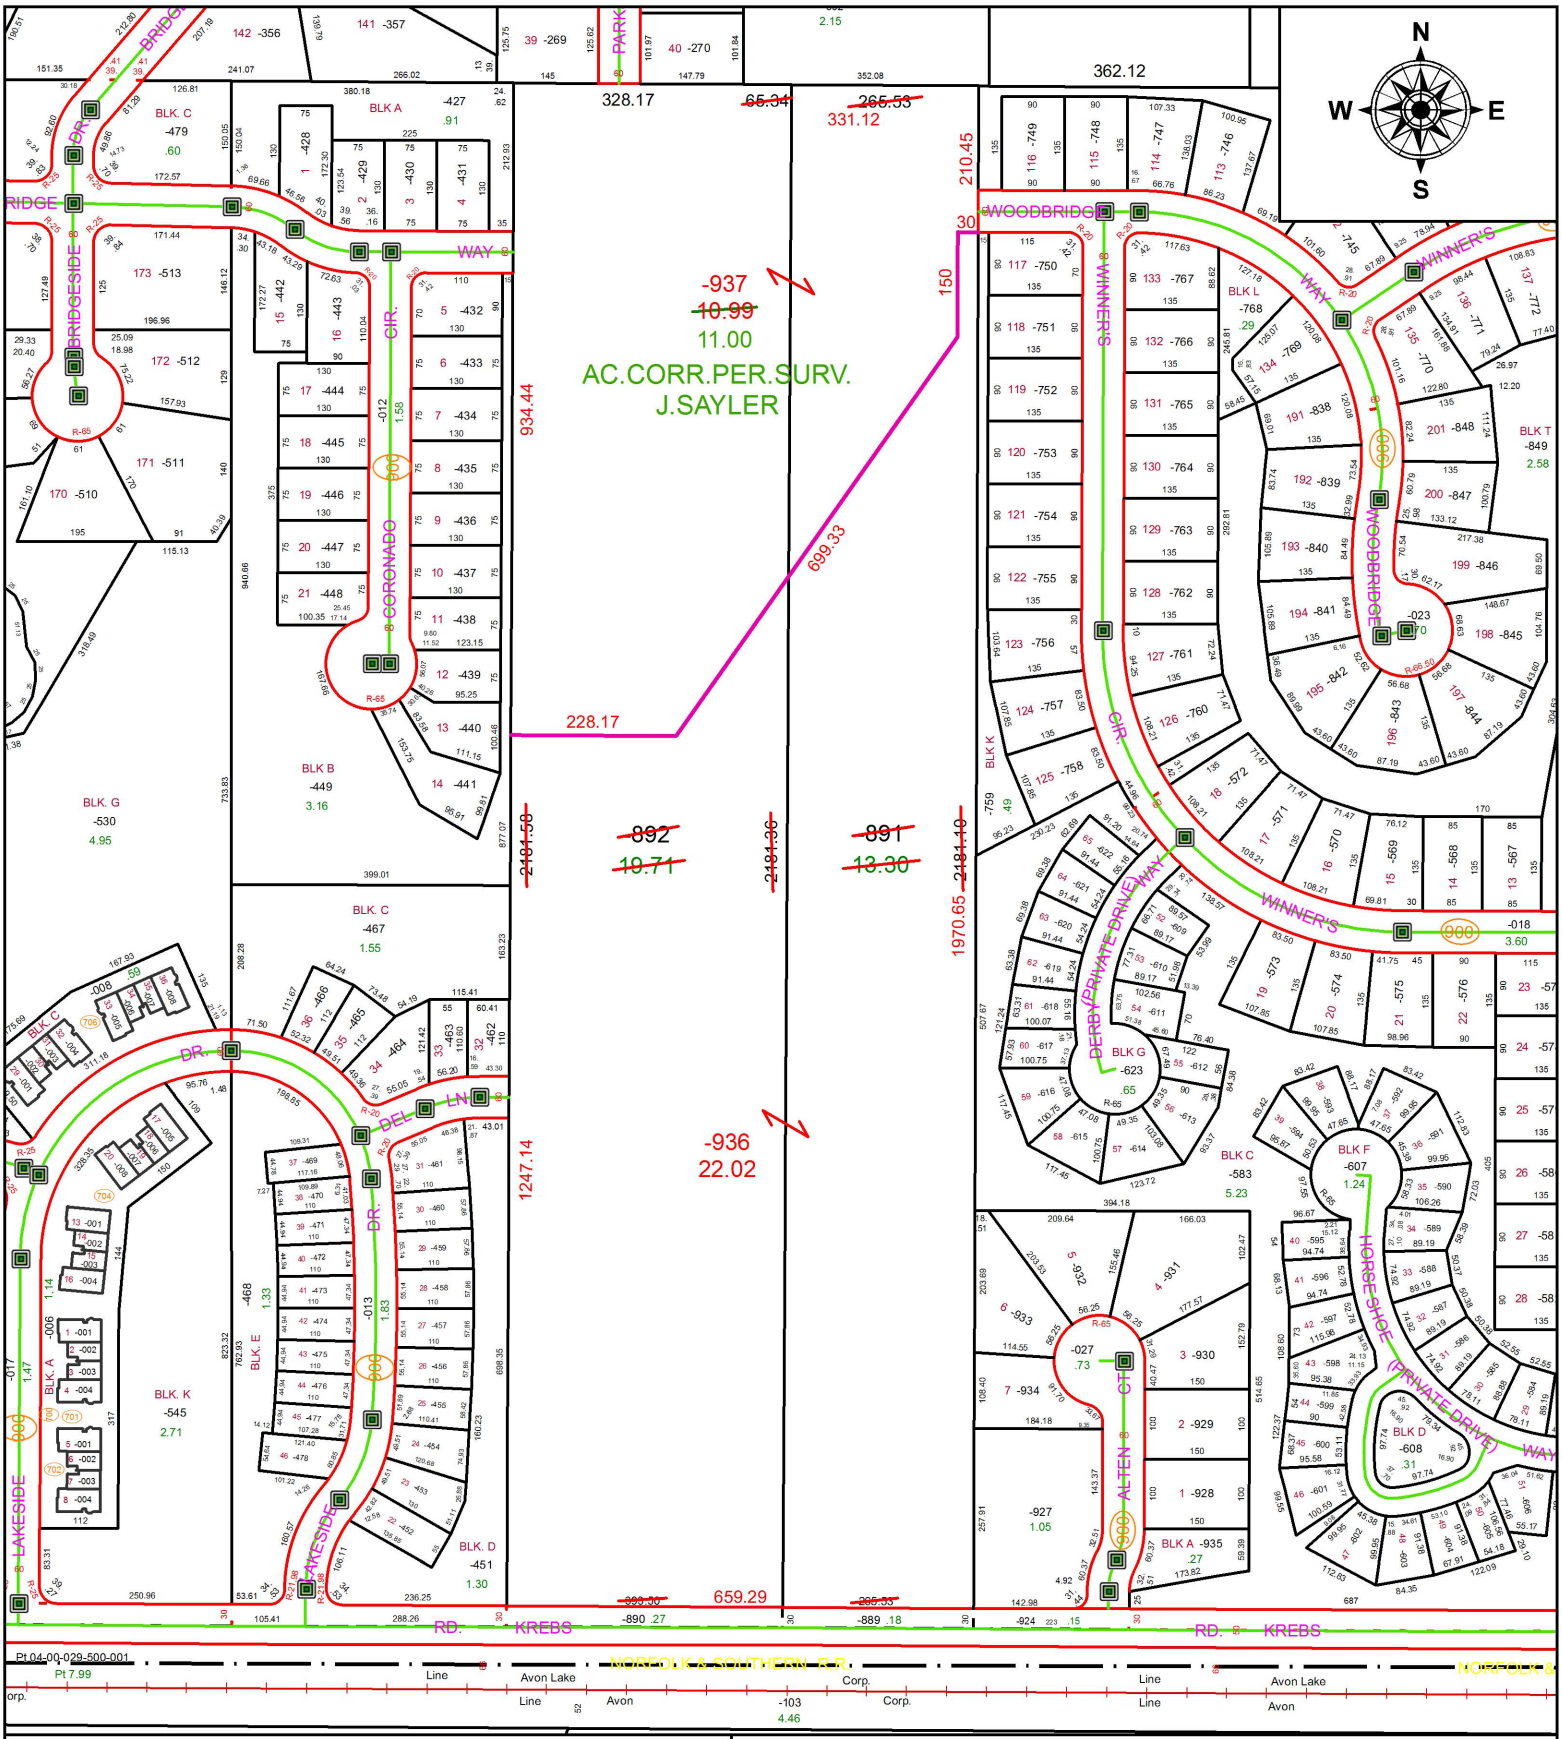

SPLITS/DEEDS PROCESSED

LORAIN COUNTY TAX MAP DEPARTMENT
226 MIDDLE AVE. ELYRIA, OH

SURVEYED BY: JAMES T. SAYLER
CLOSURE: 1: 737,432
MAP PAGE(S): 4-00-029
APPOVED BY: RRM **DATE:** 7-17-17
SCALE: 1" = 275 **PRIOR INSTRUMENT:** 20140509827