PARENT PARCEL: 04-00-027-103-002
CHILD PARCEL: XX-XX-XXX-XXX-XXX
STARTING POINT: SOUTHWEST CORNER OF SECTION 27

17-03698-C

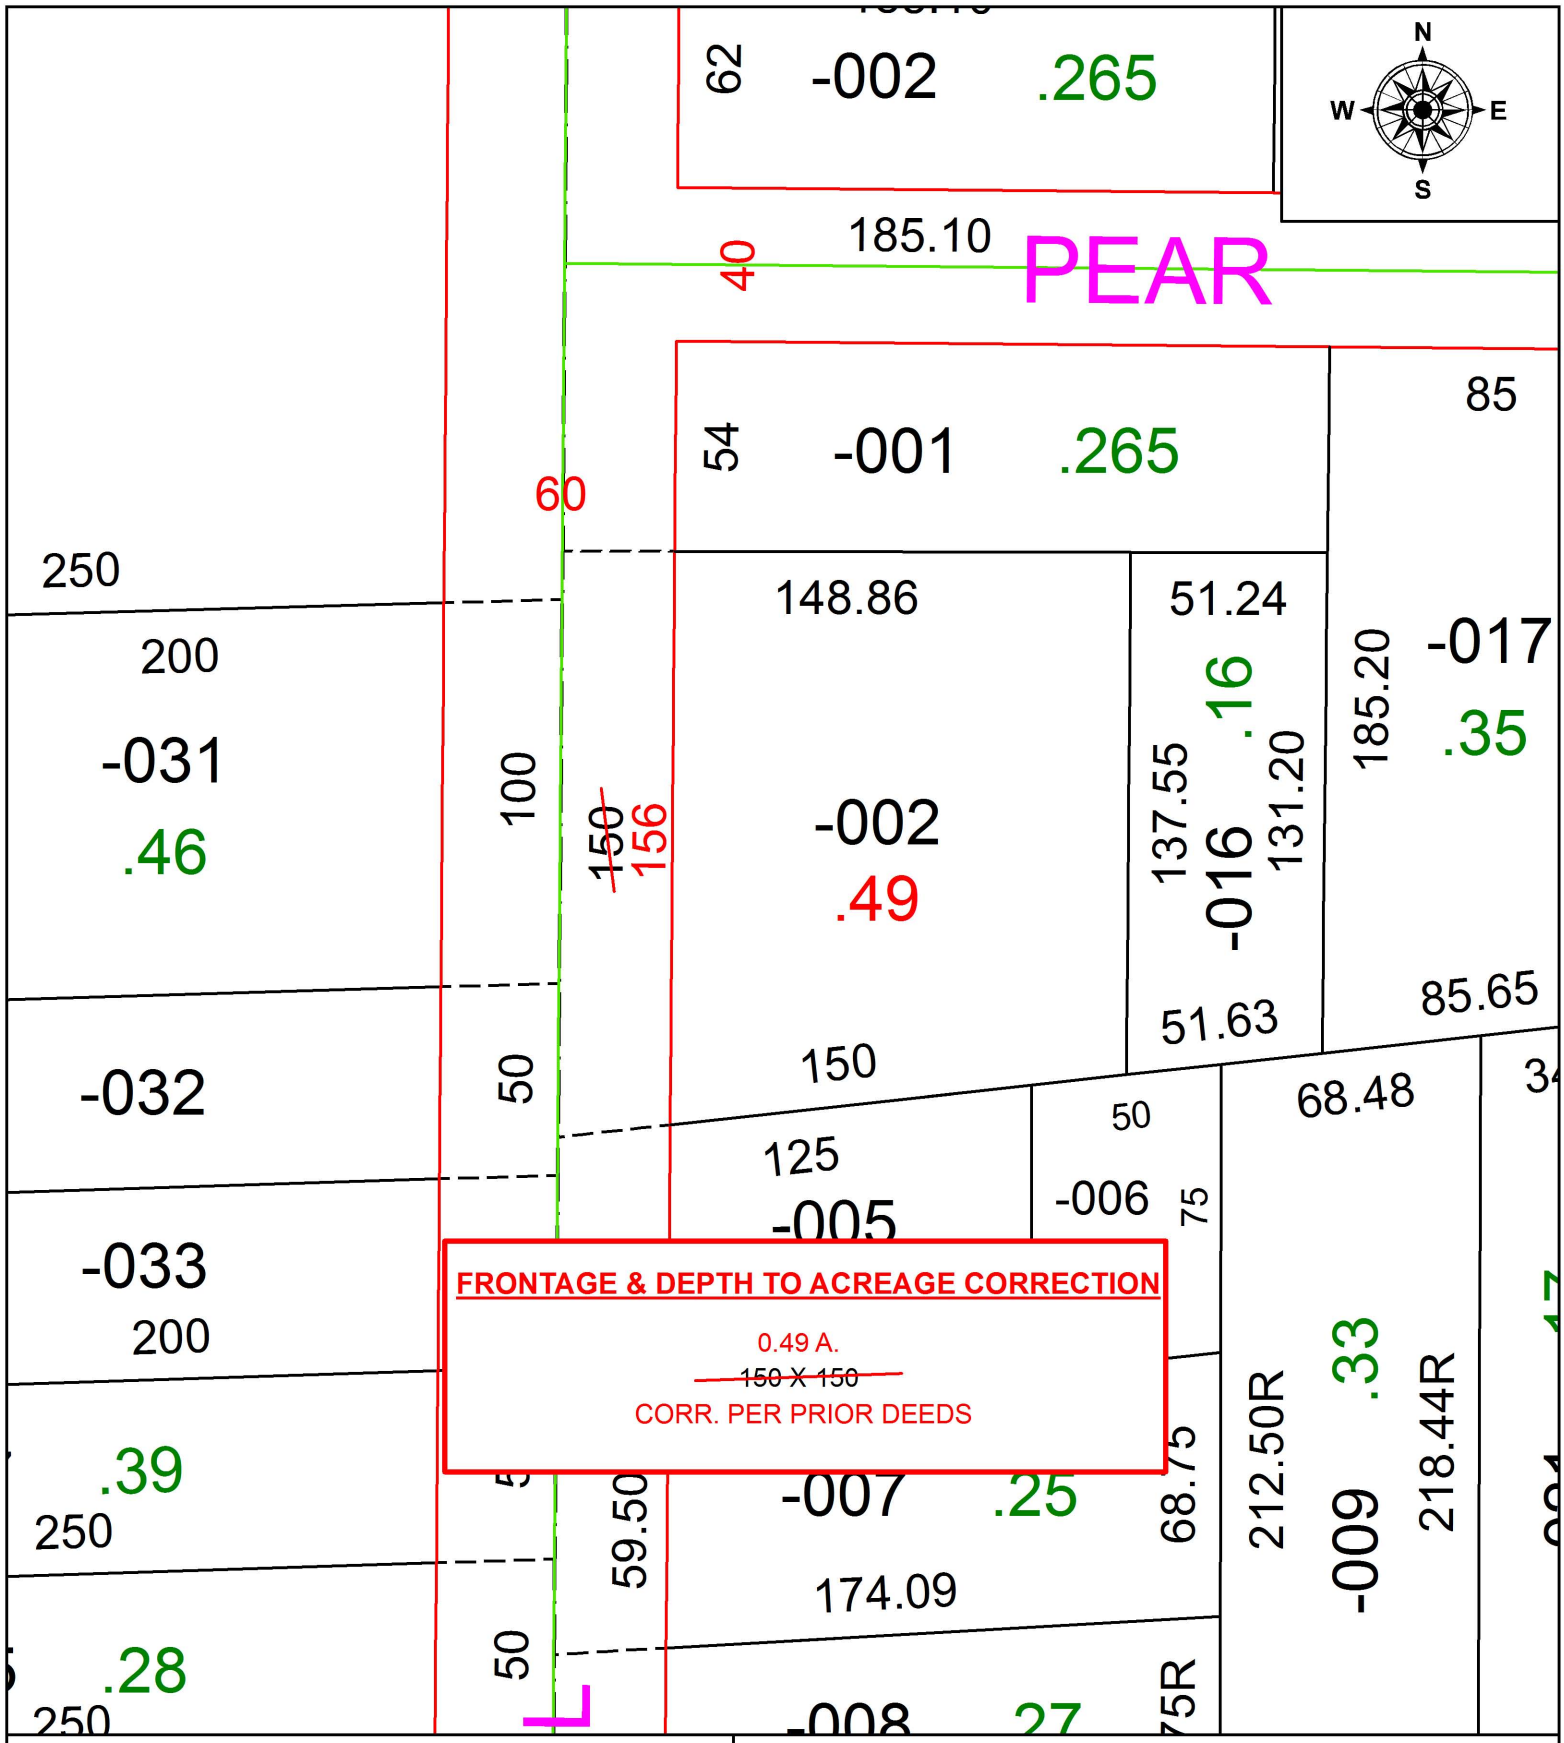

SPLITS/DEEDS PROCESSED
LORAIN COUNTY TAX MAP DEPARTMENT
226 MIDDLE AVE. ELYRIA, OH

SURVEYED BY: N/A
CLOSURE: 1: 161,733
MAP PAGE(S): 4-00-027
APPOVED BY: RRM **DATE:** 6-28-17
SCALE: 1" = 50 **PRIOR INSTRUMENT:** N/A