PARENT PARCEL: 17-08-032-000-006

CHILD PARCEL: 17-08-032-000-012, -013

STARTING POINT: INTERSECTION OF C/L OF PECK WADSWORTH RD. AND C/L OF S.R.511

17-03698

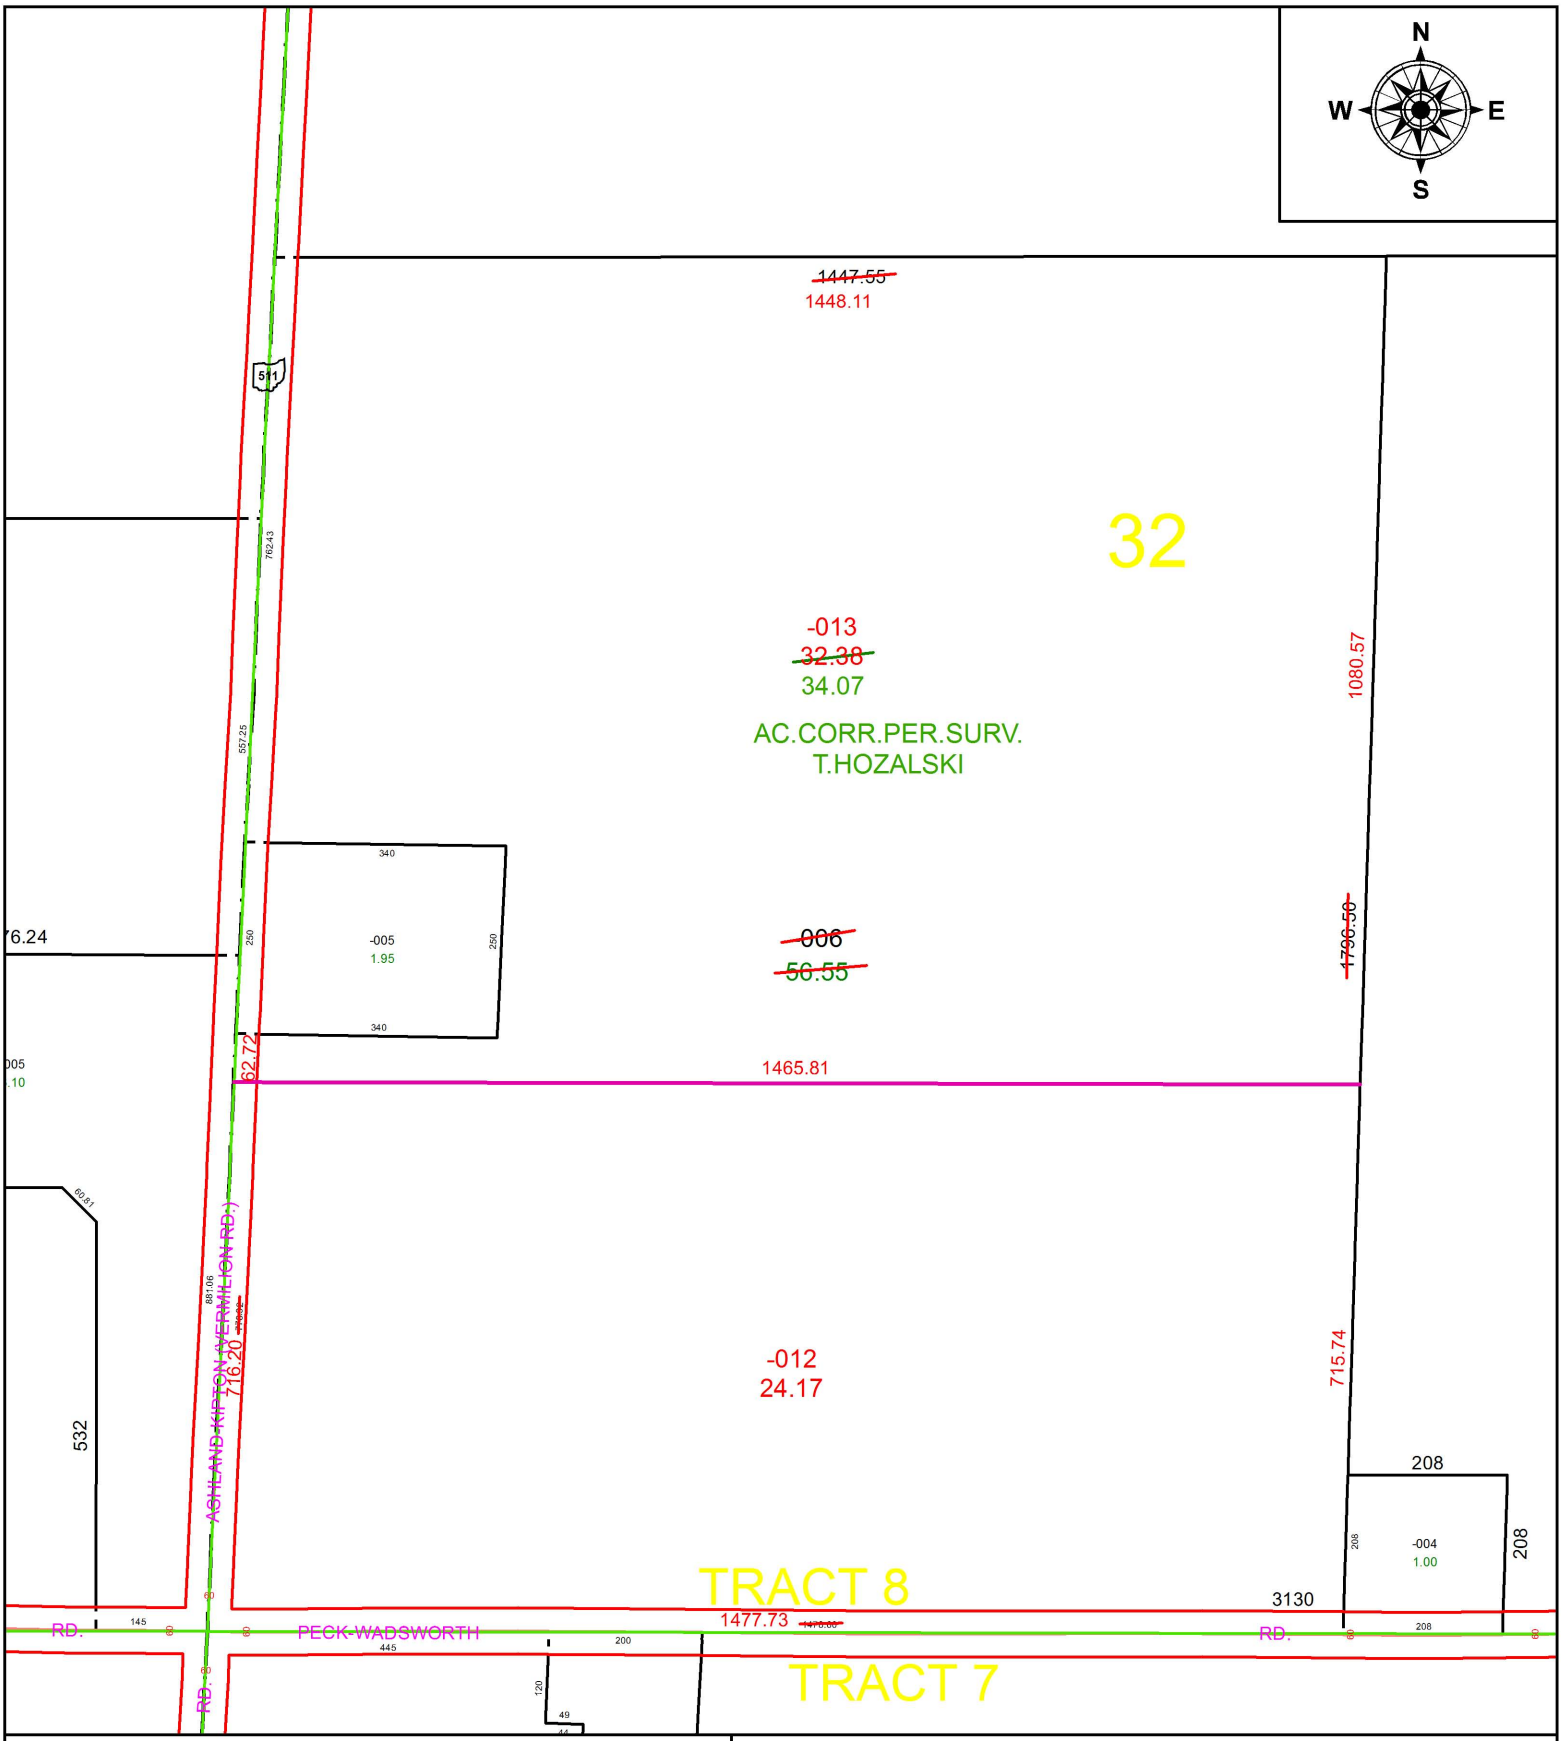

SPLITS/DEEDS PROCESSED

LORAIN COUNTY TAX MAP DEPARTMENT
226 MIDDLE AVE. ELYRIA, OH

SURVEYED BY: TIMOTHY D. HOZALSKI
CLOSURE: 1: 2,426,668
MAP PAGE(S): 17-C
APPOVED BY: RRM **DATE:** 7-21-17
SCALE: 1" = 250 **PRIOR INSTRUMENT:** 20150550612