PARENT PARCEL: 17-08-022-000-006, 17-08-033-000-001

CHILD PARCEL: 17-08-022-000-006, 17-08-033-000-009, -010

STARTING POINT: INTERSECTION OF C/L OF PECK WADSWORTH RD. AND C/L OF S.R. 511

17-03699

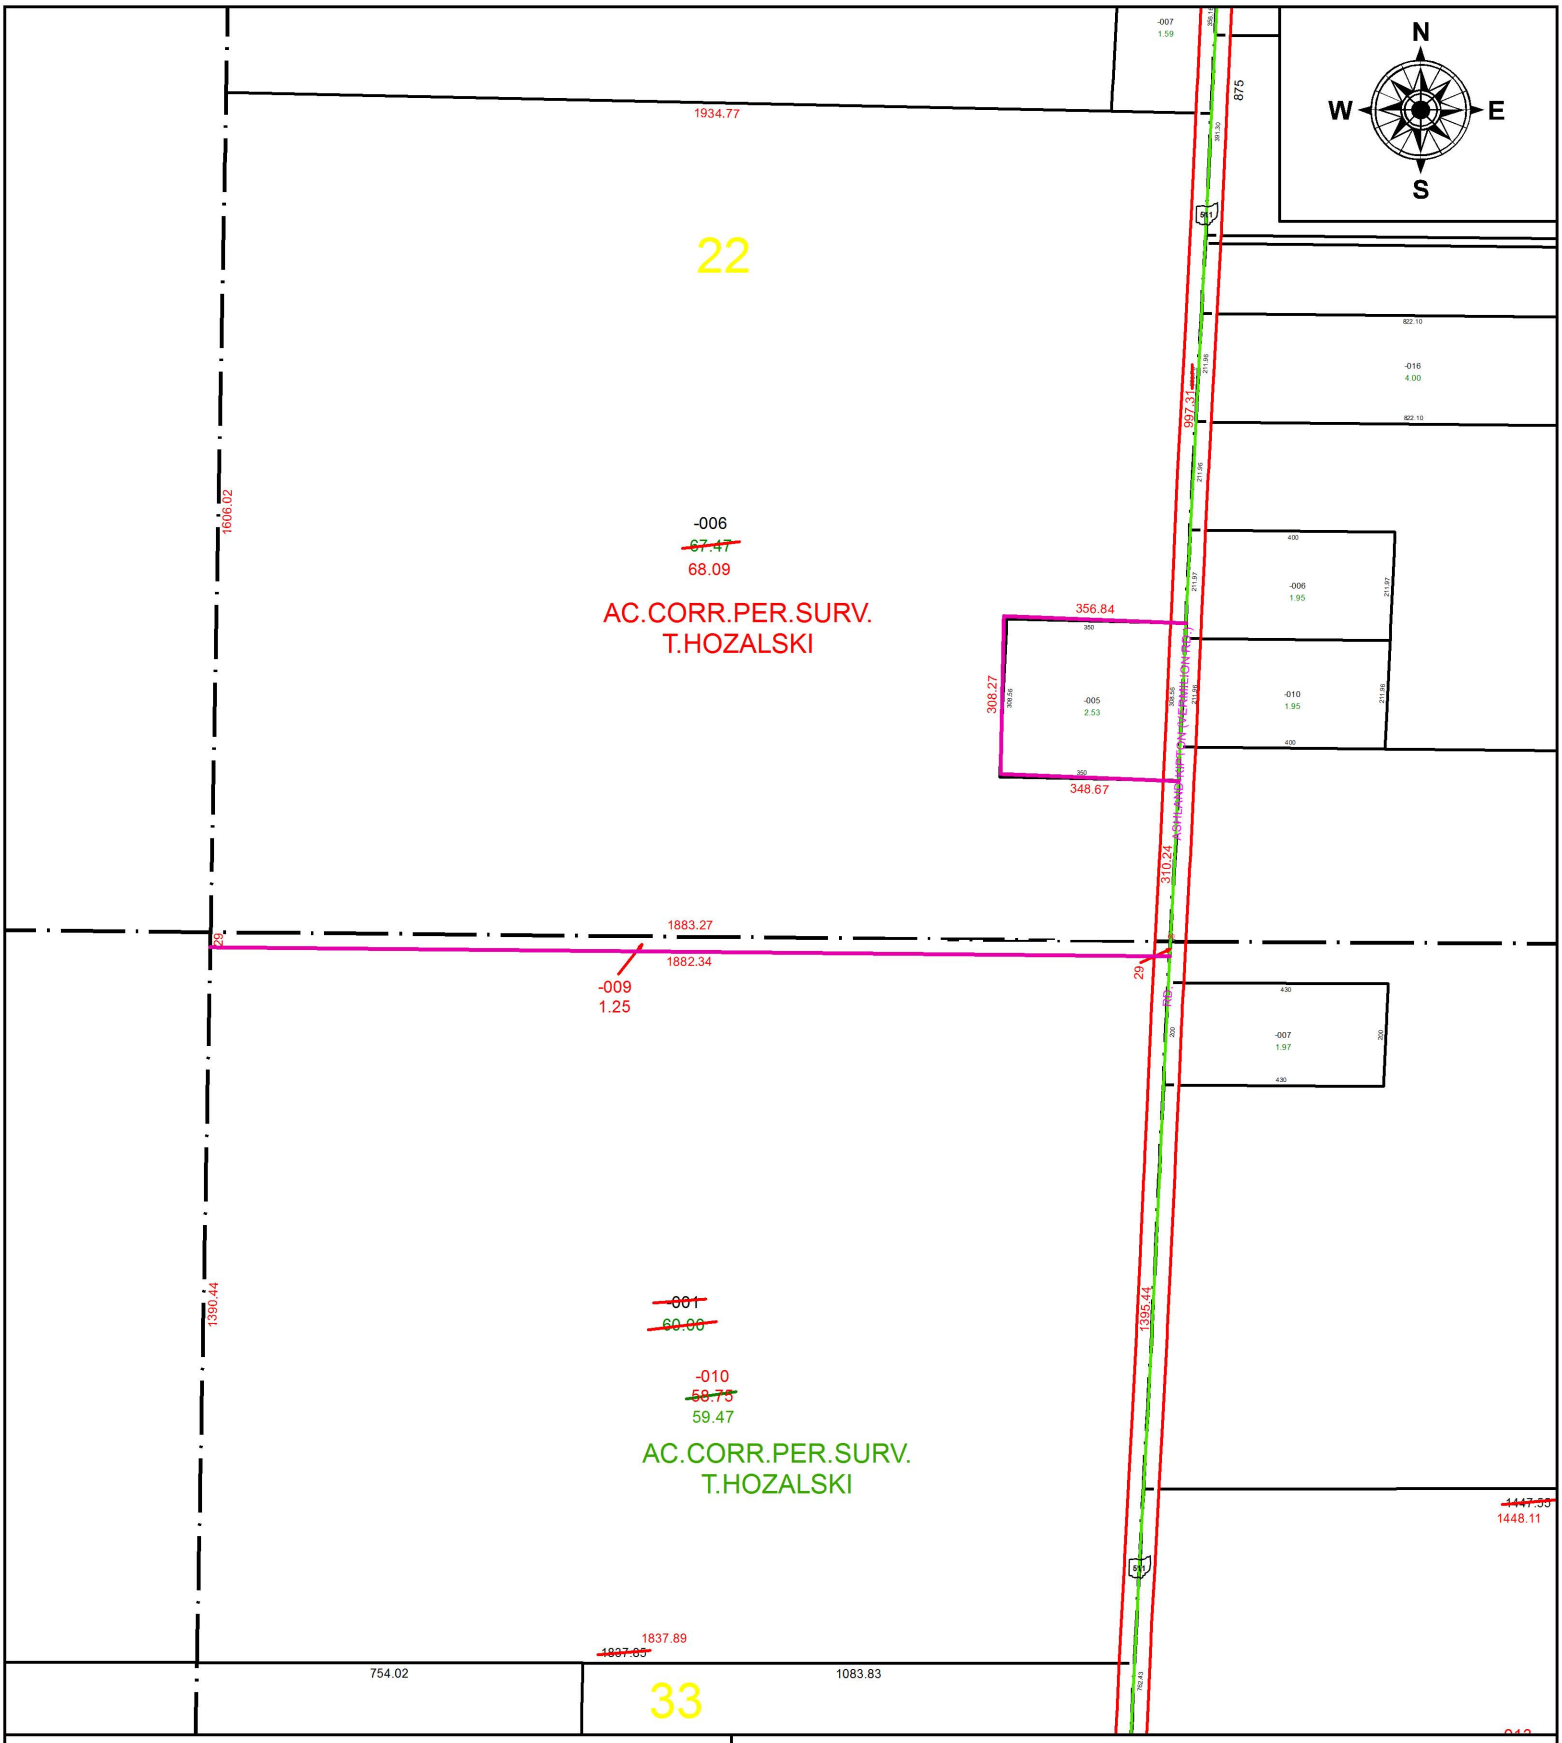

SPLITS/DEEDS PROCESSED

LORAIN COUNTY TAX MAP DEPARTMENT
226 MIDDLE AVE. ELYRIA, OH

SURVEYED BY: TIMOTHY D. HOZALSKI
CLOSURE: 1: 270,248
MAP PAGE(S): 17-B
APPOVED BY: RRM **DATE:** 7-21-17
SCALE: 1" = 375 **PRIOR INSTRUMENT:** 20150550612