PARENT PARCEL: 10-00-007-106-009
CHILD PARCEL: XX-XX-XXX-XXX-XXX
STARTING POINT: INTERSECTION OF C/L OF BUTTERNUT RIDGE RD. AND C/L OF INDIAN HOLLOW RD.

17-03700-D

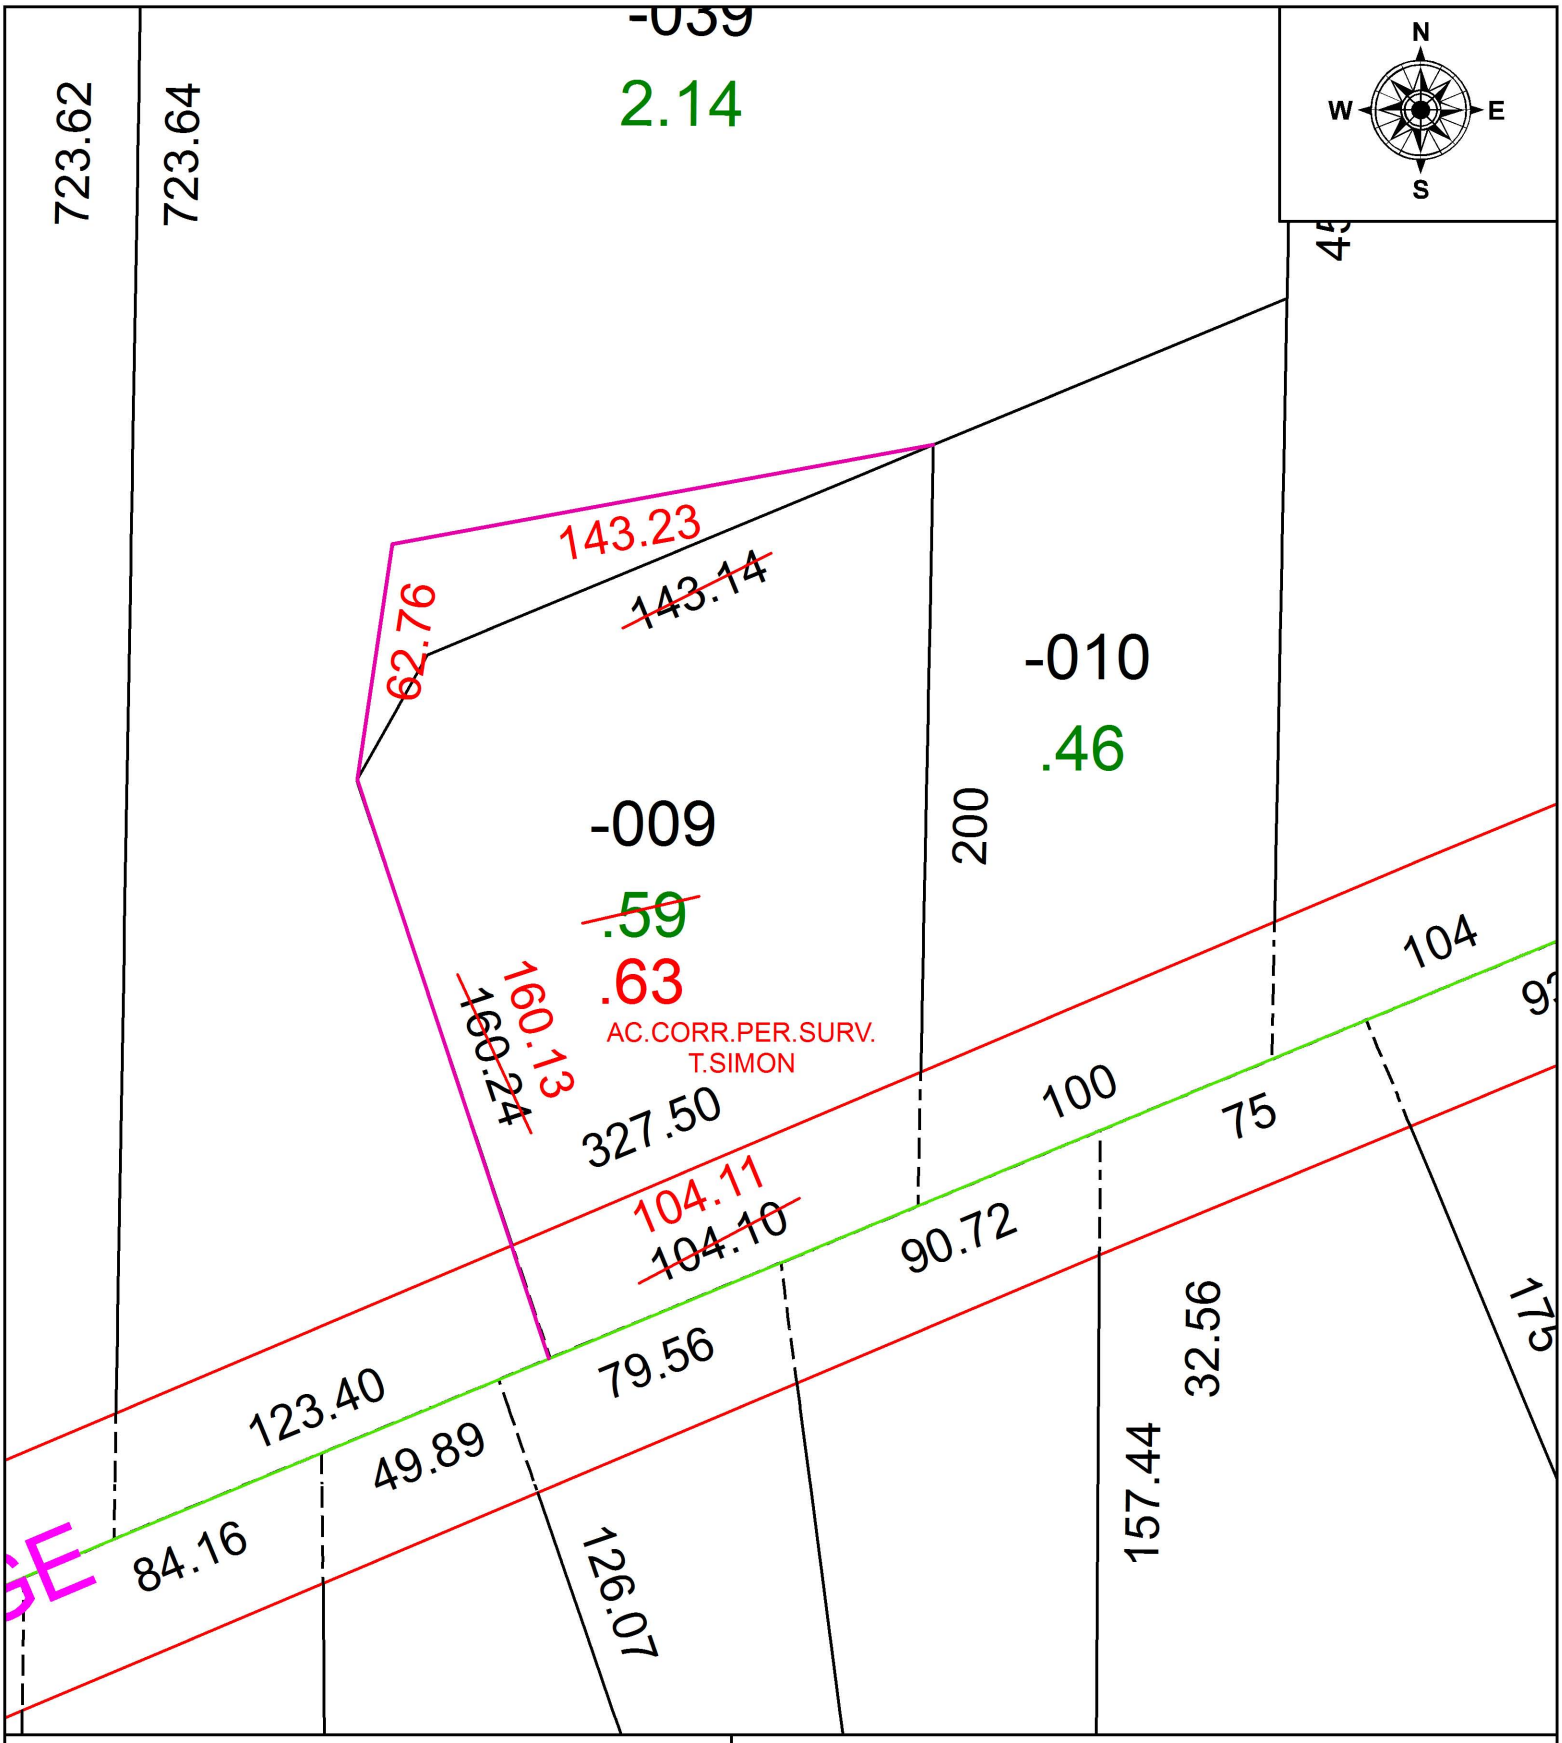

SPLITS/DEEDS PROCESSED
LORAIN COUNTY TAX MAP DEPARTMENT
226 MIDDLE AVE. ELYRIA, OH

SURVEYED BY: THOMAS A. SIMON
CLOSURE: 1: 84,378
MAP PAGE(S): 10-00-007
APPOVED BY: RRM **DATE:** 6-30-17
SCALE: 1" = 50 **PRIOR INSTRUMENT:** 20150551465