PARENT PARCEL: 04-00-027-101-178, -190

CHILD PARCEL: 04-00-027-101-191 THRU -196

STARTING POINT: INTERSECTION OF C/L OF LEAR NAGEL RD. AND C/L OF RELOCATED AVON RD.

17-03700

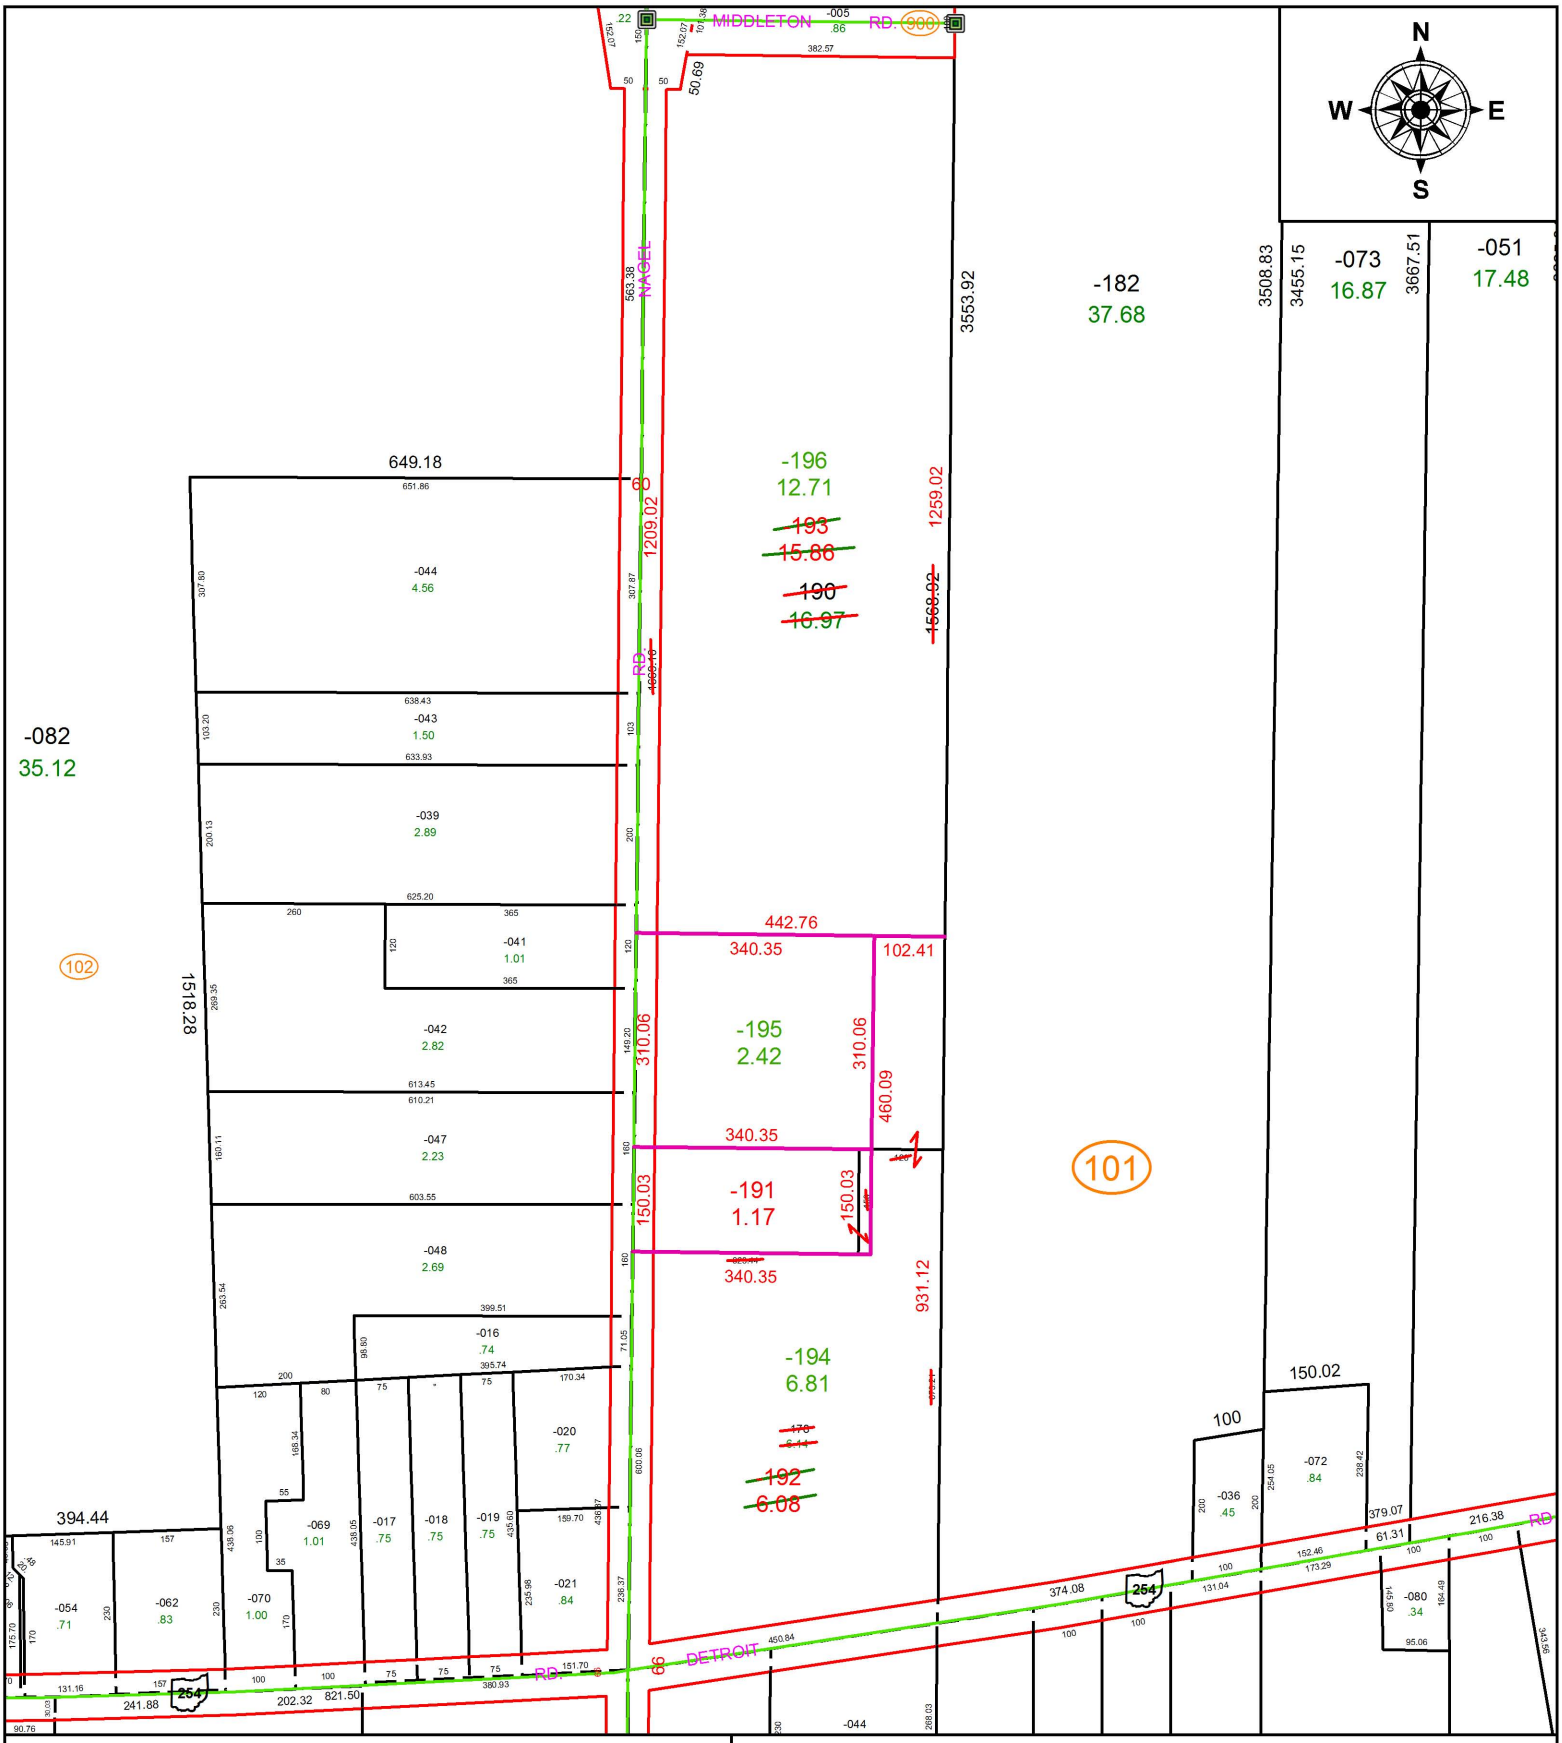

SPLITS/DEEDS PROCESSED

LORAIN COUNTY TAX MAP DEPARTMENT
226 MIDDLE AVE. ELYRIA, OH

SURVEYED BY: TREVOR A. BIXLER
CLOSURE: 1: 799,701
MAP PAGE(S): 4-00-027
APPOVED BY: RRM **DATE:** 7-21-17
SCALE: 1" = 275 **PRIOR INSTRUMENT:** 20080239739