PARENT PARCEL: 20-05-012-000-008

CHILD PARCEL: 20-05-012-000-009, -010

STARTING POINT: INTERSECTION OF C/L OF ANDERSON RD. AND C/L OF GRIGGS RD.

17-03701

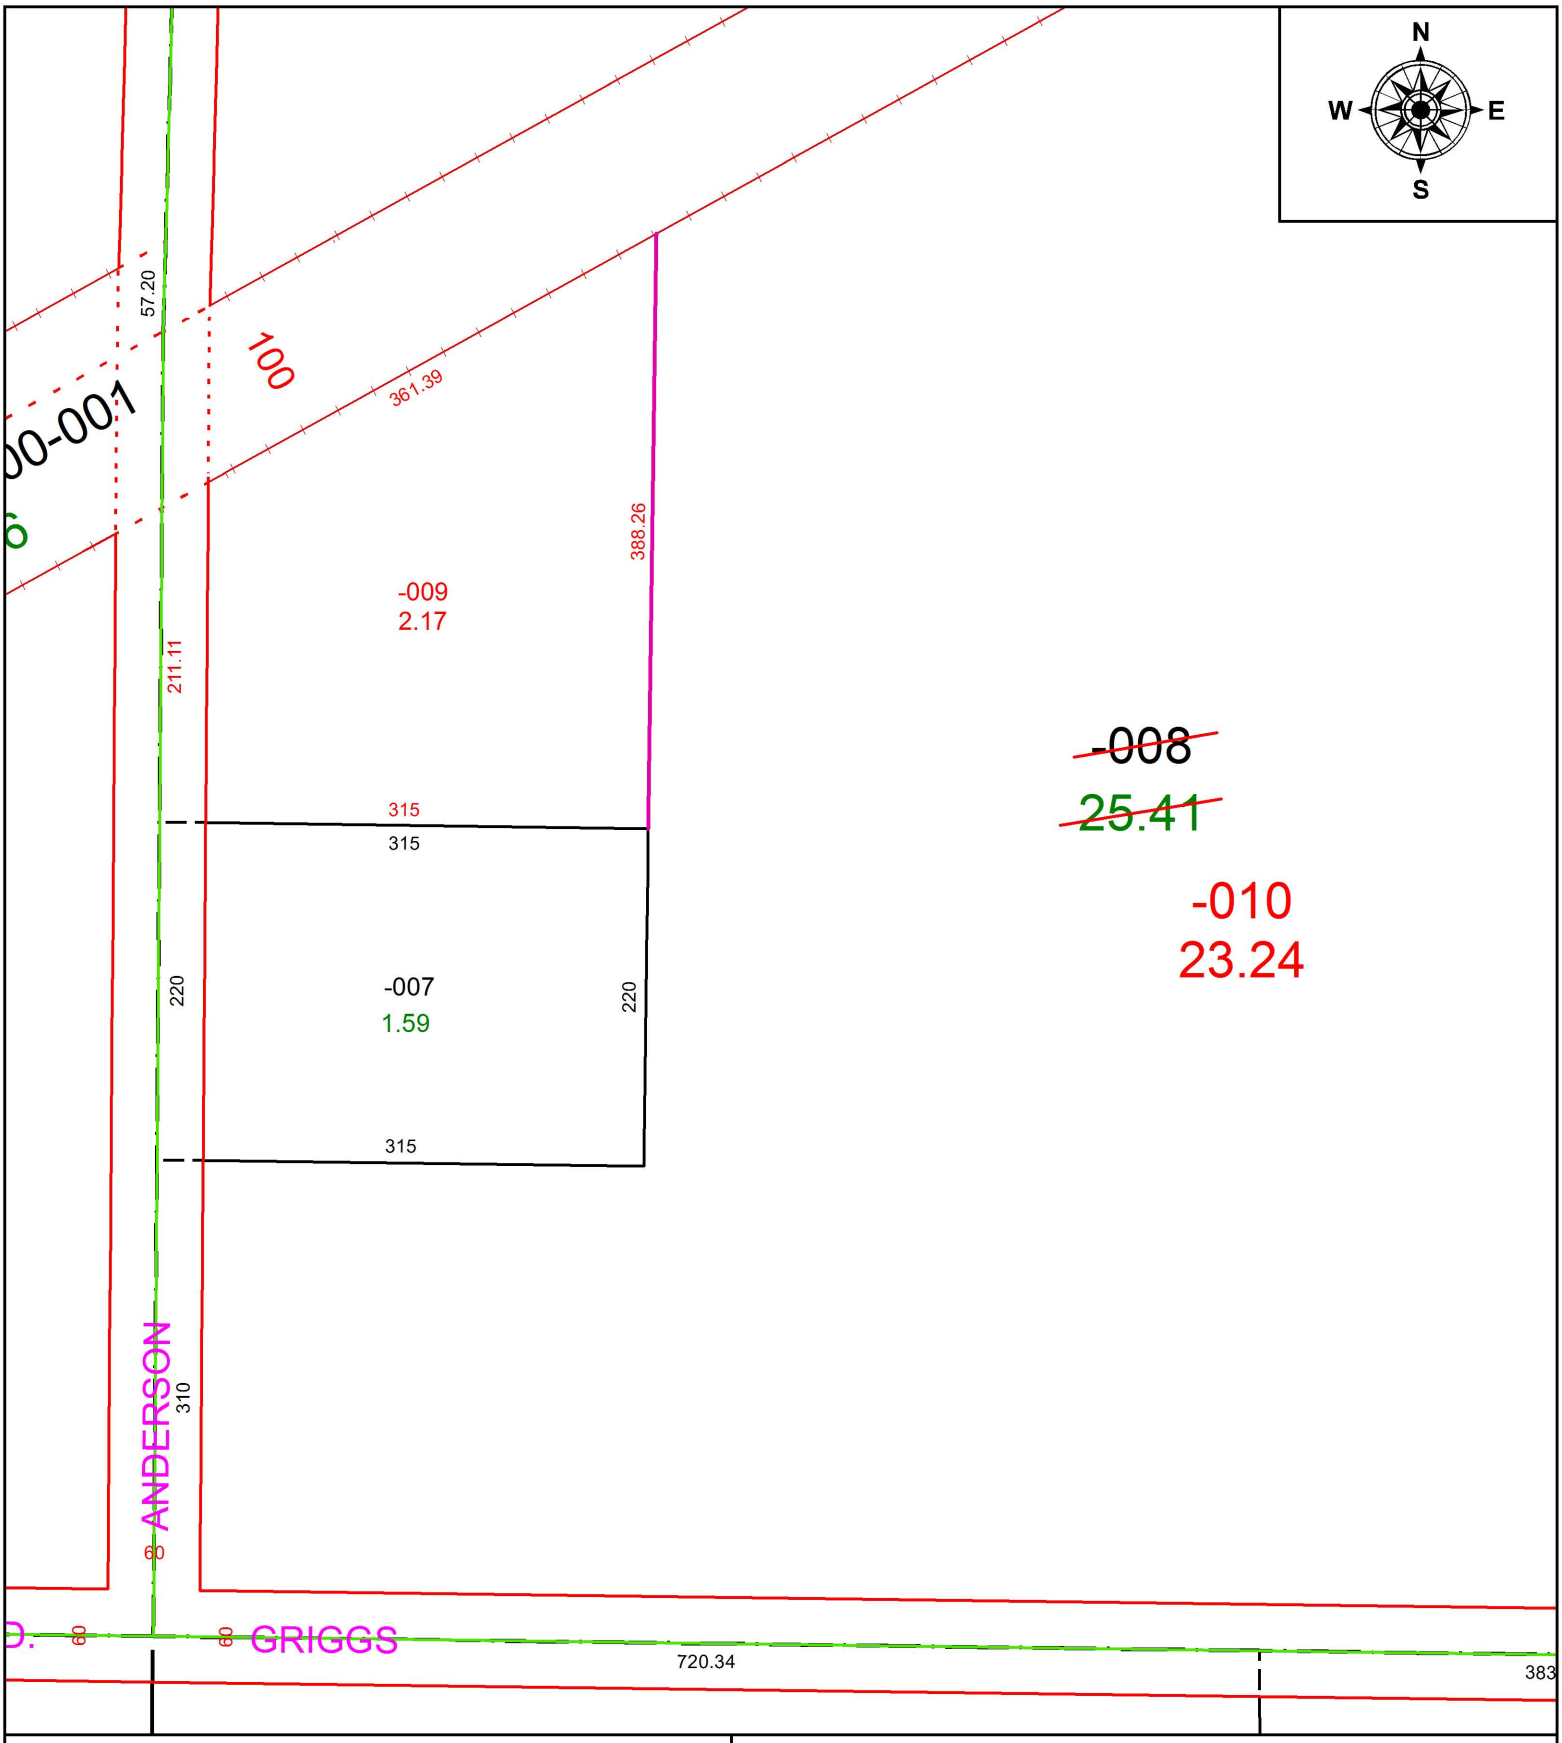

SPLITS/DEEDS PROCESSED

LORAIN COUNTY TAX MAP DEPARTMENT
226 MIDDLE AVE. ELYRIA, OH

SURVEYED BY: JAMES ALLEN COTTRELL
CLOSURE: 1: 153,039
MAP PAGE(S): 20-D
APPOVED BY: RRM **DATE:** 7-24-17
SCALE: 1" = 125 **PRIOR INSTRUMENT:** 20170628189