PARENT PARCEL: 06-25-035-103-002, -003
CHILD PARCEL: XX-XX-XXX-XXX-XXX
STARTING POINT: S/L'S 49 AND 50 IN DILWORTH'S EAST ELYRIA ALLOT. (VOL.6 PG. 32)

17-03704-C

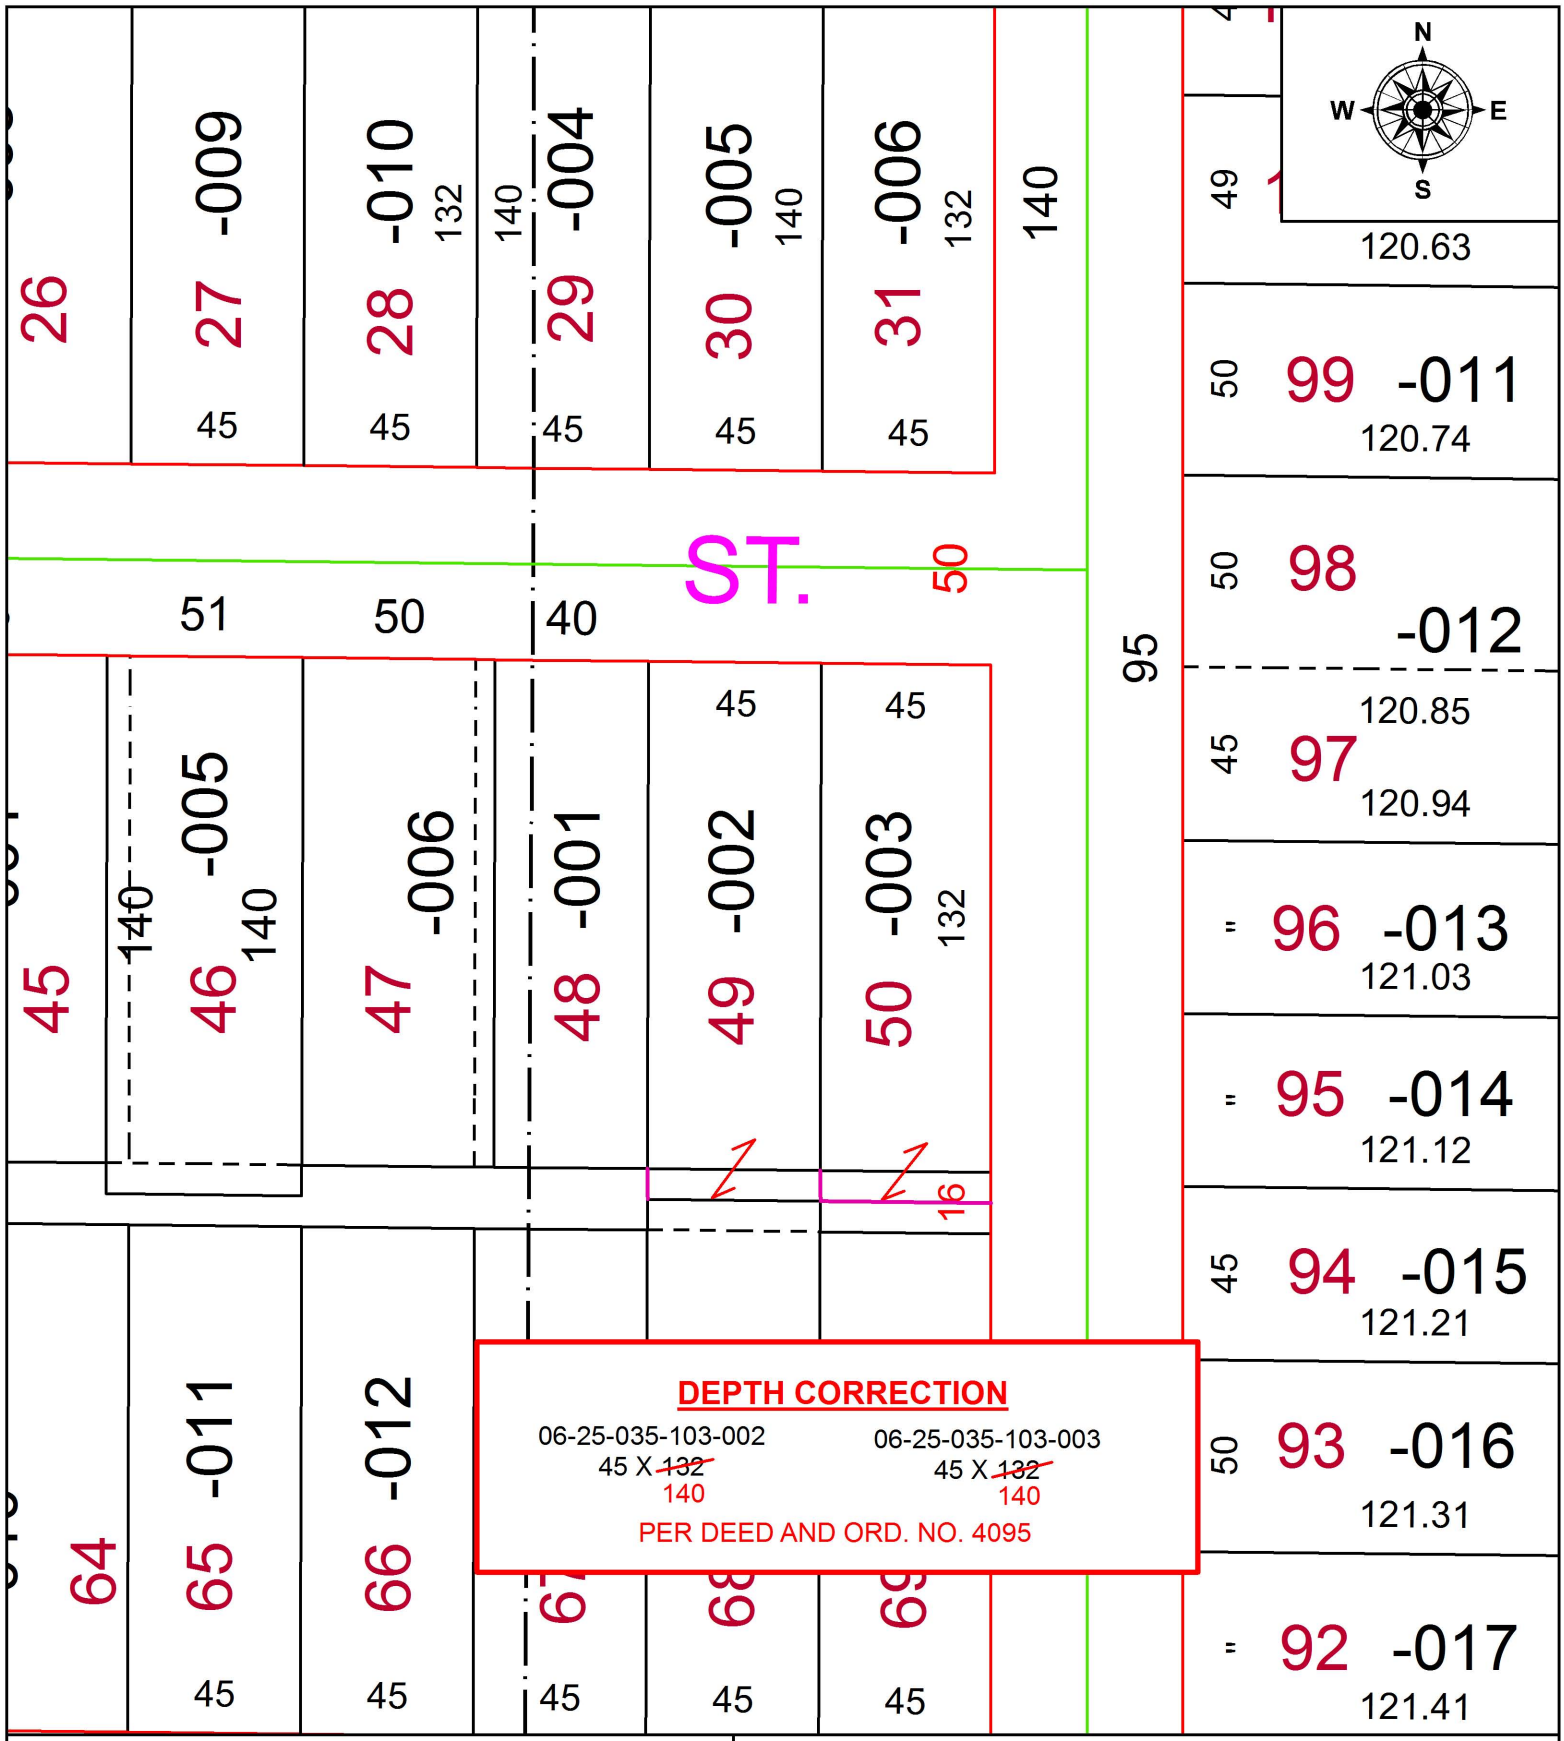

SPLITS/DEEDS PROCESSED
LORAIN COUNTY TAX MAP DEPARTMENT
226 MIDDLE AVE. ELYRIA, OH

SURVEYED BY: N/A
CLOSURE: N/A
MAP PAGE(S): 6-86
APPOVED BY: RRM **DATE:** 7-12-17
SCALE: 1" = 50 **PRIOR INSTRUMENT:** 20170636138