PARENT PARCEL: 06-21-003-101-034, -036

CHILD PARCEL: 06-21-003-101-037 THRU -039

STARTING POINT: INTERSECTION OF C/L OF NORTH RIDGE RD. AND C/L OF LAKE AVE.

17-03705

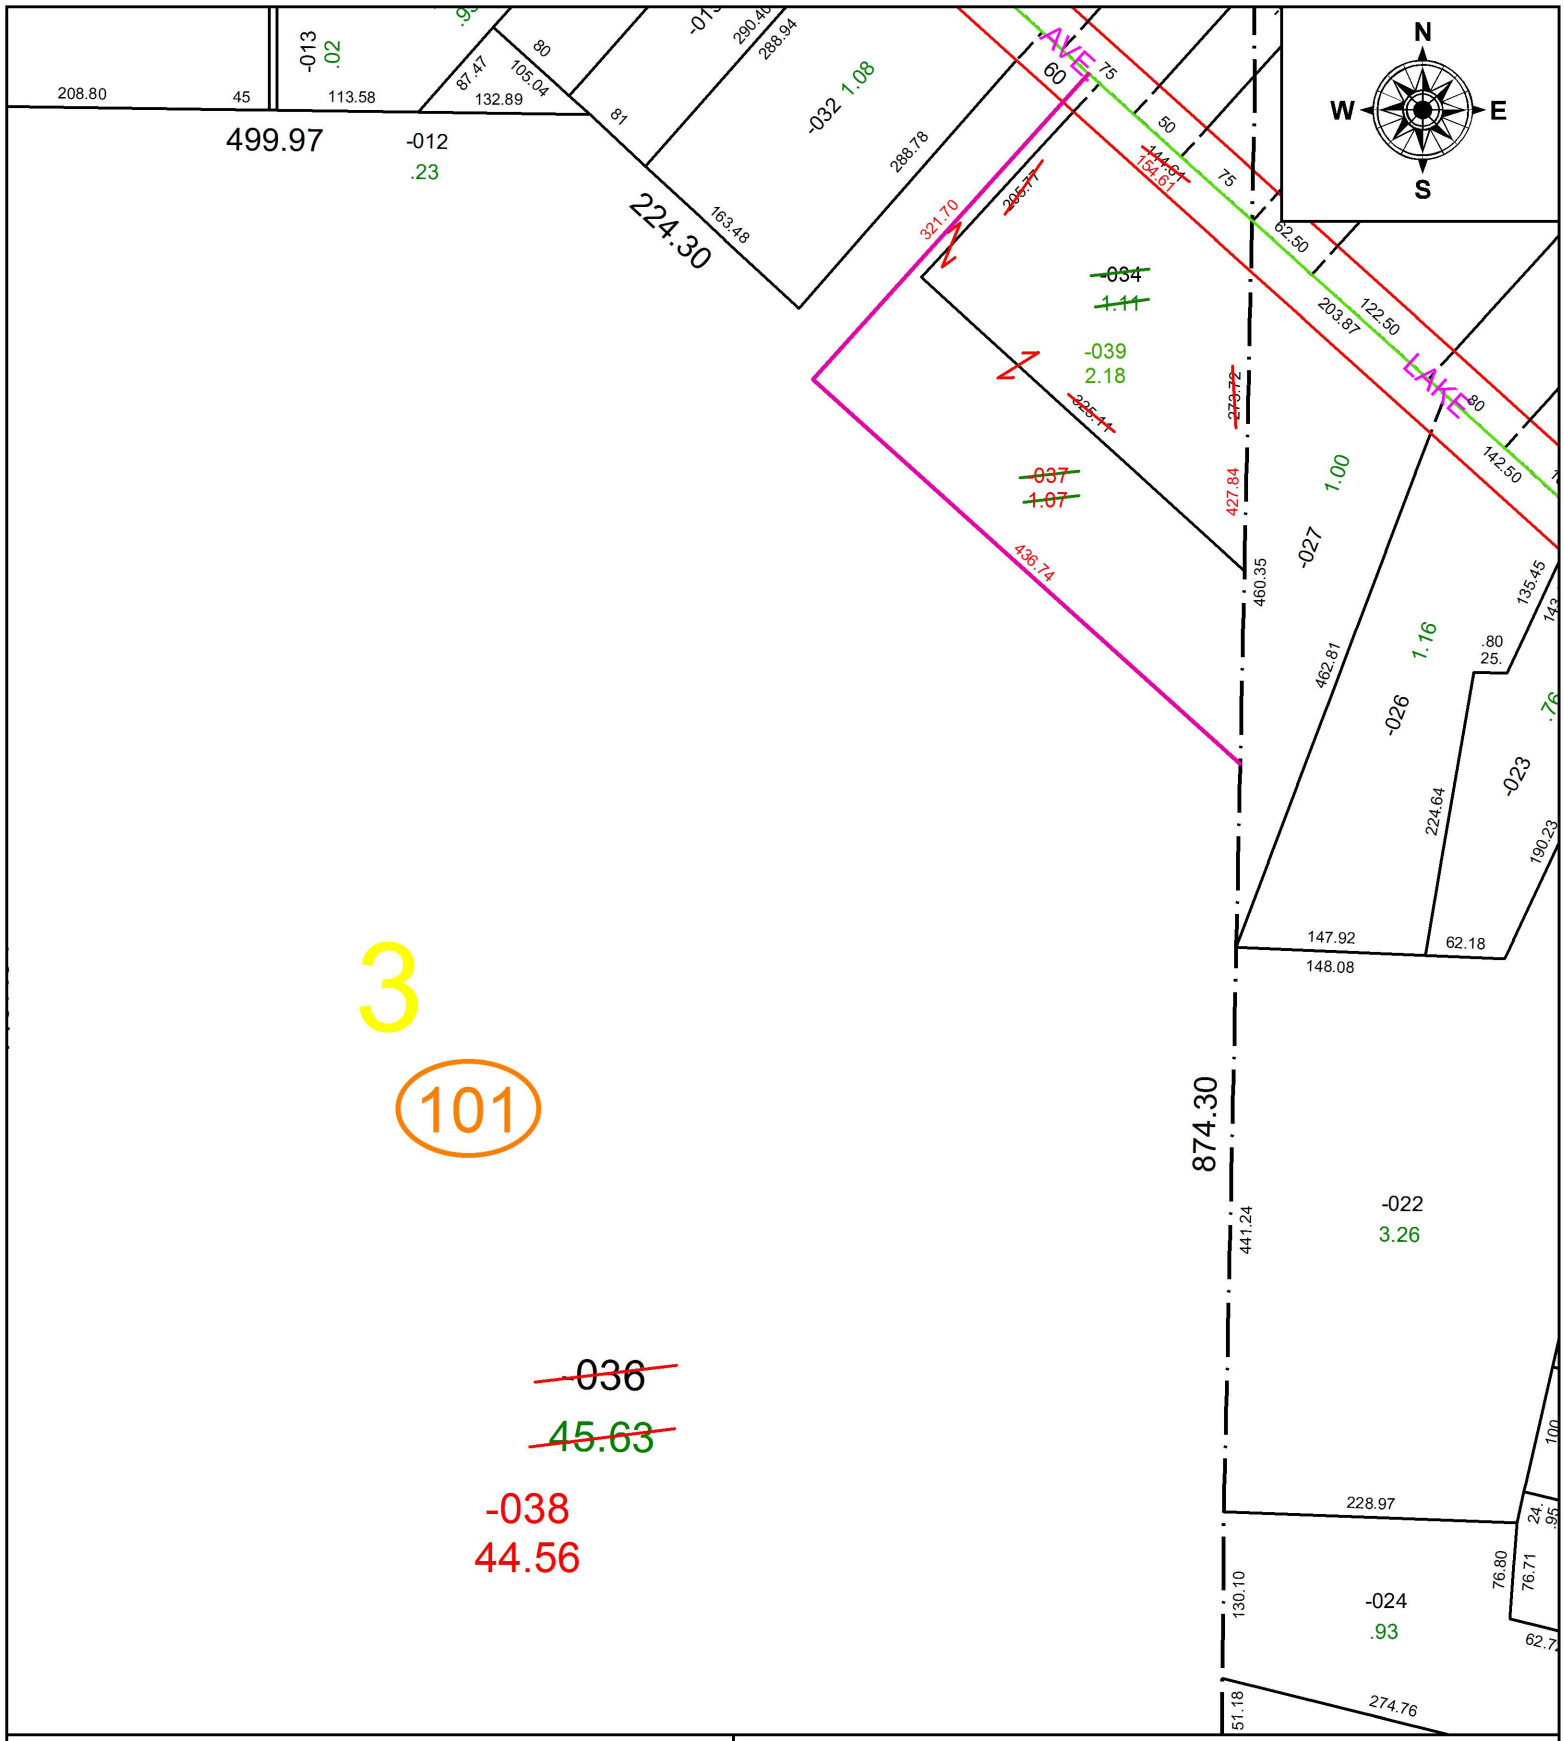

SPLITS/DEEDS PROCESSED

LORAIN COUNTY TAX MAP DEPARTMENT
226 MIDDLE AVE. ELYRIA, OH

SURVEYED BY: THOMAS A. SIMON
CLOSURE: 1: 545,007
MAP PAGE(S): 6-4
APPOVED BY: RRM **DATE:** 7-28-17
SCALE: 1" = 150 **PRIOR INSTRUMENT:** 20140517209