PARENT PARCEL: 04-00-007-105-058
CHILD PARCEL: 04-00-007-105-064, -065
STARTING POINT: INTERSECTION OF C/L OF ELECTRIC BLVD. AND C/L OF MOORE RD.

17-03707

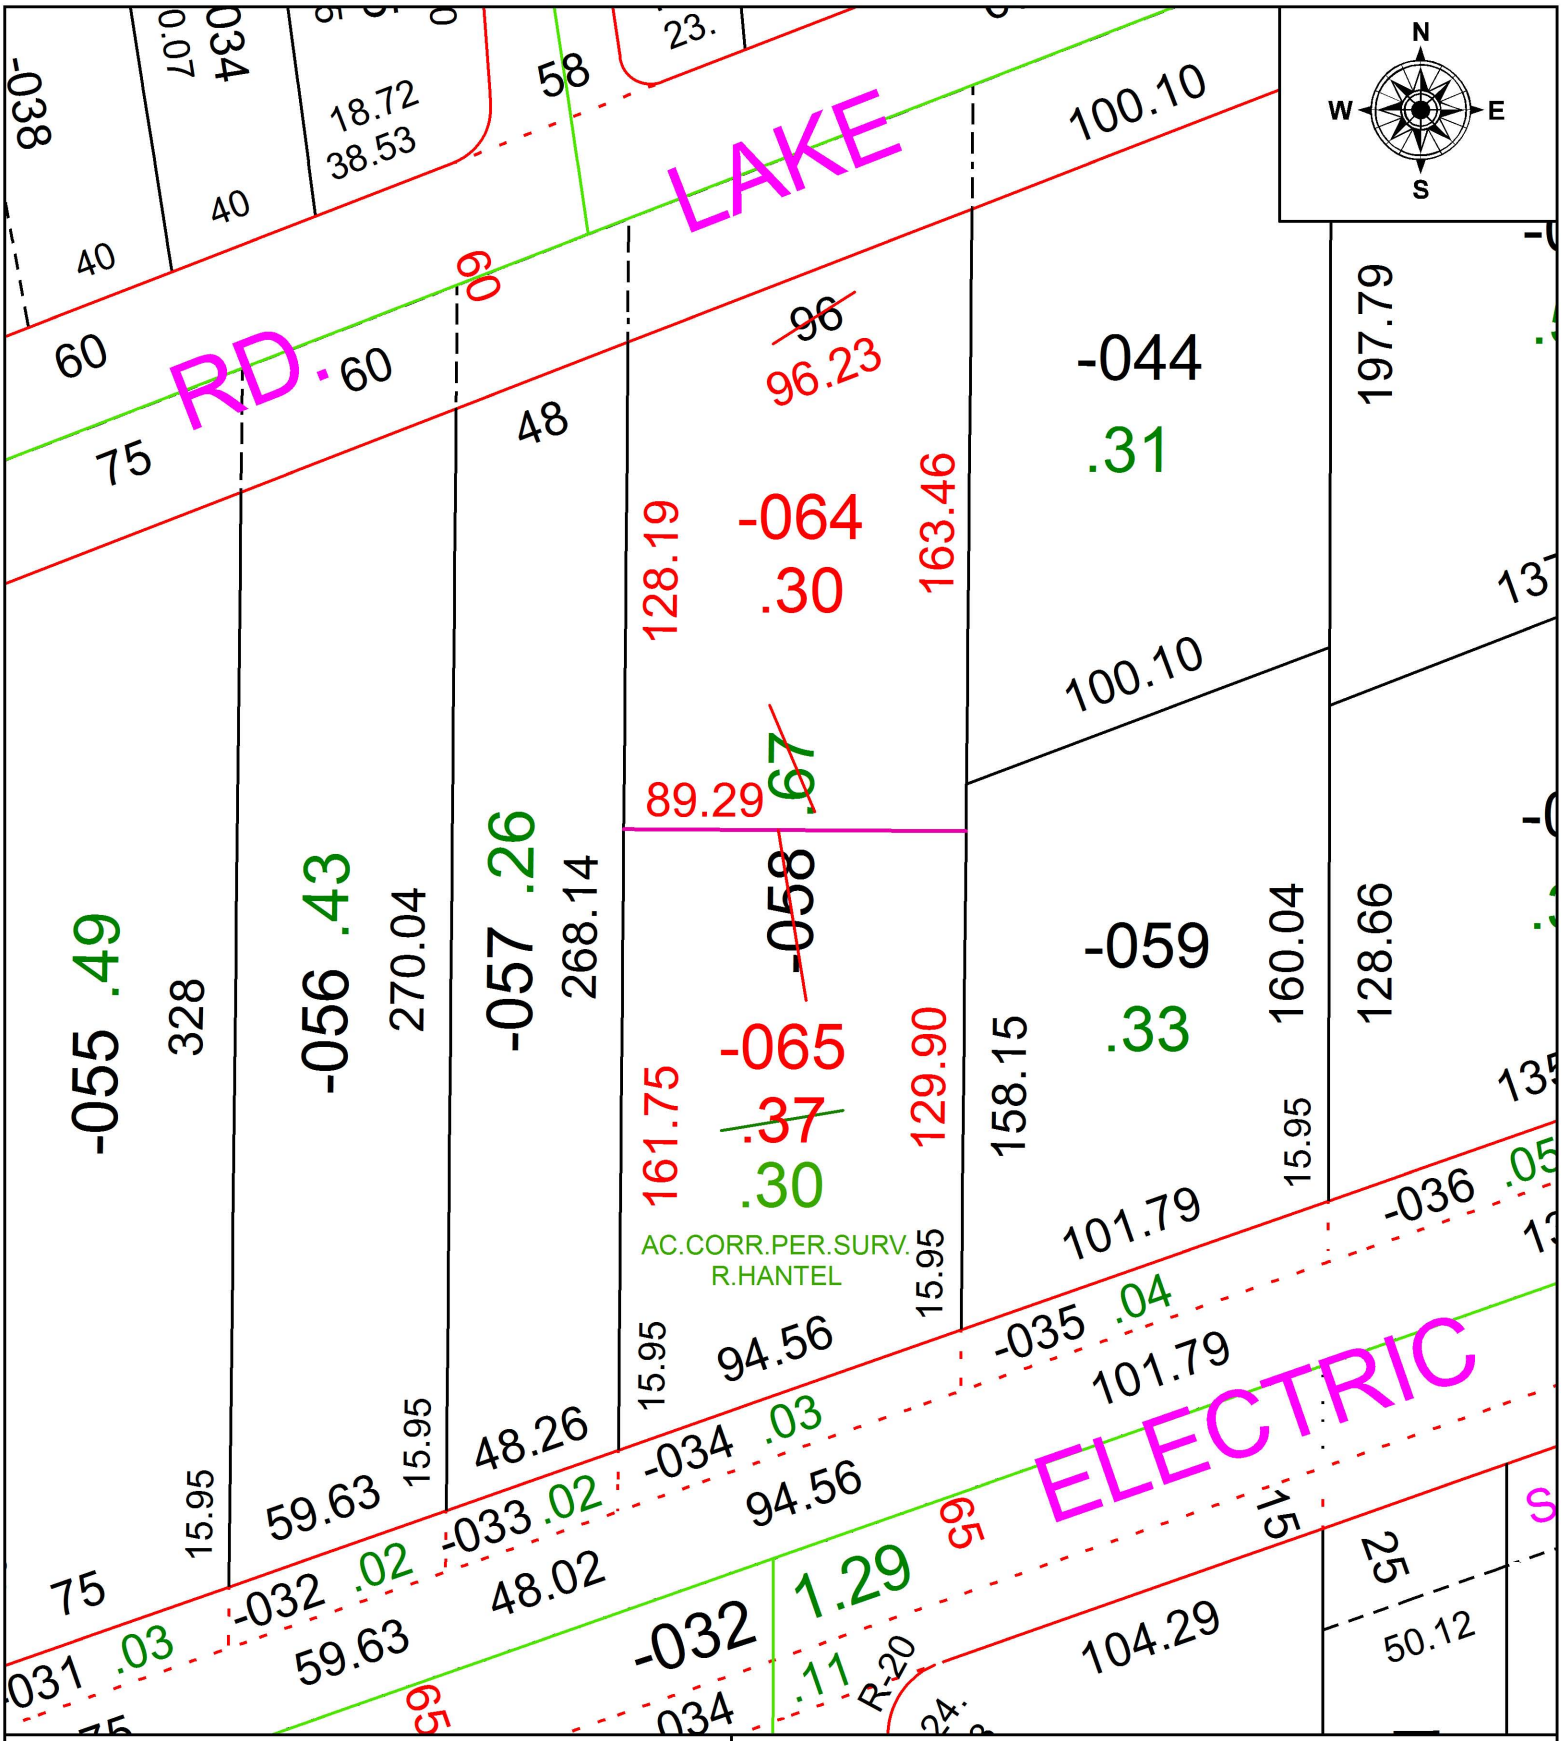

SPLITS/DEEDS PROCESSED
LORAIN COUNTY TAX MAP DEPARTMENT
226 MIDDLE AVE. ELYRIA, OH

SURVEYED BY: RICHARD F. HANTEL
CLOSURE: 1: 69,072
MAP PAGE(S): 4-00-007
APPOVED BY: RRM **DATE:** 8-1-17
SCALE: 1" = 125 **PRIOR INSTRUMENT:** 20170623174