PARENT PARCEL: 11-00-020-000-032

CHILD PARCEL: 11-00-020-000-033, -034

STARTING POINT: NORTHEAST CORNER OF O.L.20

17-03710

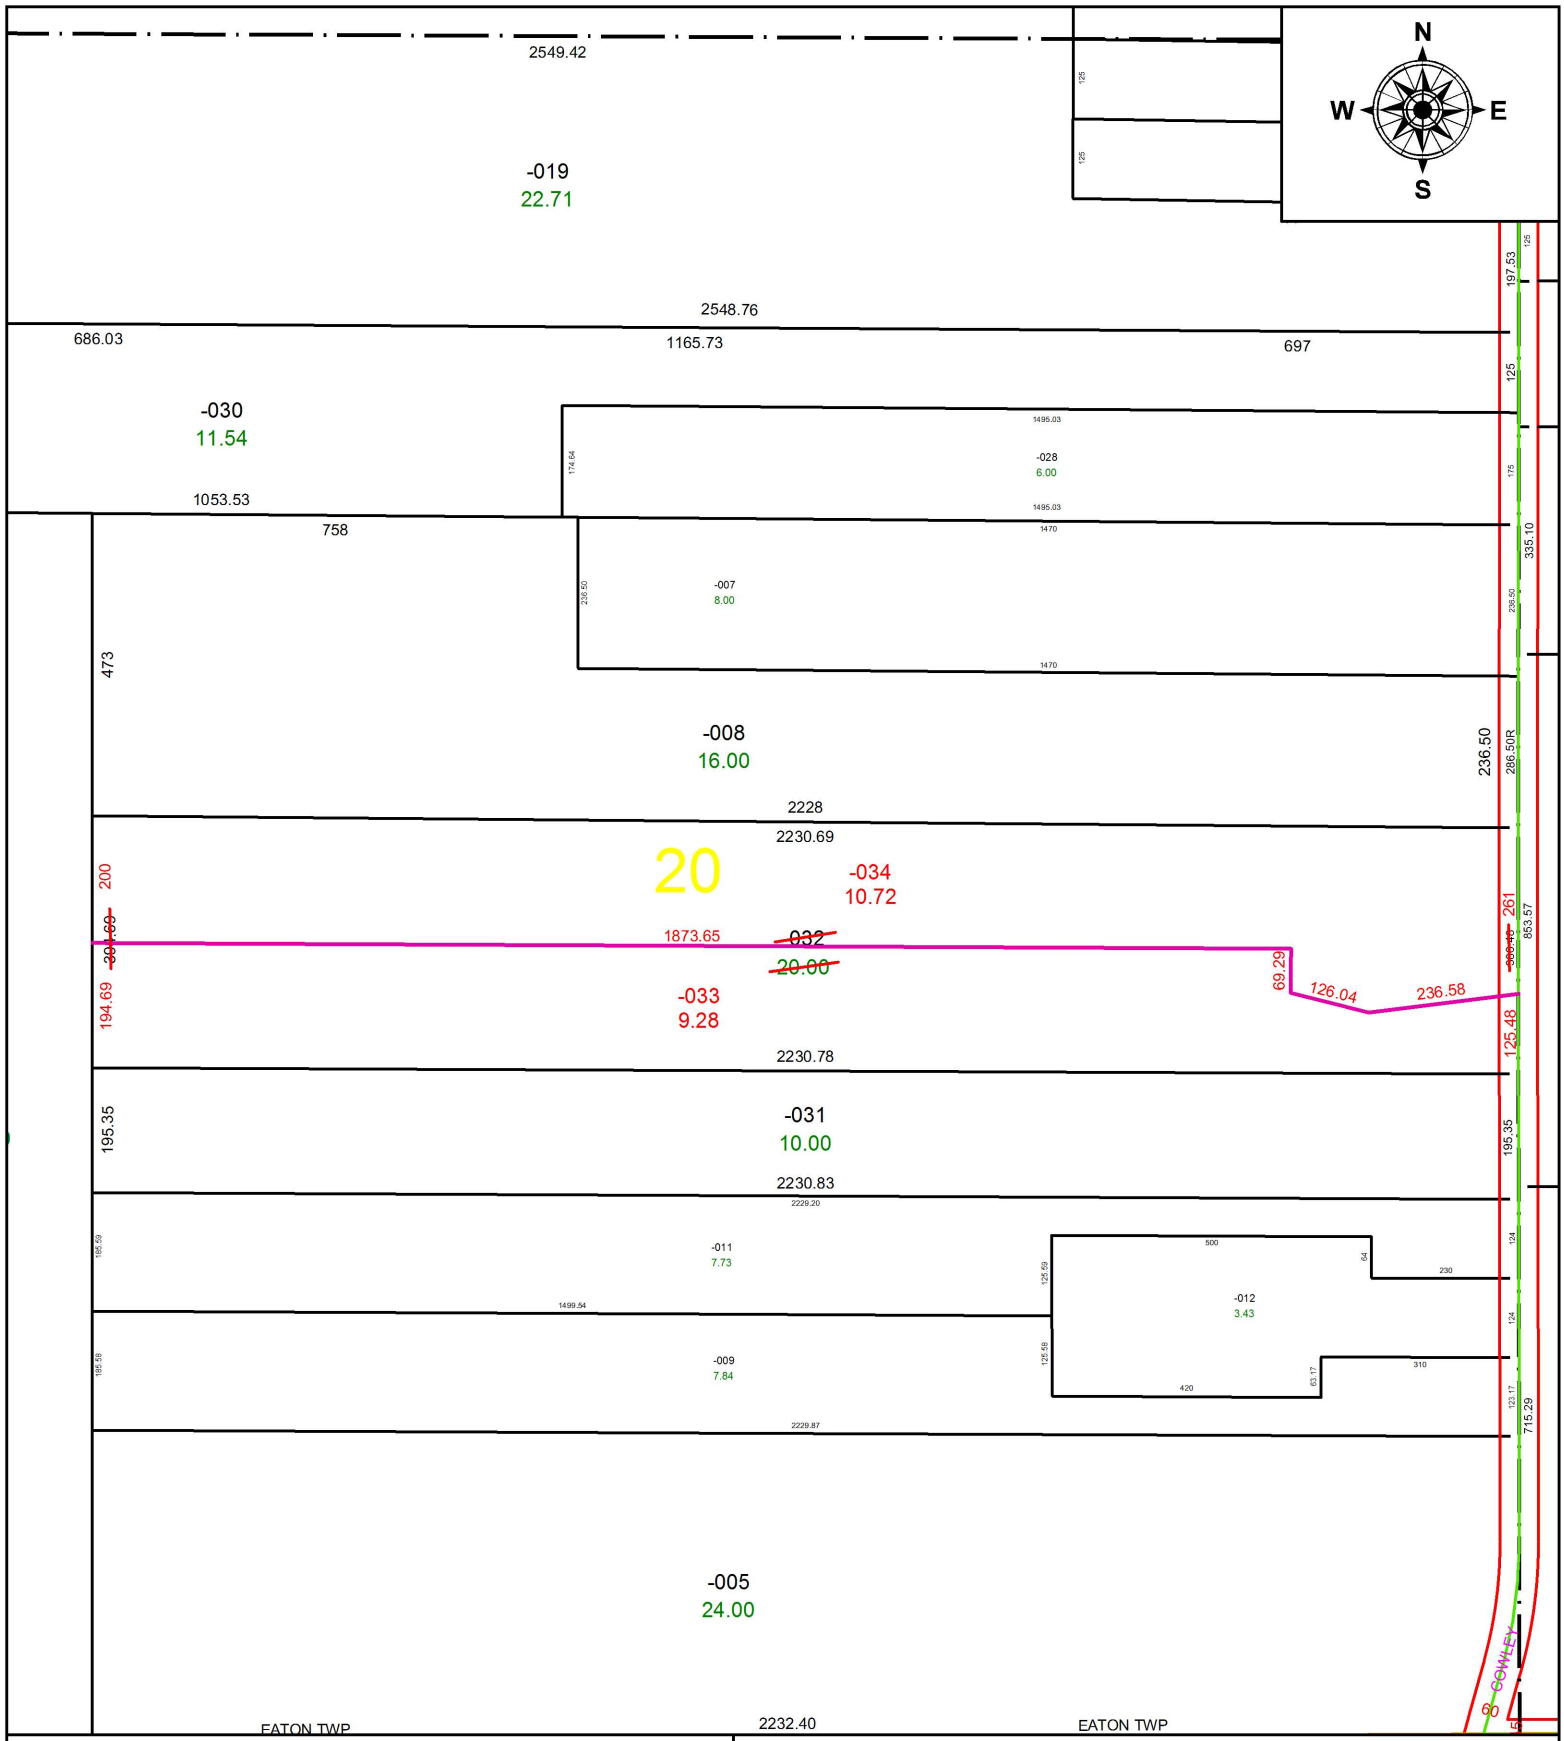

SPLITS/DEEDS PROCESSED

LORAIN COUNTY TAX MAP DEPARTMENT
226 MIDDLE AVE. ELYRIA, OH

SURVEYED BY: THOMAS A. SIMON

CLOSURE: 1: 497,103

MAP PAGE(S): 11-00-020

APPOVED BY: RRM **DATE:** 8-9-17

SCALE: 1" = 300 **PRIOR INSTRUMENT:** 20160586084