PARENT PARCEL: 07-00-025-106-004
CHILD PARCEL: XX-XX-XXX-XXX-XXX
STARTING POINT: INTERSECTION OF C/L OF ARCHER RD. AND C/L OF CHESTNUT RIDGE RD.

17-03711-D

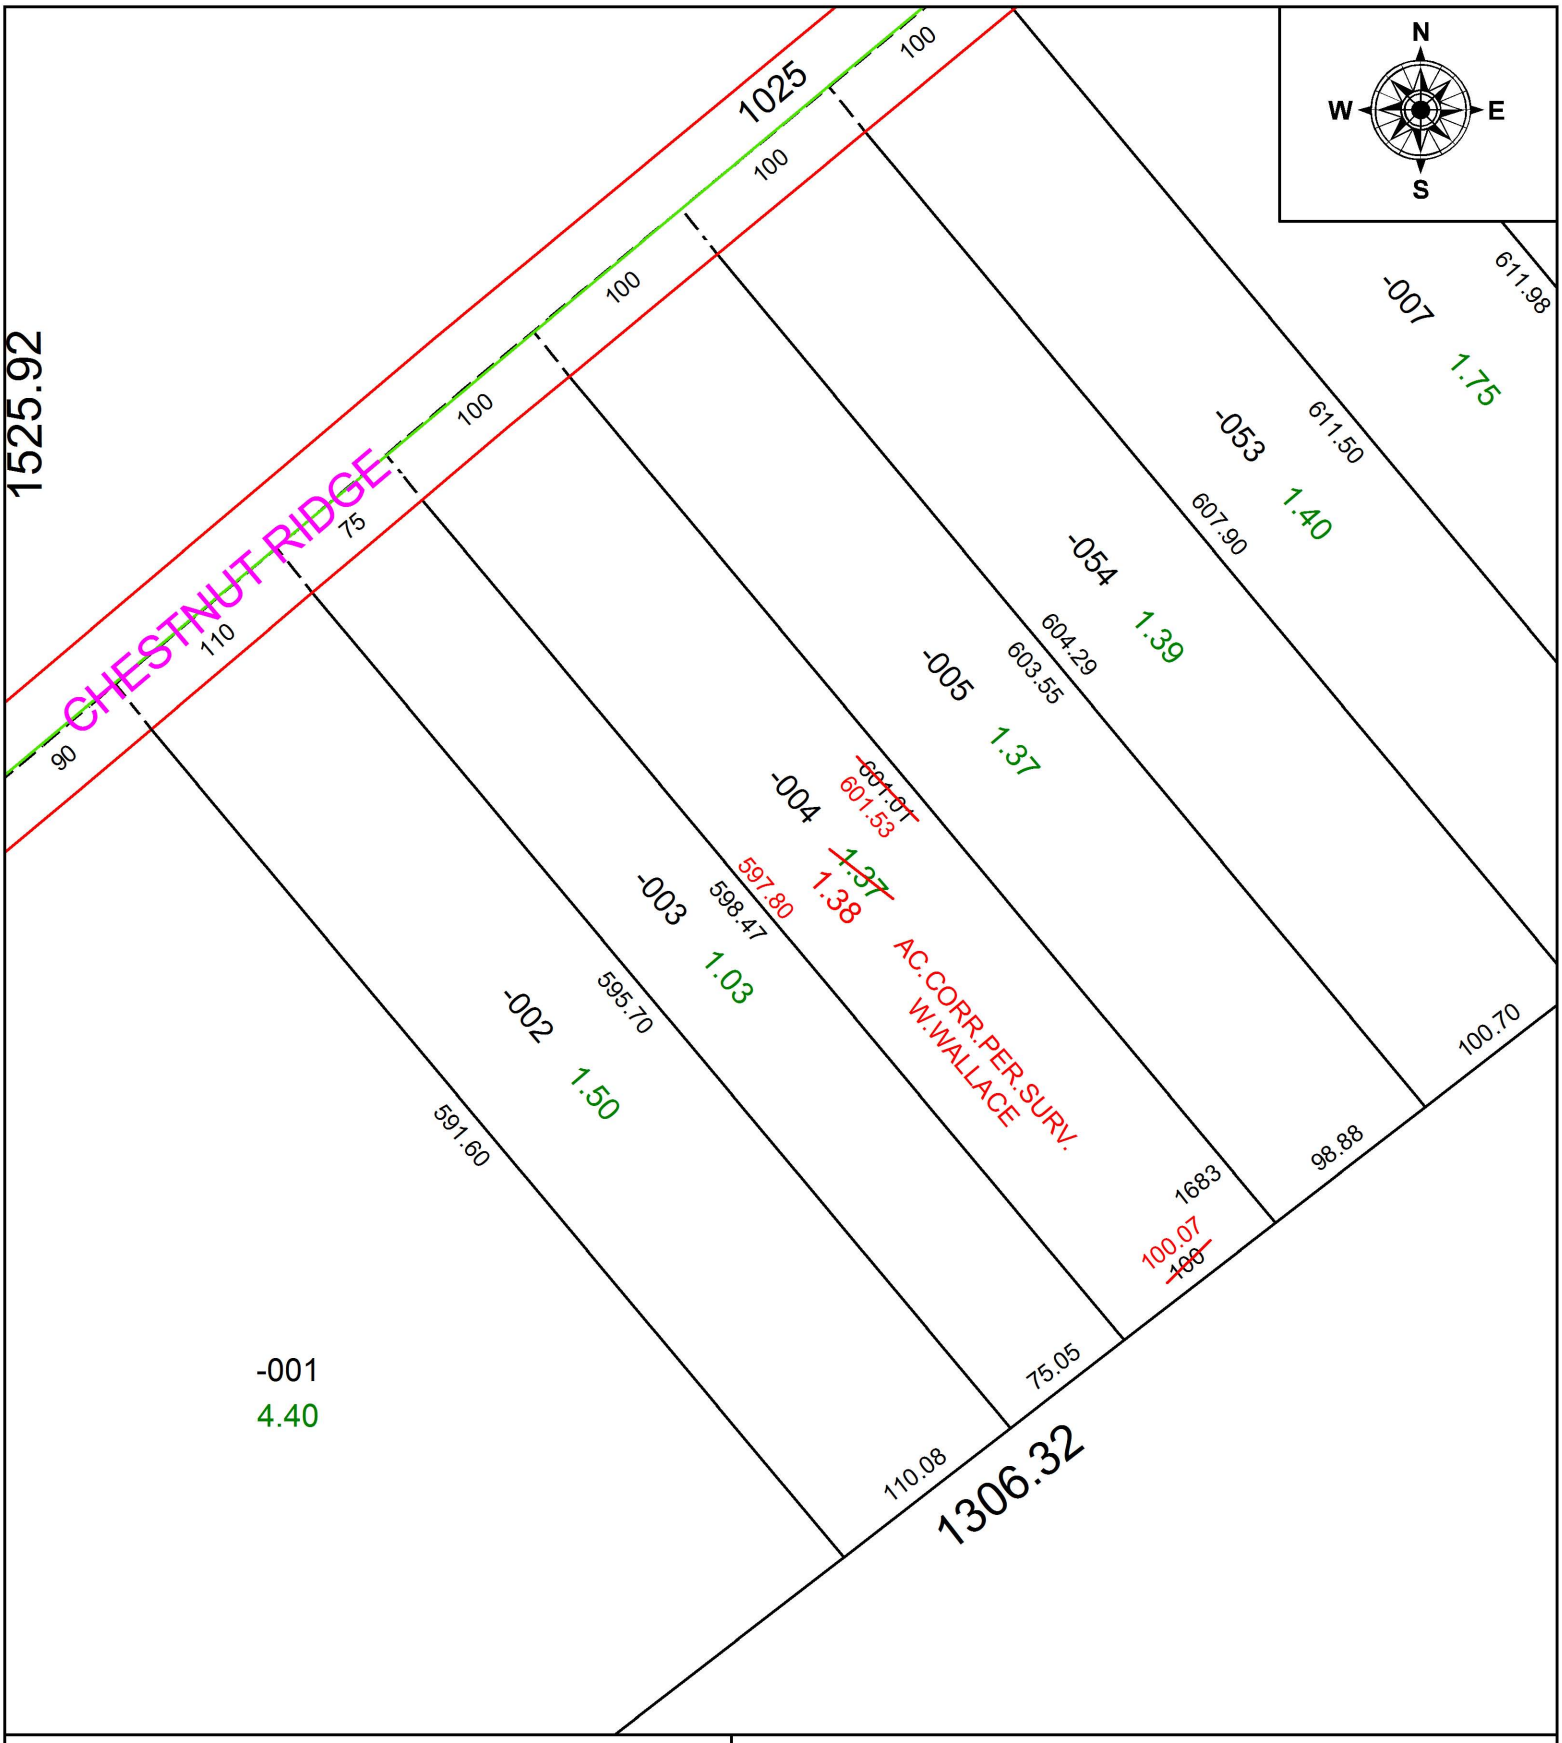

SPLITS/DEEDS PROCESSED
LORAIN COUNTY TAX MAP DEPARTMENT
226 MIDDLE AVE. ELYRIA, OH

SURVEYED BY: WILLIAM R. WALLACE
CLOSURE: 1: 284,001
MAP PAGE(S): 7-00-025
APPOVED BY: RRM **DATE:** 7-26-17
SCALE: 1" = 100 **PRIOR INSTRUMENT:** 20120438307