PARENT PARCEL: 04-00-015-103-101
CHILD PARCEL: 04-00-015-103-103, -104
STARTING POINT: INTERSECTION OF C/L OF S.R.254 AND C/L OF MIDDLETON DR.

17-03713

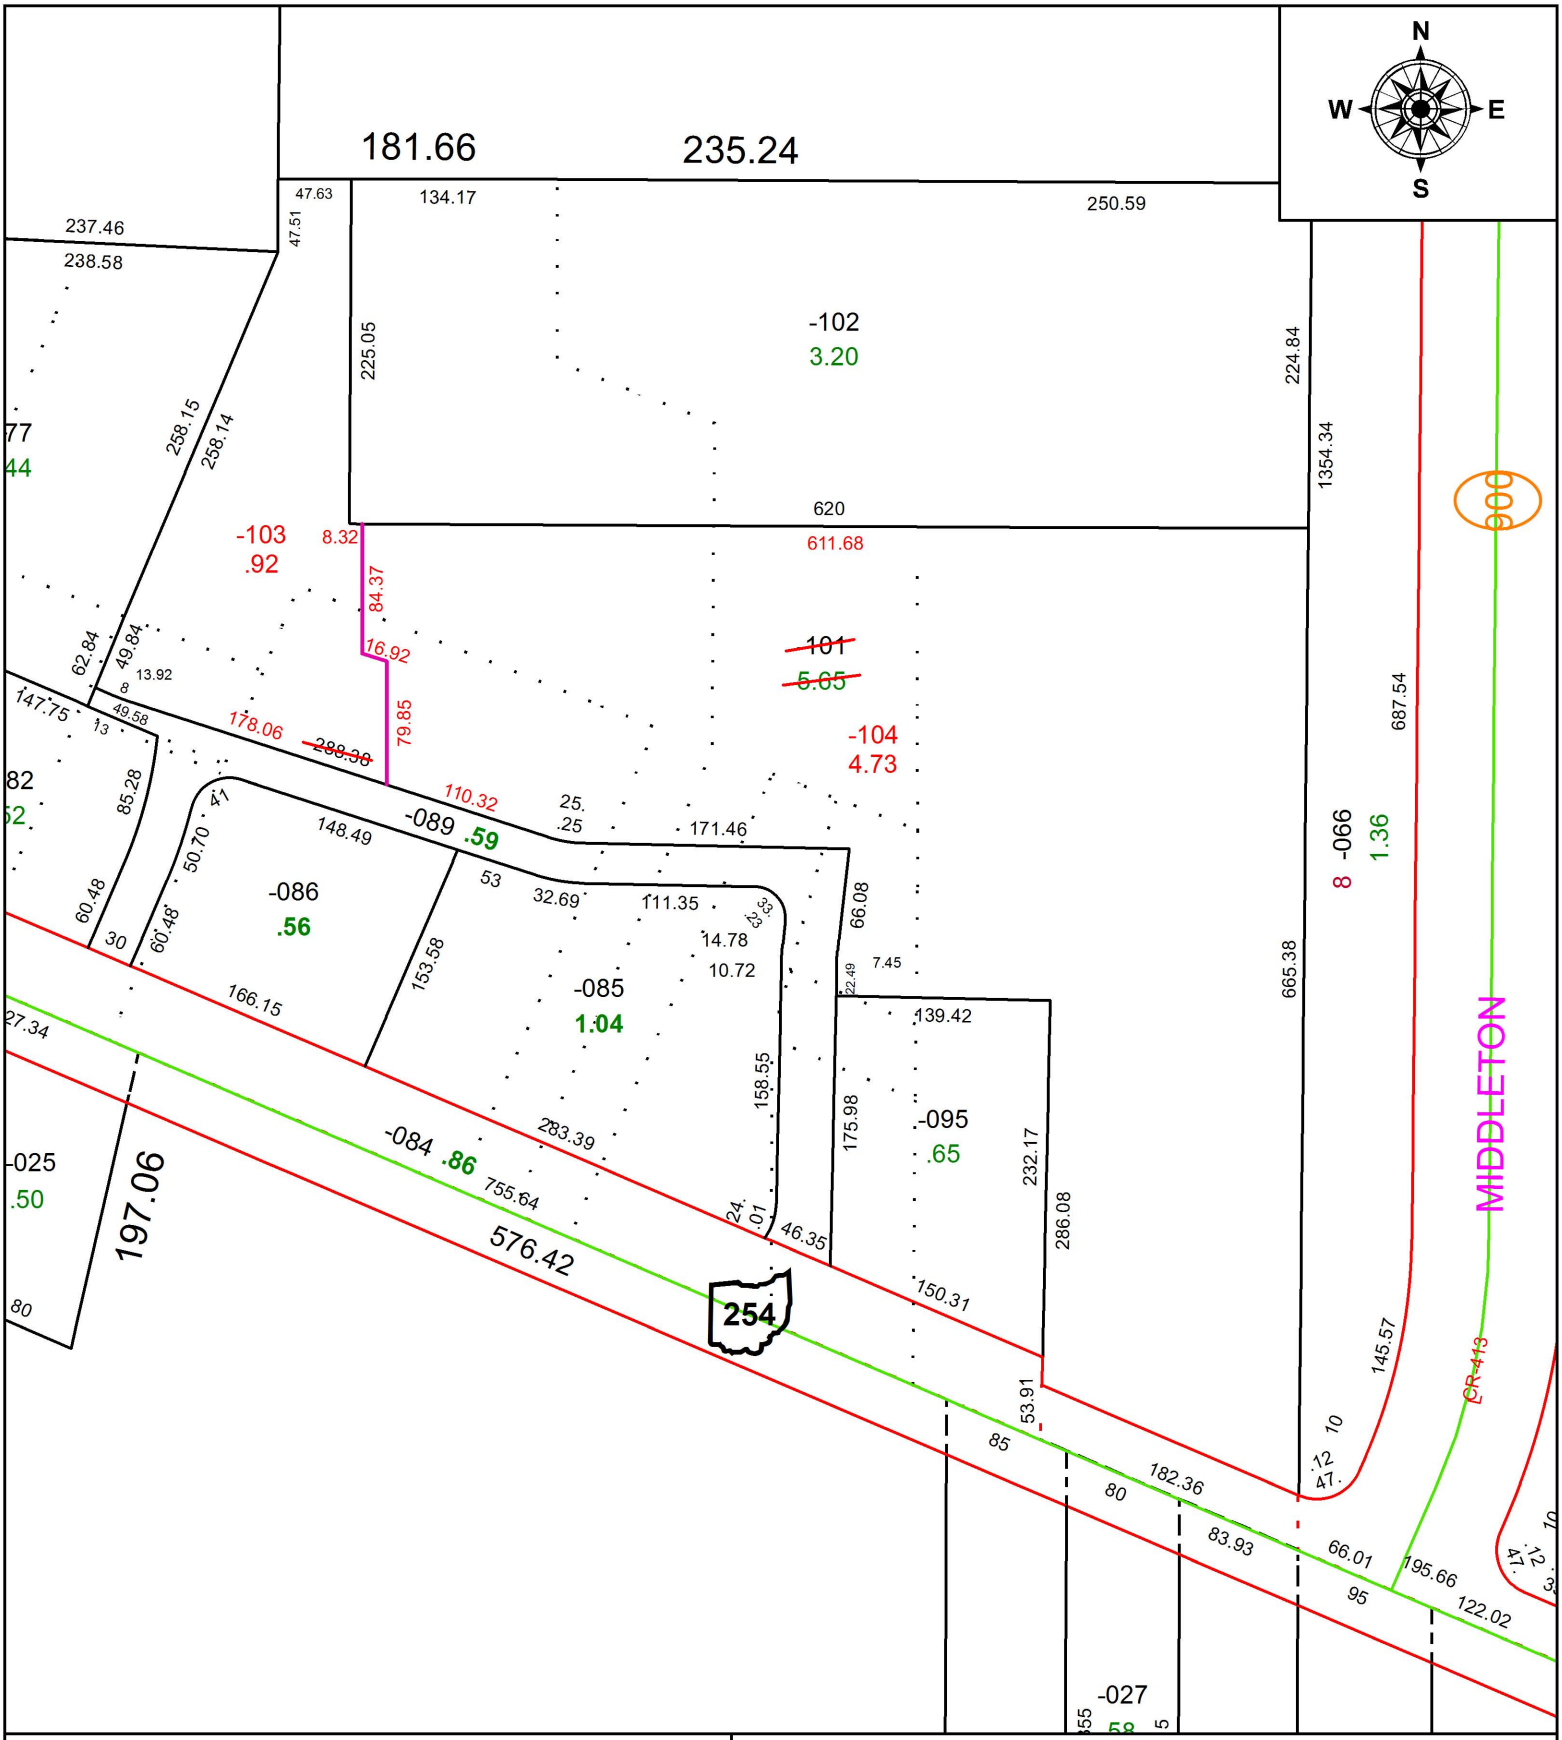

SPLITS/DEEDS PROCESSED
LORAIN COUNTY TAX MAP DEPARTMENT
226 MIDDLE AVE. ELYRIA, OH

SURVEYED BY: MICHAEL P. SPELLACY
CLOSURE: 1: 125,292
MAP PAGE(S): 4-00-015
APPOVED BY: RRM **DATE:** 8-15-17
SCALE: 1" = 125 **PRIOR INSTRUMENT:** 20100358452