PARENT PARCEL: 10-00-004-121-027
CHILD PARCEL: XX-XX-XXX-XXX-XXX
STARTING POINT: NORTHWEST CORNER OF S/L 131 IN LINDALE ALLOT.(VOL.6 PG.42)

17-03717-A

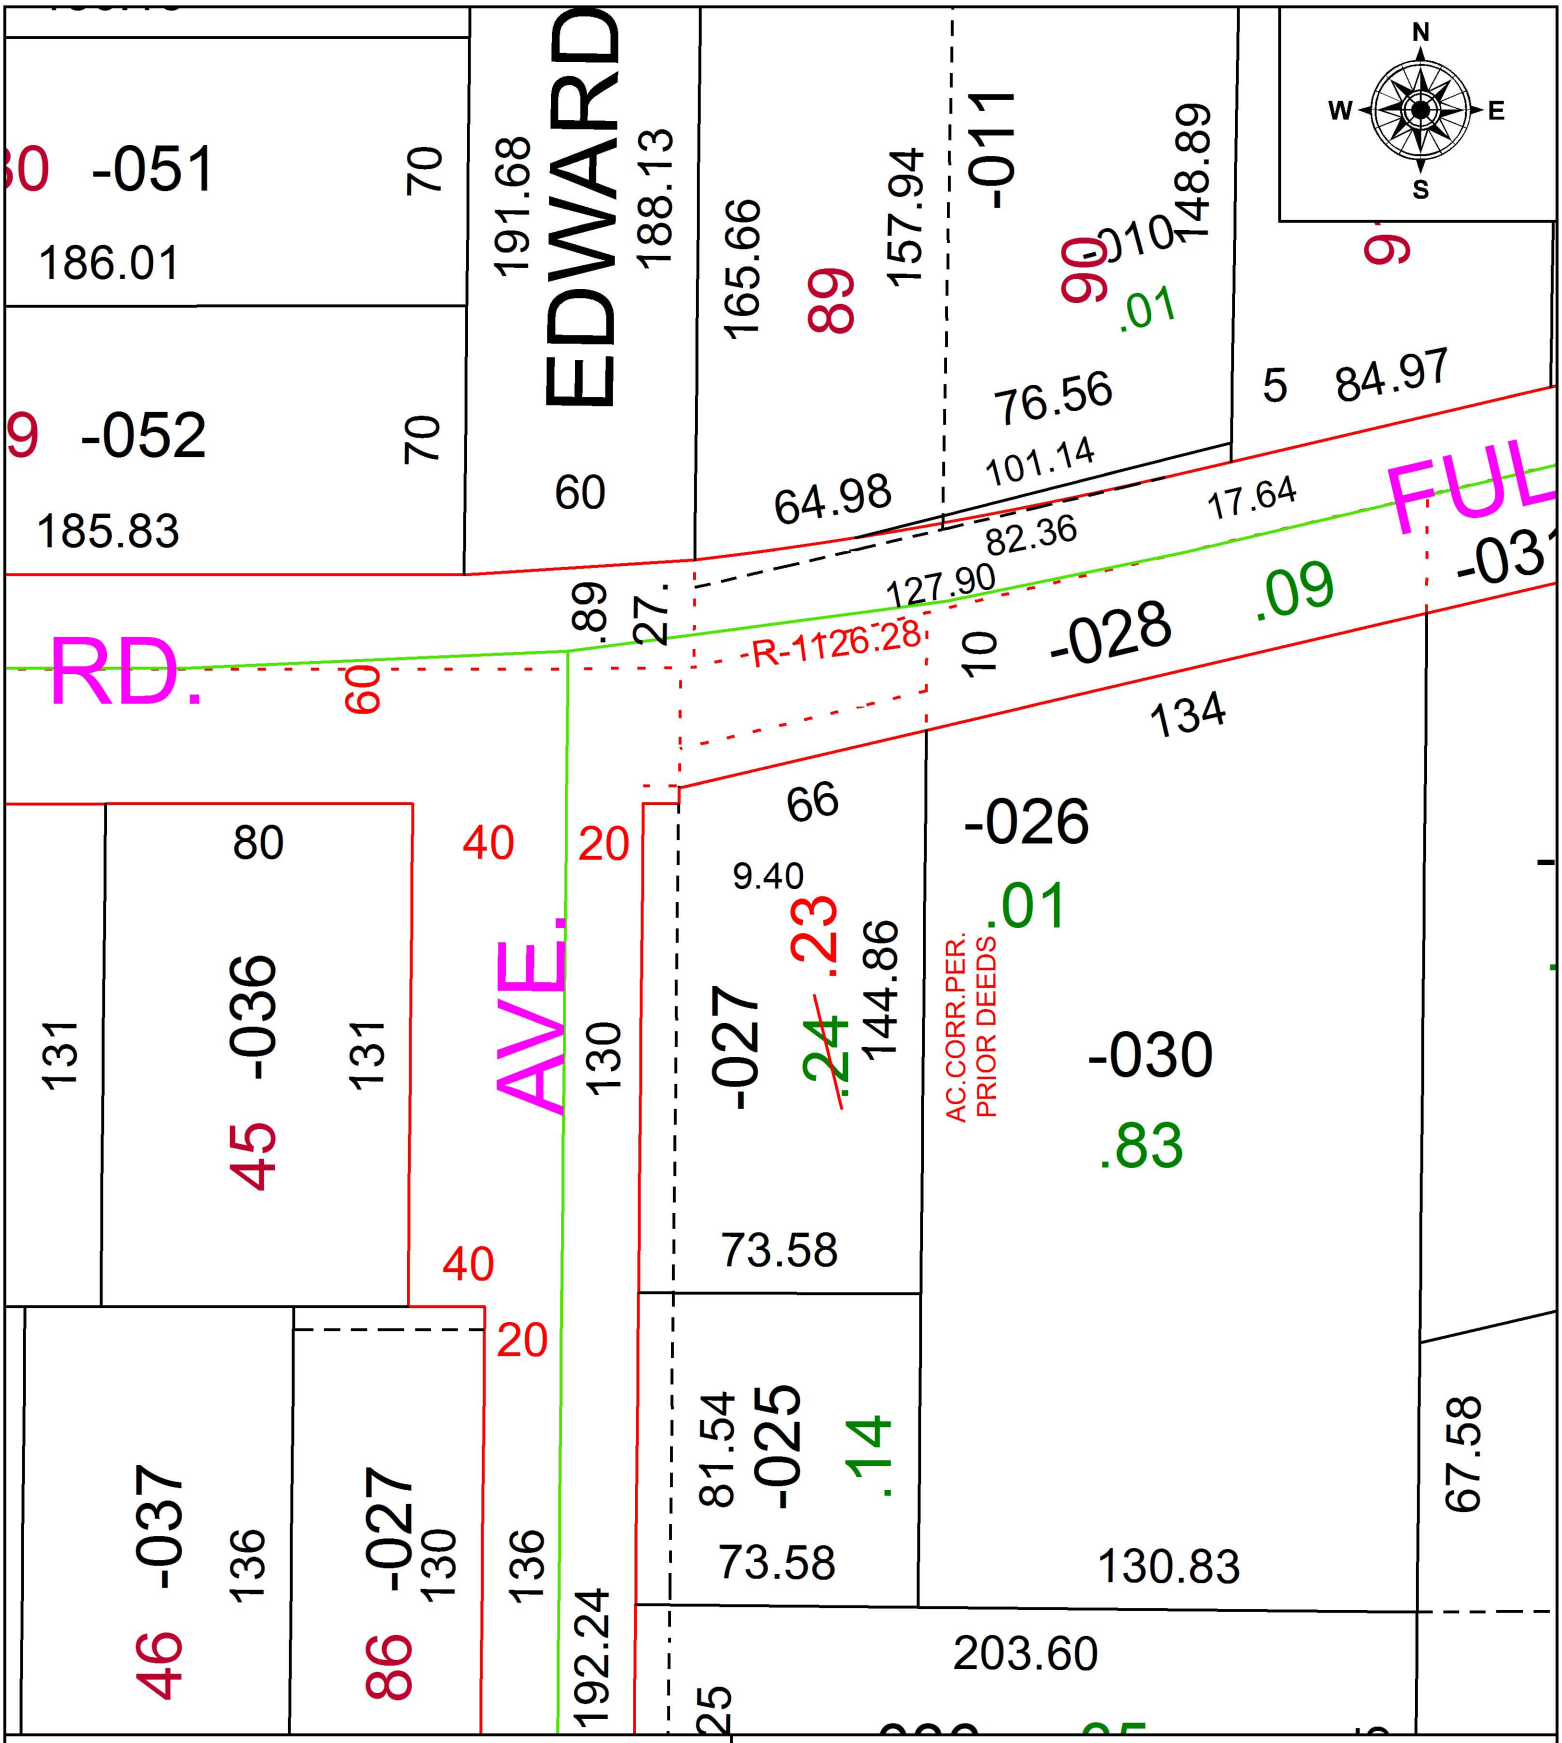

SPLITS/DEEDS PROCESSED
LORAIN COUNTY TAX MAP DEPARTMENT
226 MIDDLE AVE. ELYRIA, OH

SURVEYED BY: N/A
CLOSURE: N/A
MAP PAGE(S): 10-00-004
APPOVED BY: RRM **DATE:** 8-1-17
SCALE: 1" = 50 **PRIOR INSTRUMENT:** 20170629525