PARENT PARCEL: 16-00-013-000-005, -032
CHILD PARCEL: 16-00-013-000-033 THRU -035
STARTING POINT: NORTHWEST CORNER OF O.L.13

17-03717

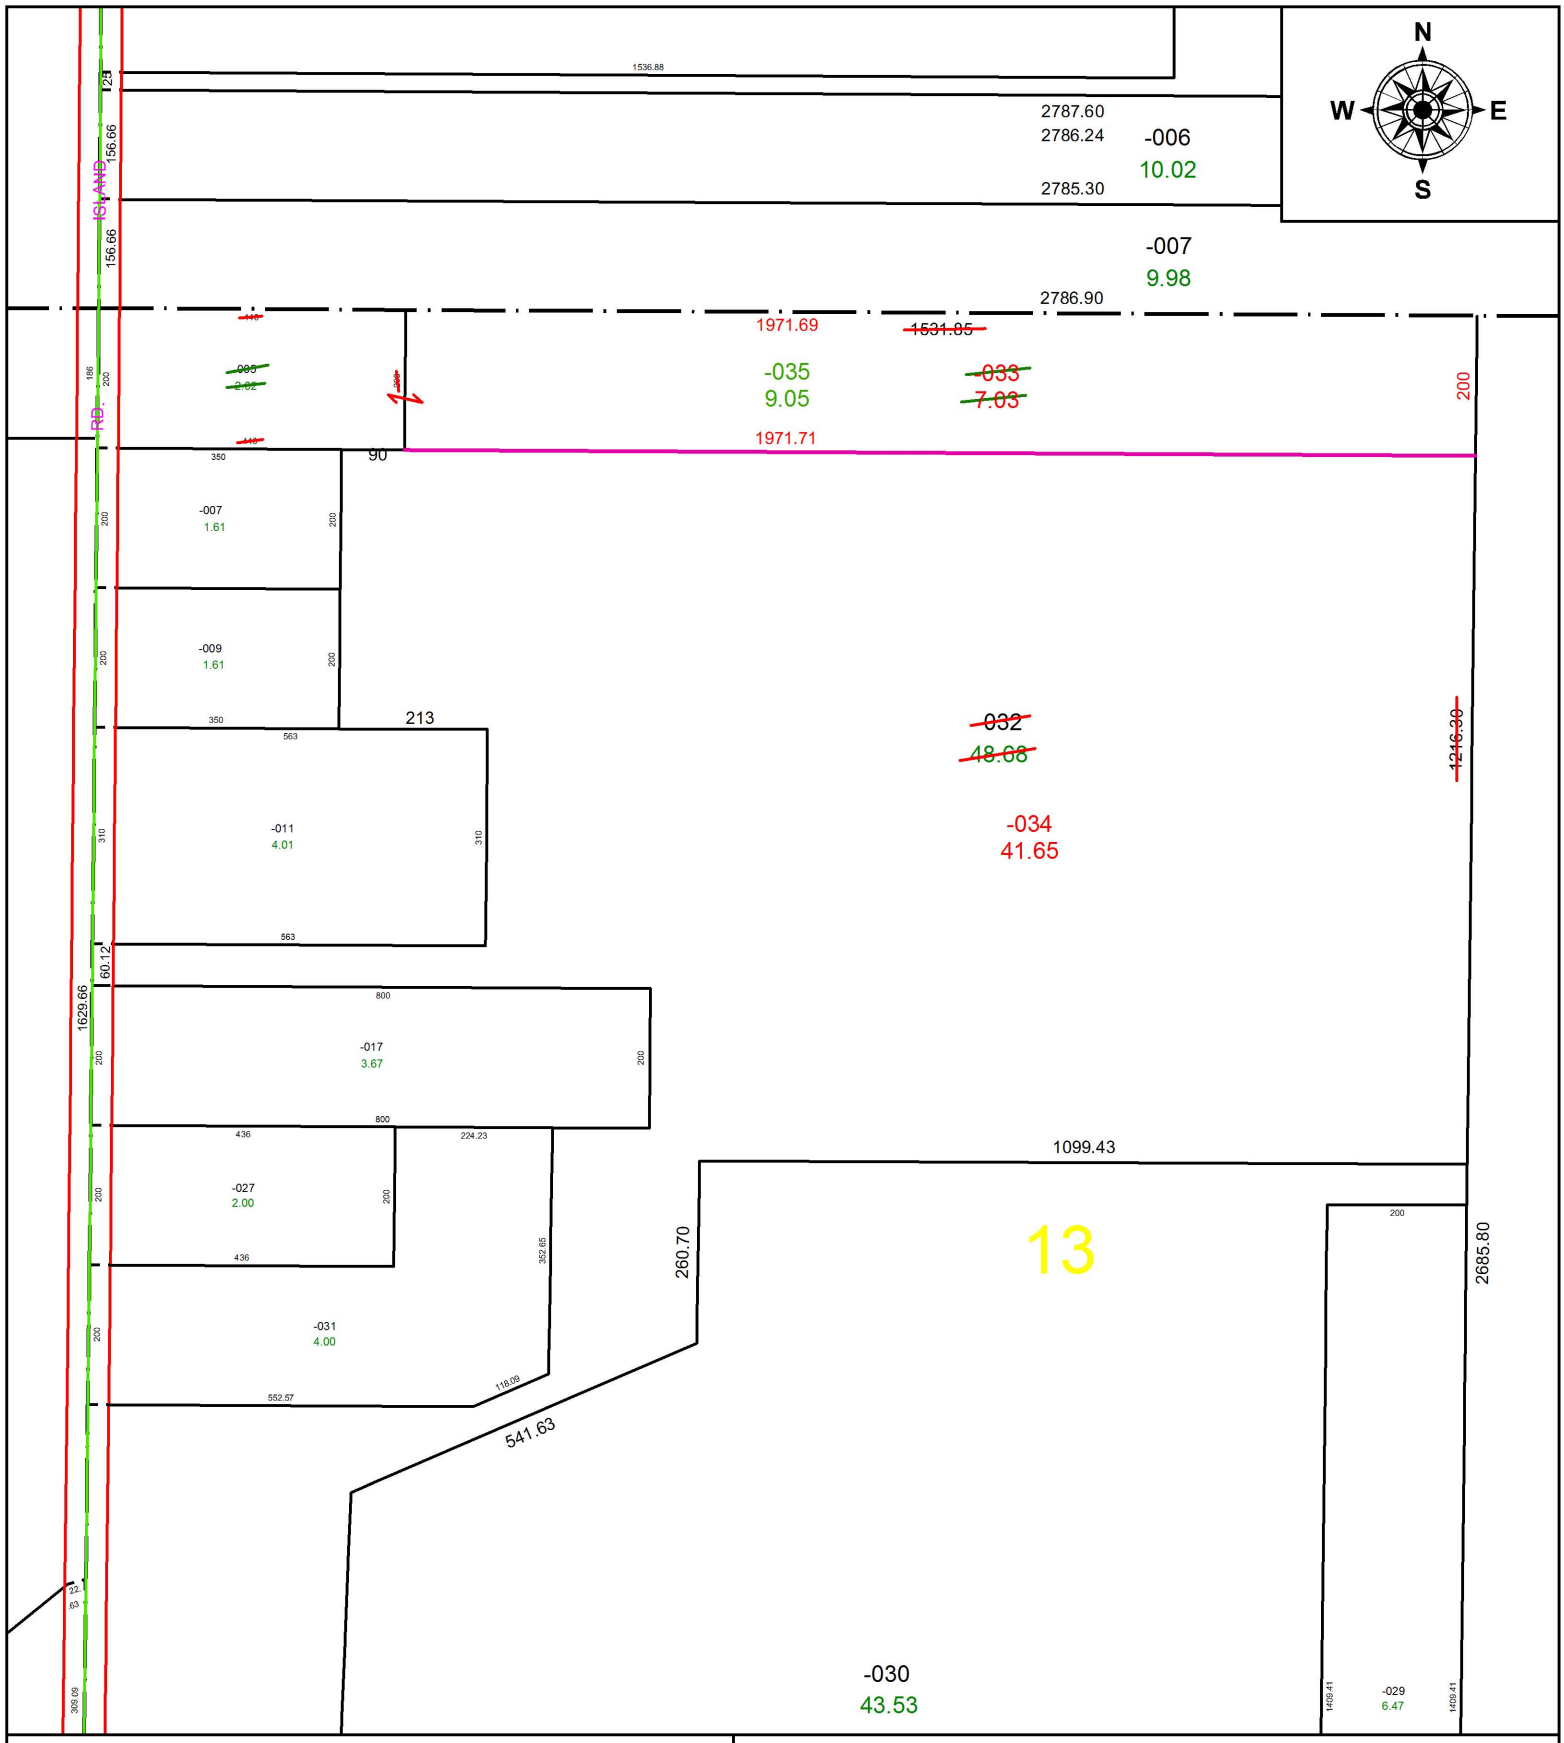

SPLITS/DEEDS PROCESSED

LORAIN COUNTY TAX MAP DEPARTMENT
226 MIDDLE AVE. ELYRIA, OH

SURVEYED BY: TIMOTHY D. HOZALSKI
CLOSURE: 1: 1,500,657
MAP PAGE(S): 16-00-013
APPOVED BY: RRM **DATE:** 8-21-17
SCALE: 1" = 275 **PRIOR INSTRUMENT:** 20140509794