PARENT PARCEL: 11-00-077-000-086, -089

CHILD PARCEL: 11-00-077-000-090 THRU -092

STARTING POINT: INTERSECTION OF C/L OF S. DURKEE RD. AND C/L OF CAPEL RD.

17-03720

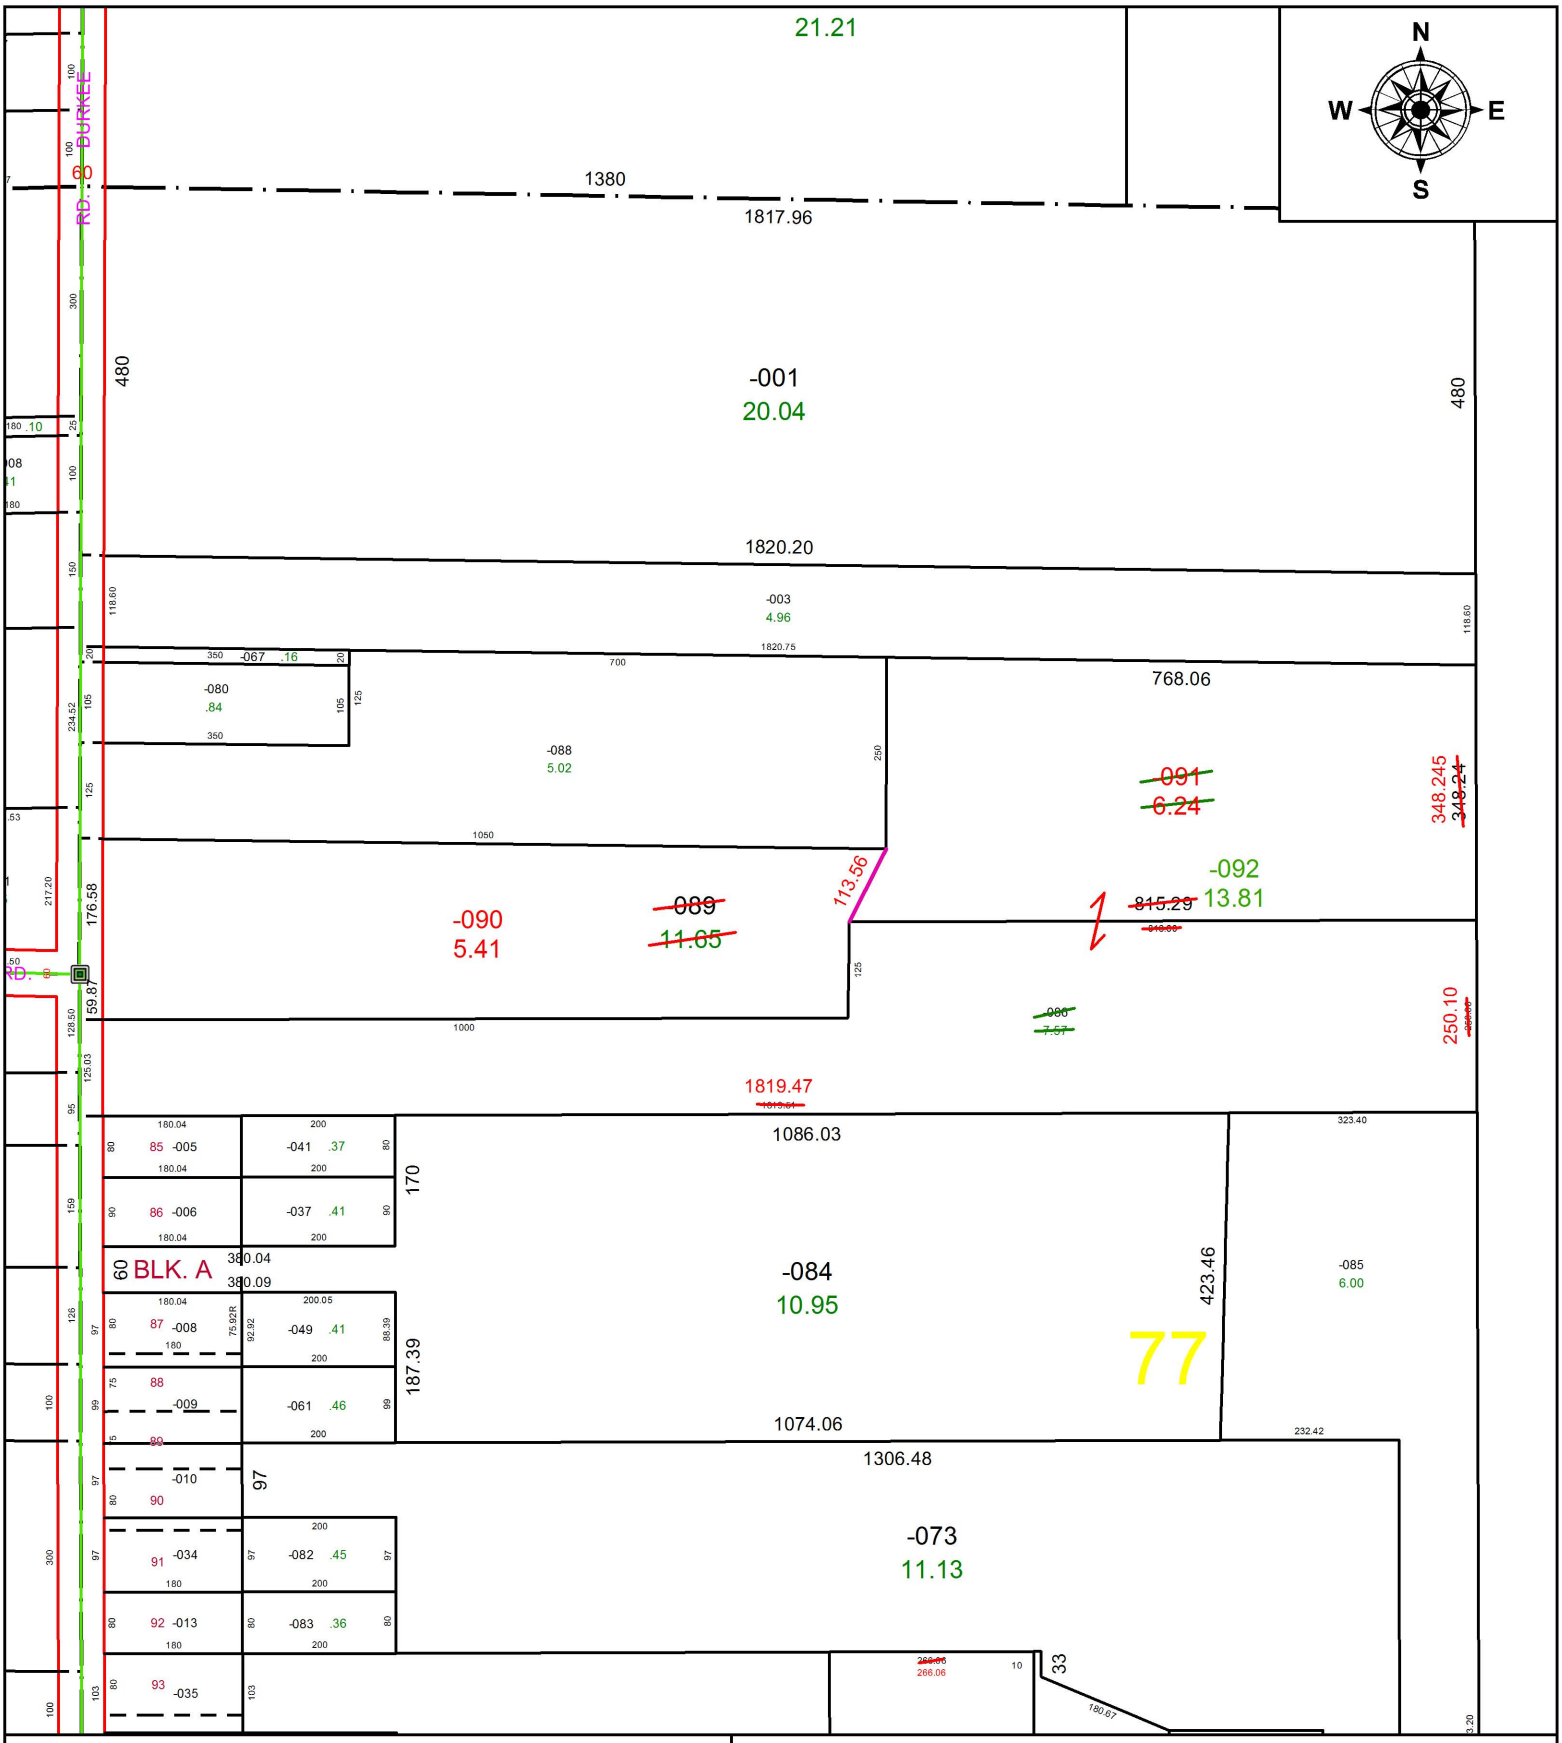

SPLITS/DEEDS PROCESSED

LORAIN COUNTY TAX MAP DEPARTMENT
226 MIDDLE AVE. ELYRIA, OH

SURVEYED BY: RICHARD A. FREDRICKSON
CLOSURE: 1: 1,105,156
MAP PAGE(S): 11-00-077
APPOVED BY: RRM **DATE:** 8-22-17
SCALE: 1" = 250 **PRIOR INSTRUMENT:** 20000669979