PARENT PARCEL: 16-00-091-000-021
CHILD PARCEL: XX-XX-XXX-XXX-XXX
STARTING POINT: NORTHWEST CORNER OF O.L.91

17-03723-X

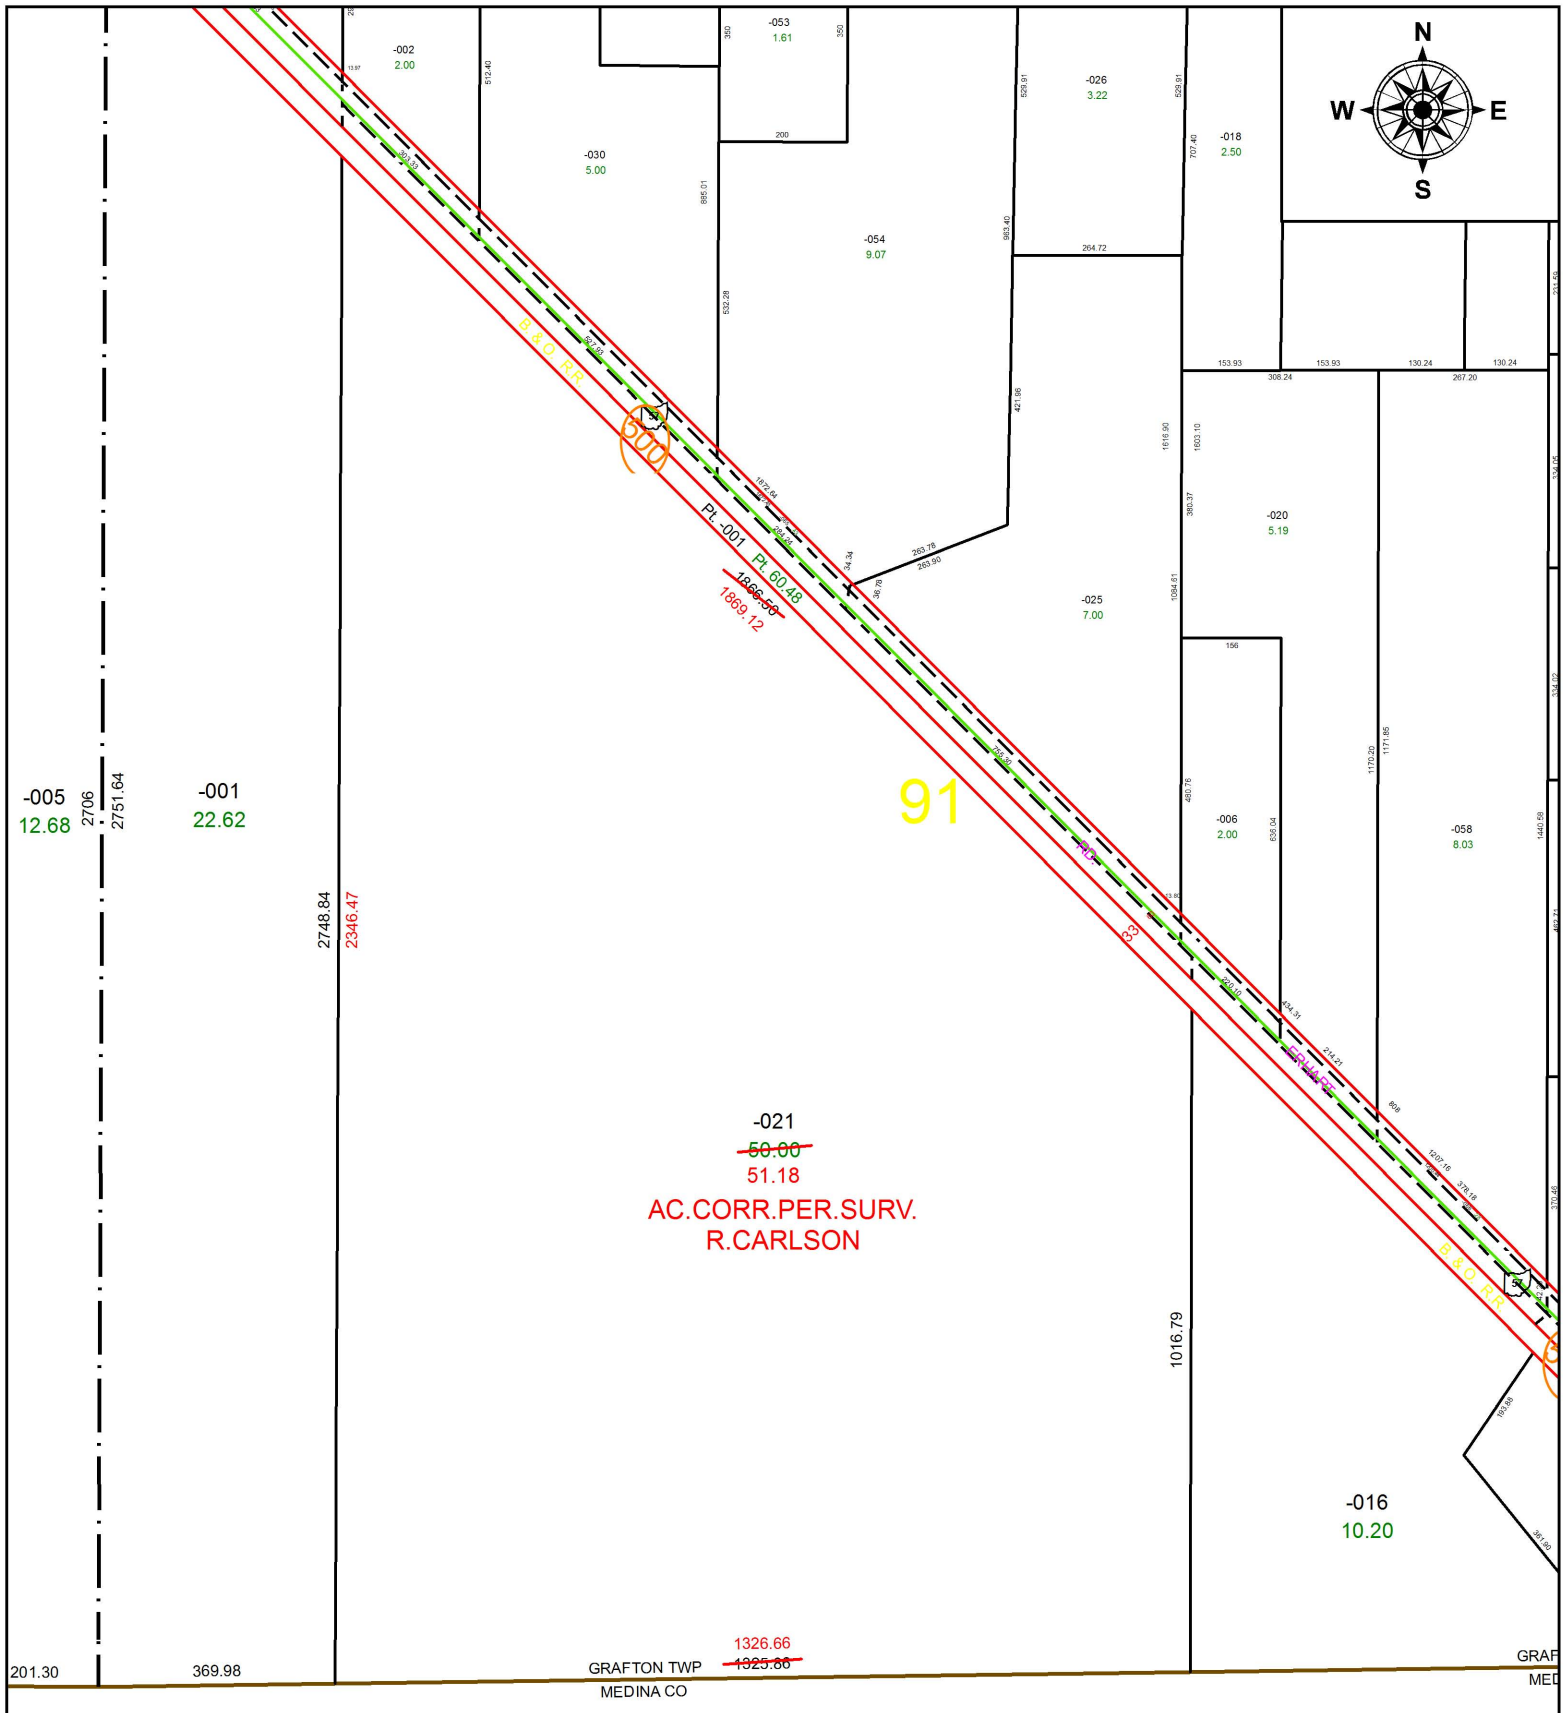

SPLITS/DEEDS PROCESSED

LORAIN COUNTY TAX MAP DEPARTMENT
226 MIDDLE AVE. ELYRIA, OH

SURVEYED BY: RICHARD D. CARLSON
CLOSURE: 1: 1,785,630
MAP PAGE(S): 16-00-091
APPOVED BY: RRM **DATE:** 8-7-17
SCALE: 1" = 300 **PRIOR INSTRUMENT:** 20170623694