PARENT PARCEL: 16-00-025-101-008, -009

CHILD PARCEL: 16-00-025-101-019 THRU -021

STARTING POINT: INTERSECTION OF C/L OF S.R. 57 AND C/L OF S.R.83

17-03723

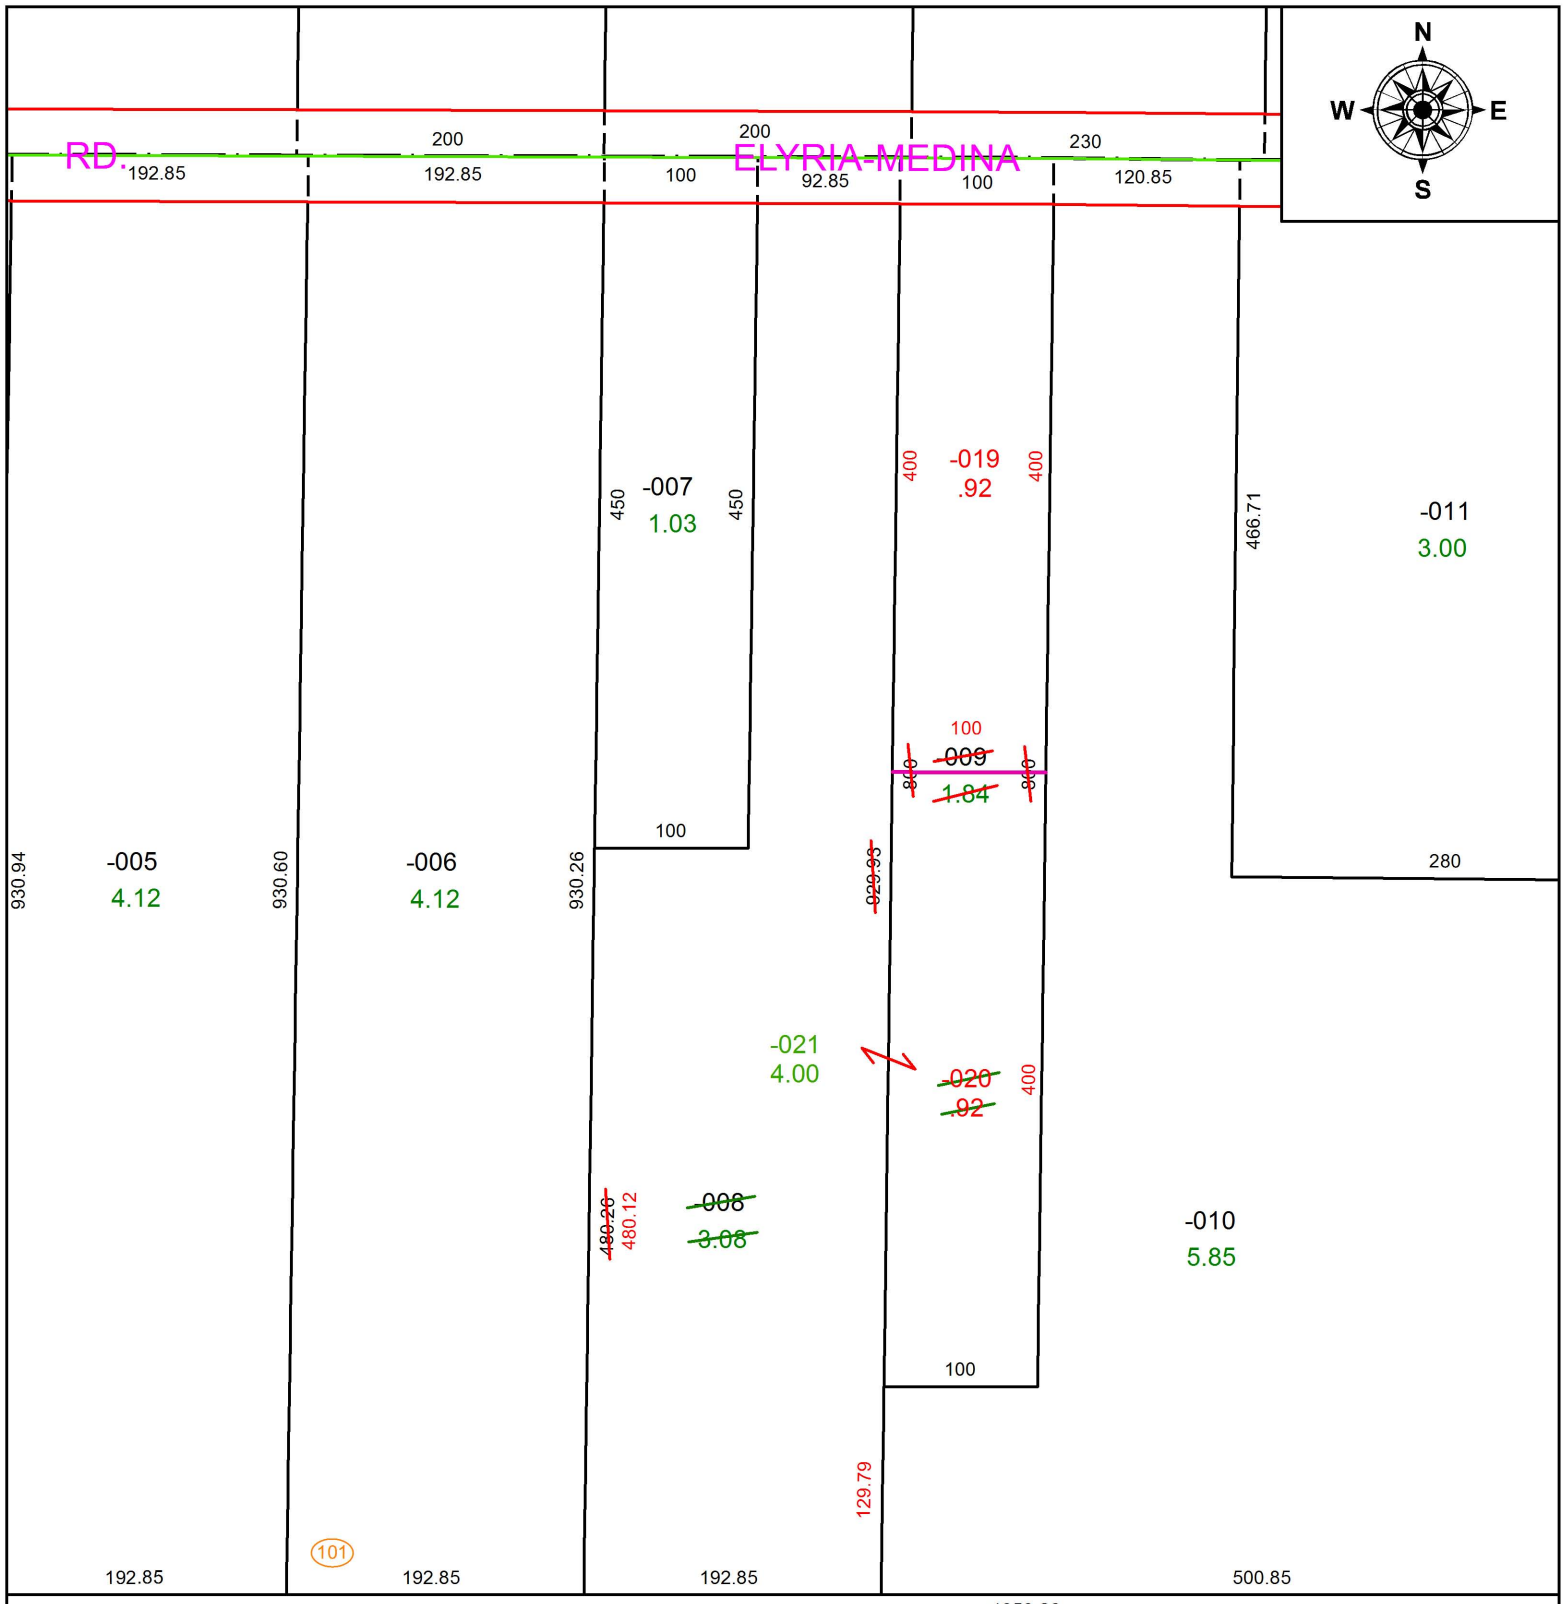

SPLITS/DEEDS PROCESSED

LORAIN COUNTY TAX MAP DEPARTMENT
226 MIDDLE AVE. ELYRIA, OH

SURVEYED BY: THOMAS M. SNEZEK
CLOSURE: 1: 294,848
MAP PAGE(S): 16-00-025
APPOVED BY: RRM **DATE:** 9-11-17
SCALE: 1" = 125 **PRIOR INSTRUMENT:** 19980529829