PARENT PARCEL: 03-00-028-000-008

CHILD PARCEL: 03-00-028-000-010, -011

STARTING POINT: NORTHWEST CORNER OF O.L.28

17-03725

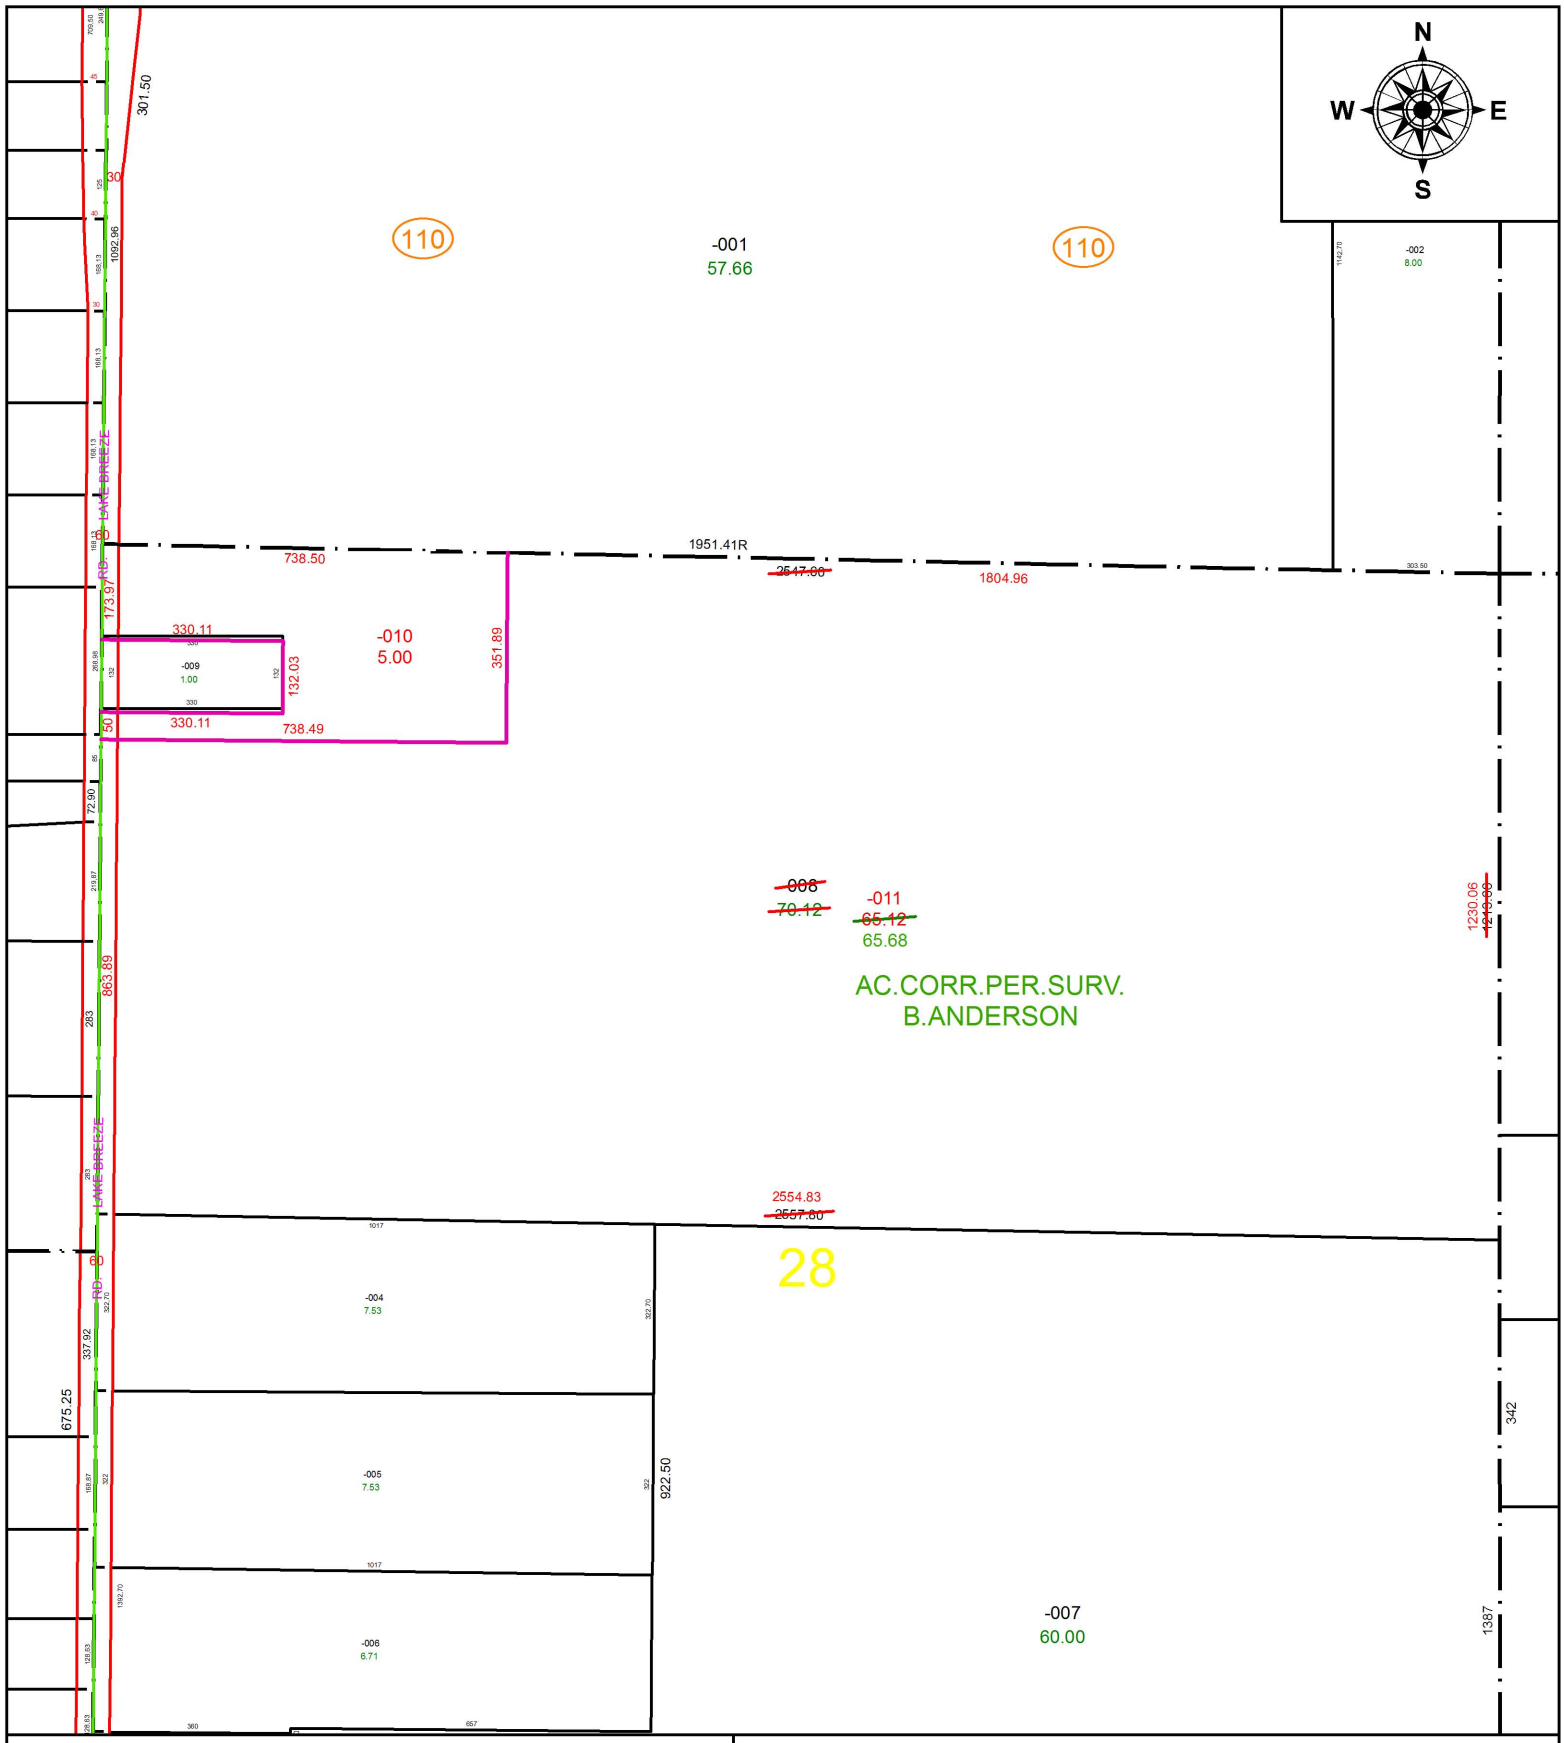

SPLITS/DEEDS PROCESSED

LORAIN COUNTY TAX MAP DEPARTMENT
226 MIDDLE AVE. ELYRIA, OH

SURVEYED BY: BRENT D. ANDERSON
CLOSURE: 1: 699.060
MAP PAGE(S): 3-00-028
APPOVED BY: RRM **DATE:** 9-14-17
SCALE: 1" = 350 **PRIOR INSTRUMENT:** 20110376526