PARENT PARCEL: 16-00-033-000-011

CHILD PARCEL: 16-00-033-000-019, -020

STARTING POINT: SOUTHWEST CORNER OF O.L.33

17-03726

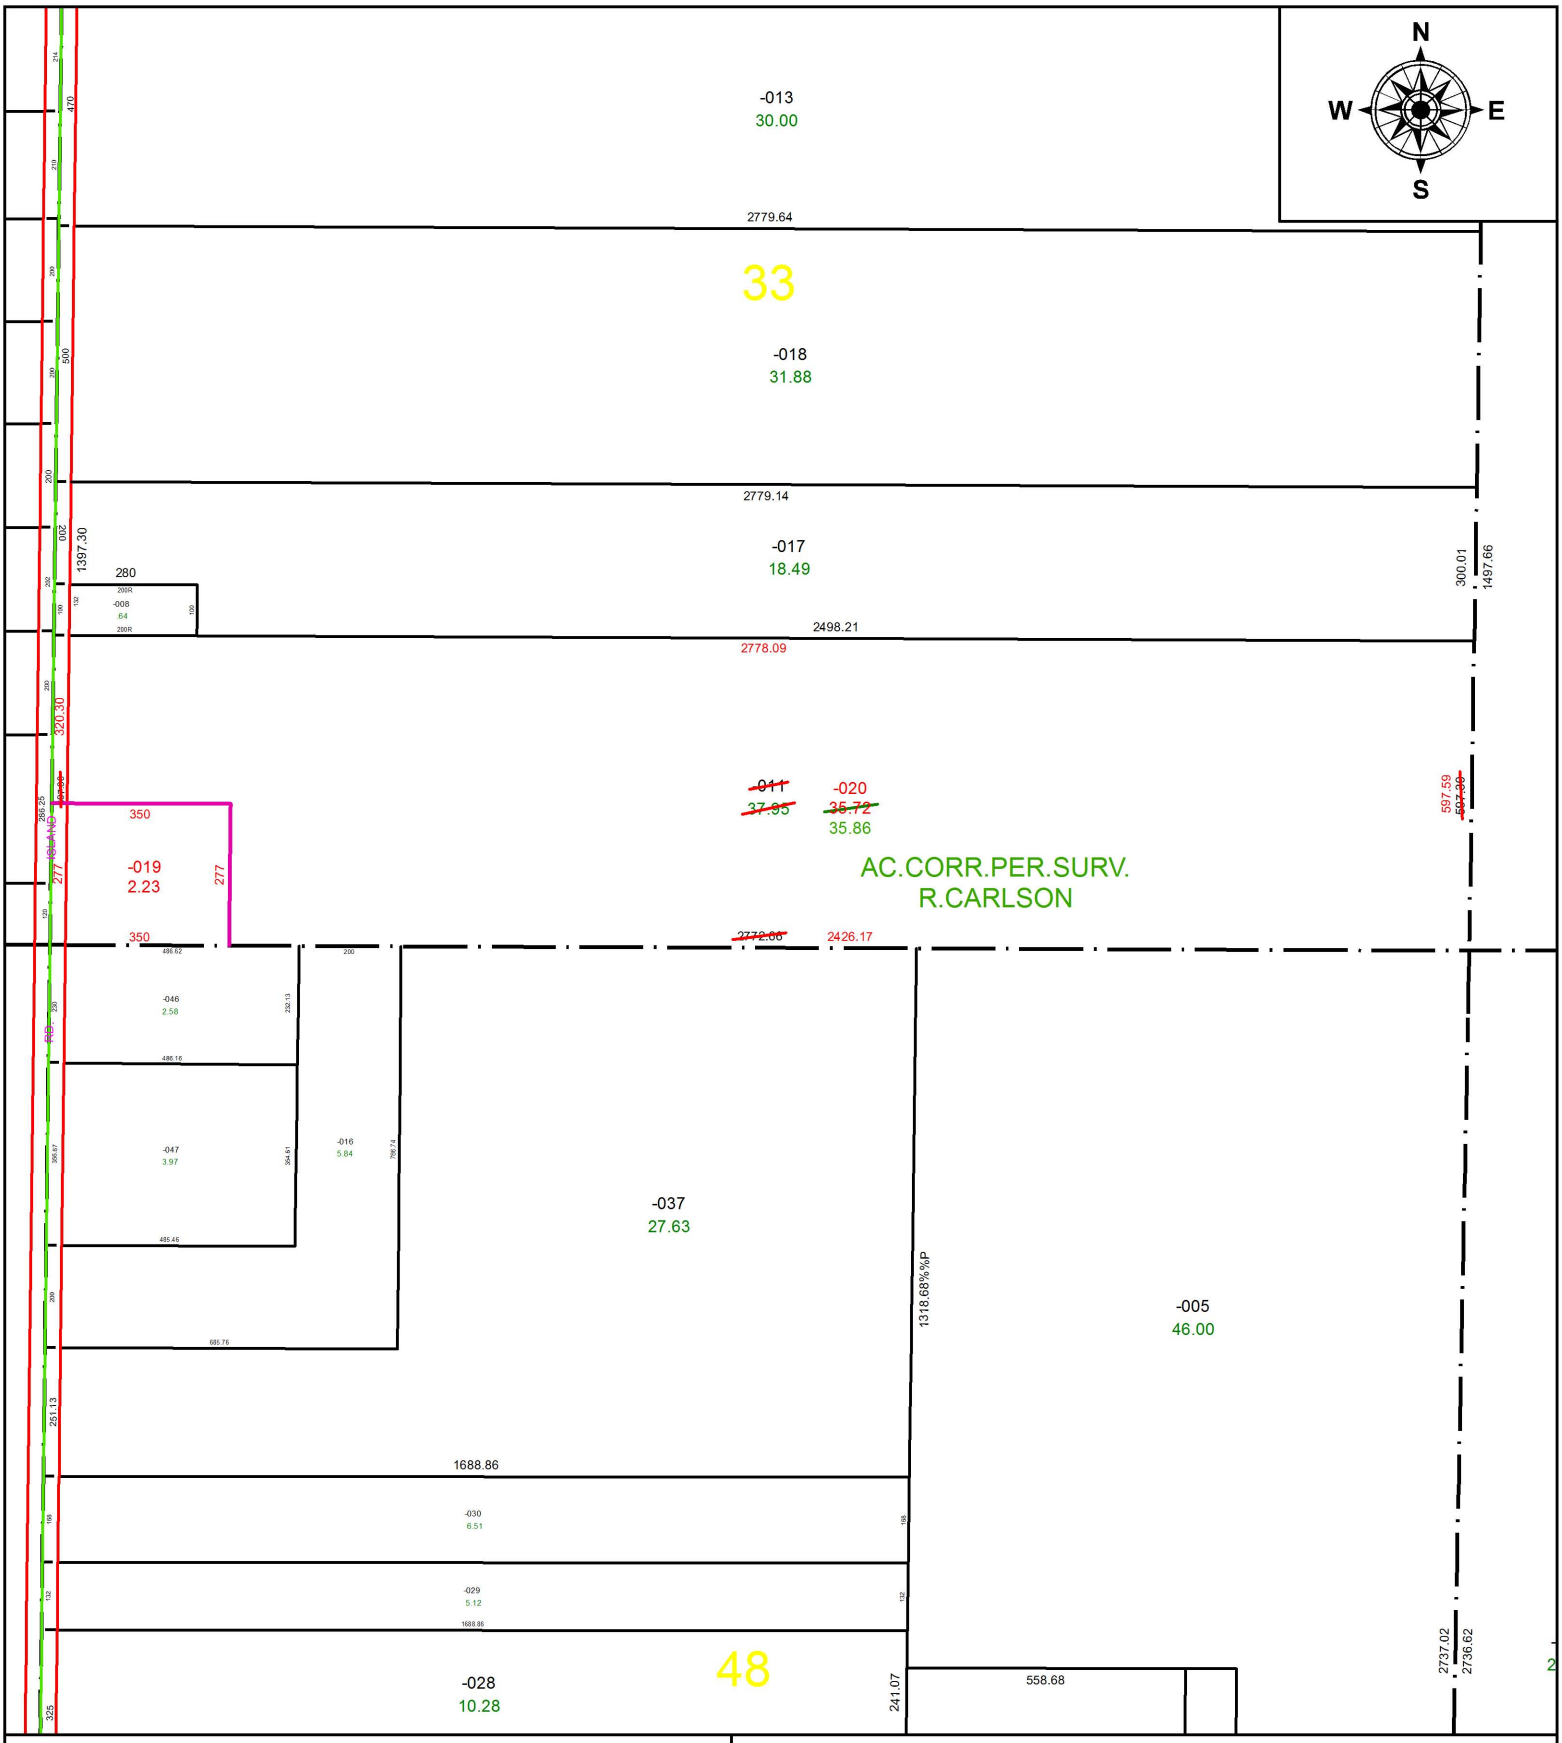

SPLITS/DEEDS PROCESSED

LORAIN COUNTY TAX MAP DEPARTMENT
226 MIDDLE AVE. ELYRIA, OH

SURVEYED BY: RICHARD D. CARLSON
CLOSURE: 1: 1,167,124
MAP PAGE(S): 16-00-033
APPOVED BY: RRM **DATE:** 9-15-17
SCALE: 1" = 375 **PRIOR INSTRUMENT:** 19980549550