PARENT PARCEL: 11-00-049-000-016

CHILD PARCEL: XX-XX-XXX-XXX-XXX

STARTING POINT: INTERSECTION OF C/L OF S.R.83 AND C/L OF COOLEY RD.

17-03728-D

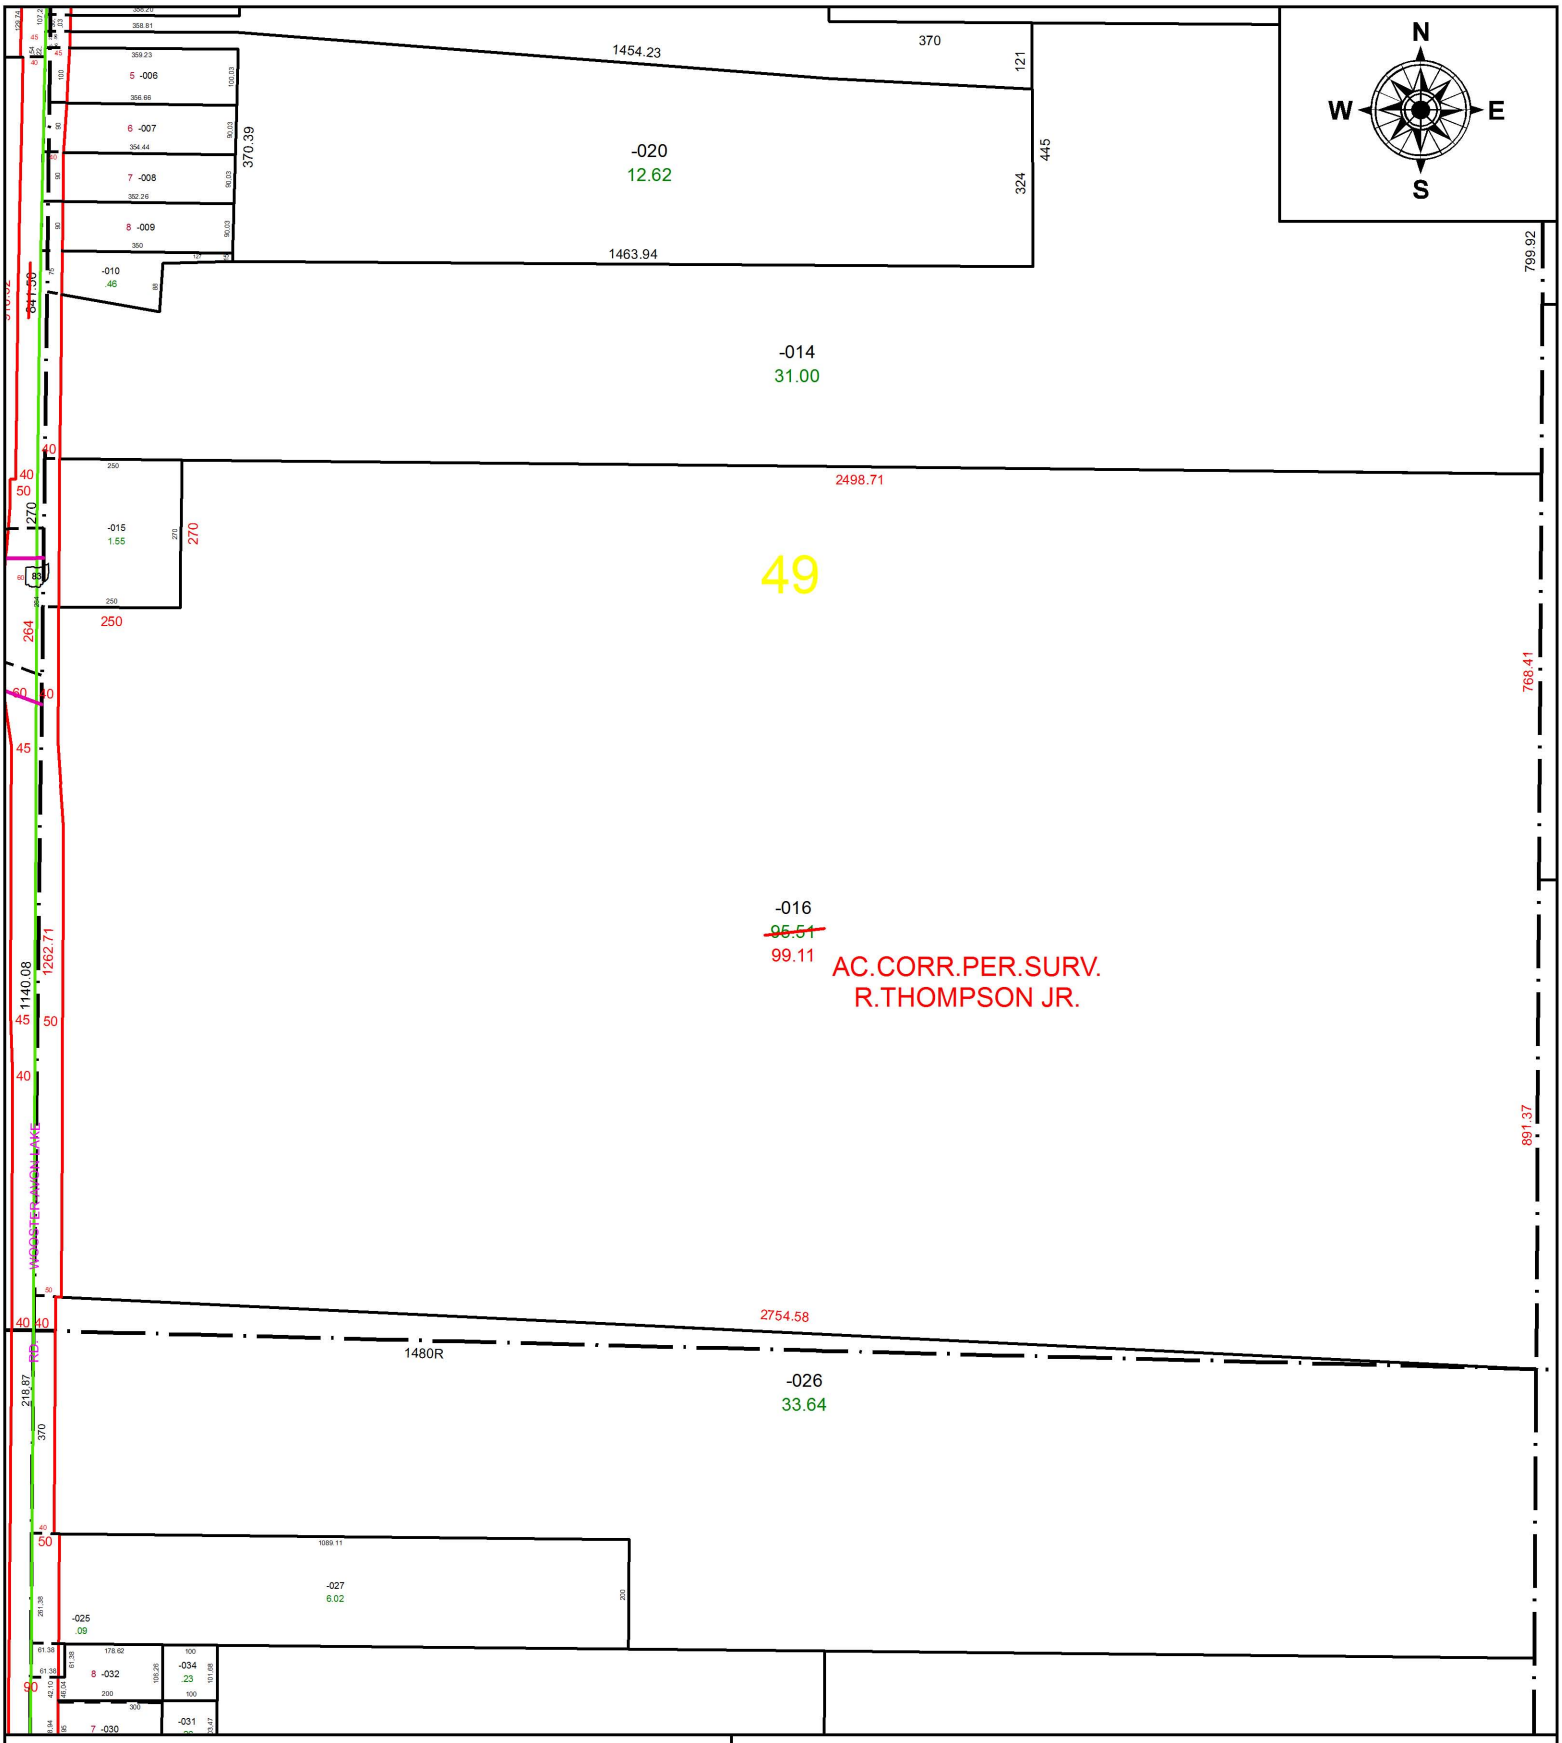

SPLITS/DEEDS PROCESSED

LORAIN COUNTY TAX MAP DEPARTMENT
226 MIDDLE AVE. ELYRIA, OH

SURVEYED BY: RICHARD A. THOMPSON JR.
CLOSURE: 1: 1,308,092
MAP PAGE(S): 11-00-049
APPOVED BY: RRM **DATE:** 8-16-17
SCALE: 1" = 350 **PRIOR INSTRUMENT:** 20030899688