PARENT PARCEL: 01-00-063-000-052

CHILD PARCEL: 01-00-063-000-057, -058

STARTING POINT: INTERSECTION OF C/L OF NORTH RIDGE RD. AND C/L OF GORE ORPHANAGE RD.

17-03729

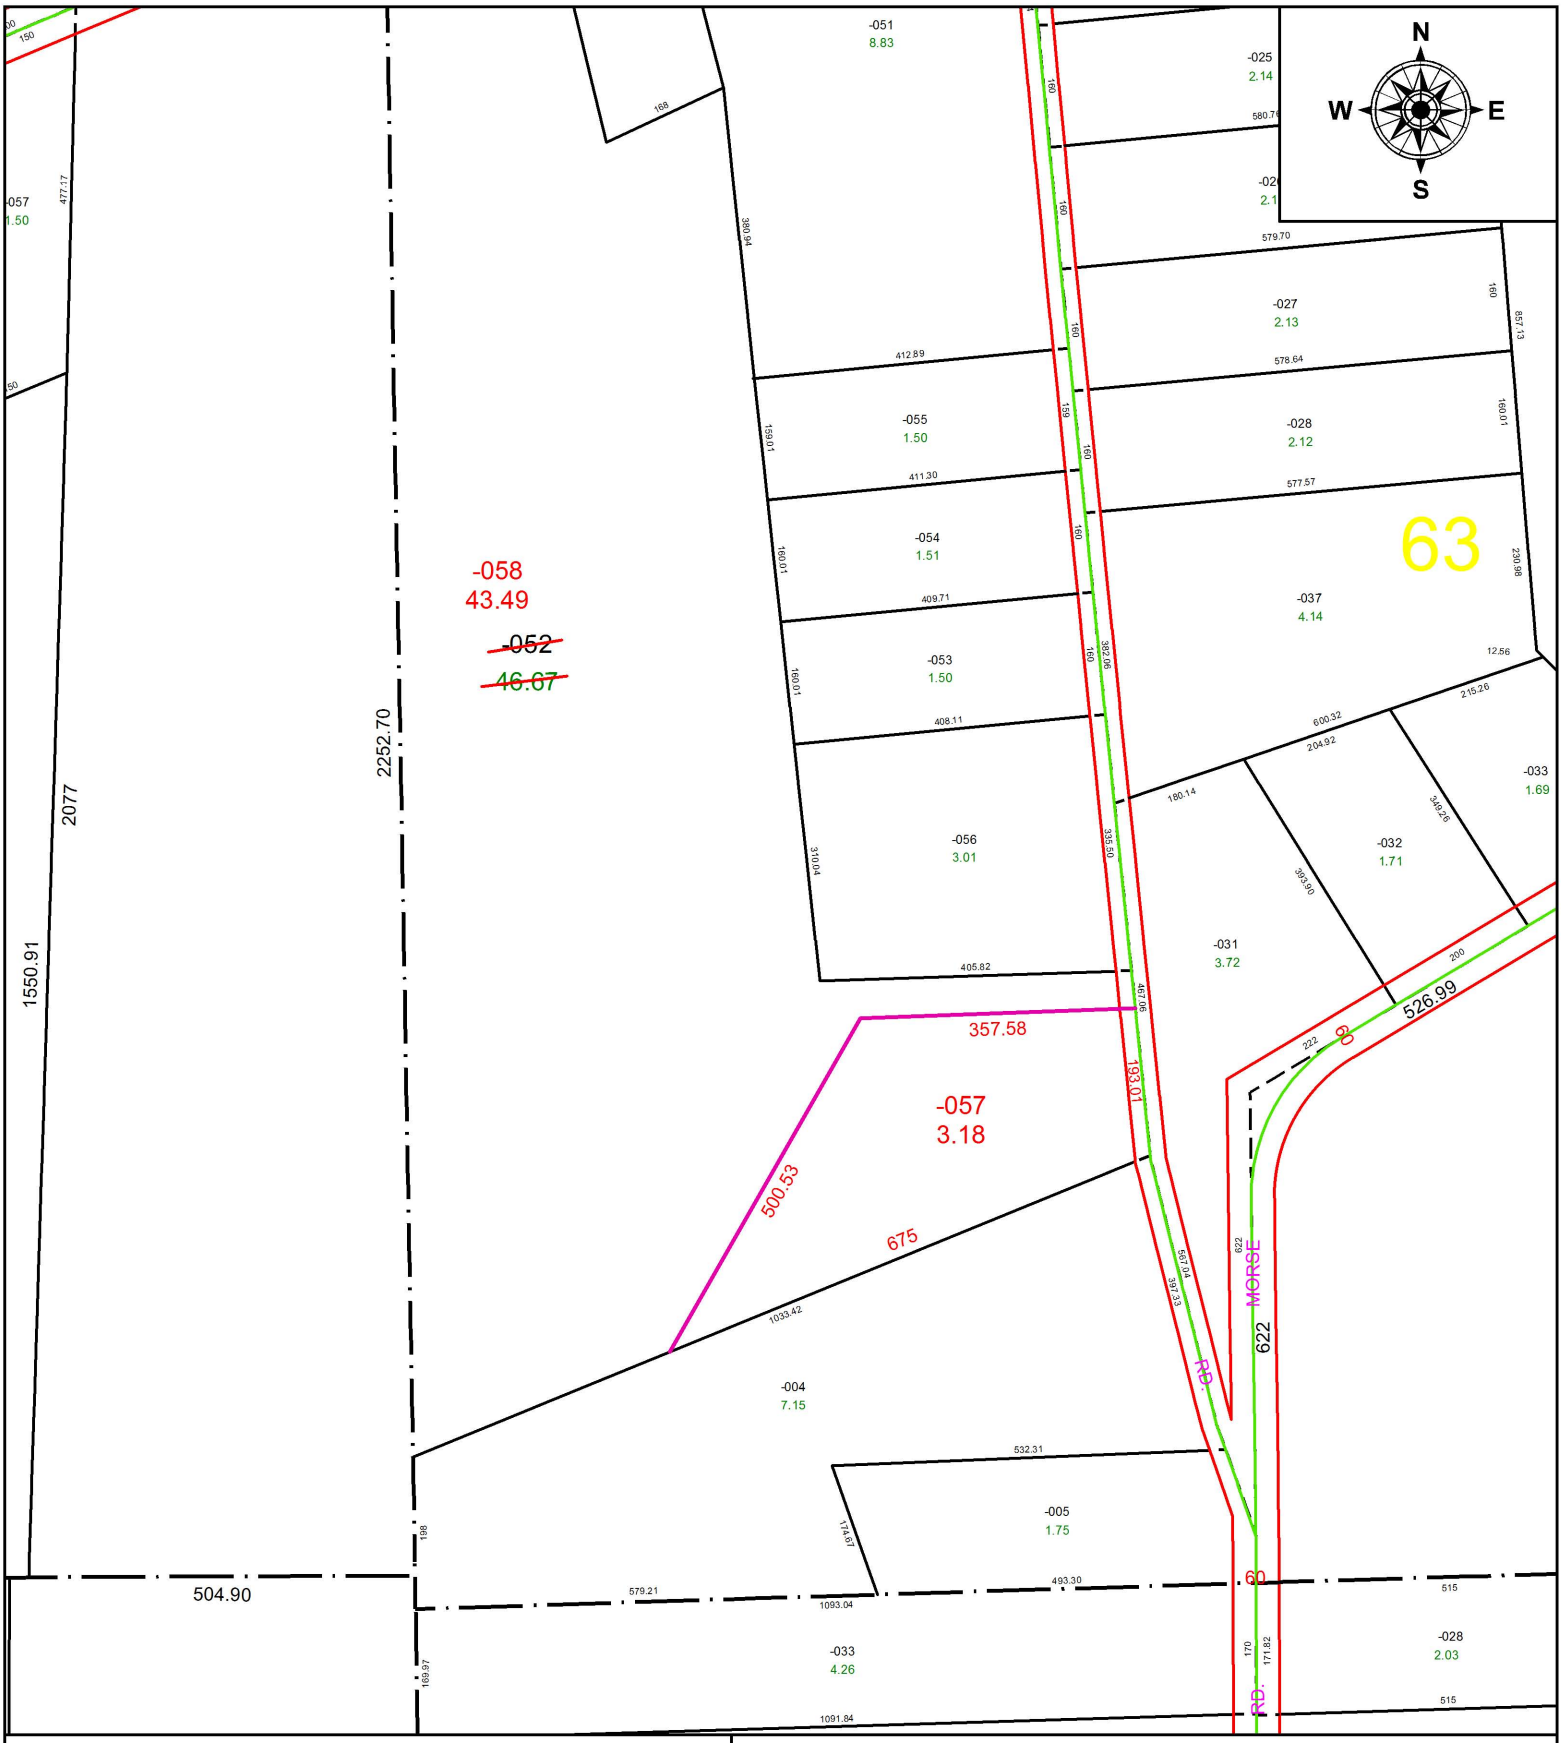

SPLITS/DEEDS PROCESSED

LORAIN COUNTY TAX MAP DEPARTMENT
226 MIDDLE AVE. ELYRIA, OH

SURVEYED BY: THOMAS A. SIMON

CLOSURE: 1: 917,152

MAP PAGE(S): 1-00-063

APPOVED BY: RRM **DATE:** 9-28-17

SCALE: 1" = 250 **PRIOR INSTRUMENT:** 20050102932