PARENT PARCEL: 07-00-043-103-094

CHILD PARCEL: 07-00-043-103-099, -100

STARTING POINT: SOUTHWEST CORNER OF AVALON ESTATES NO.1

17-03731

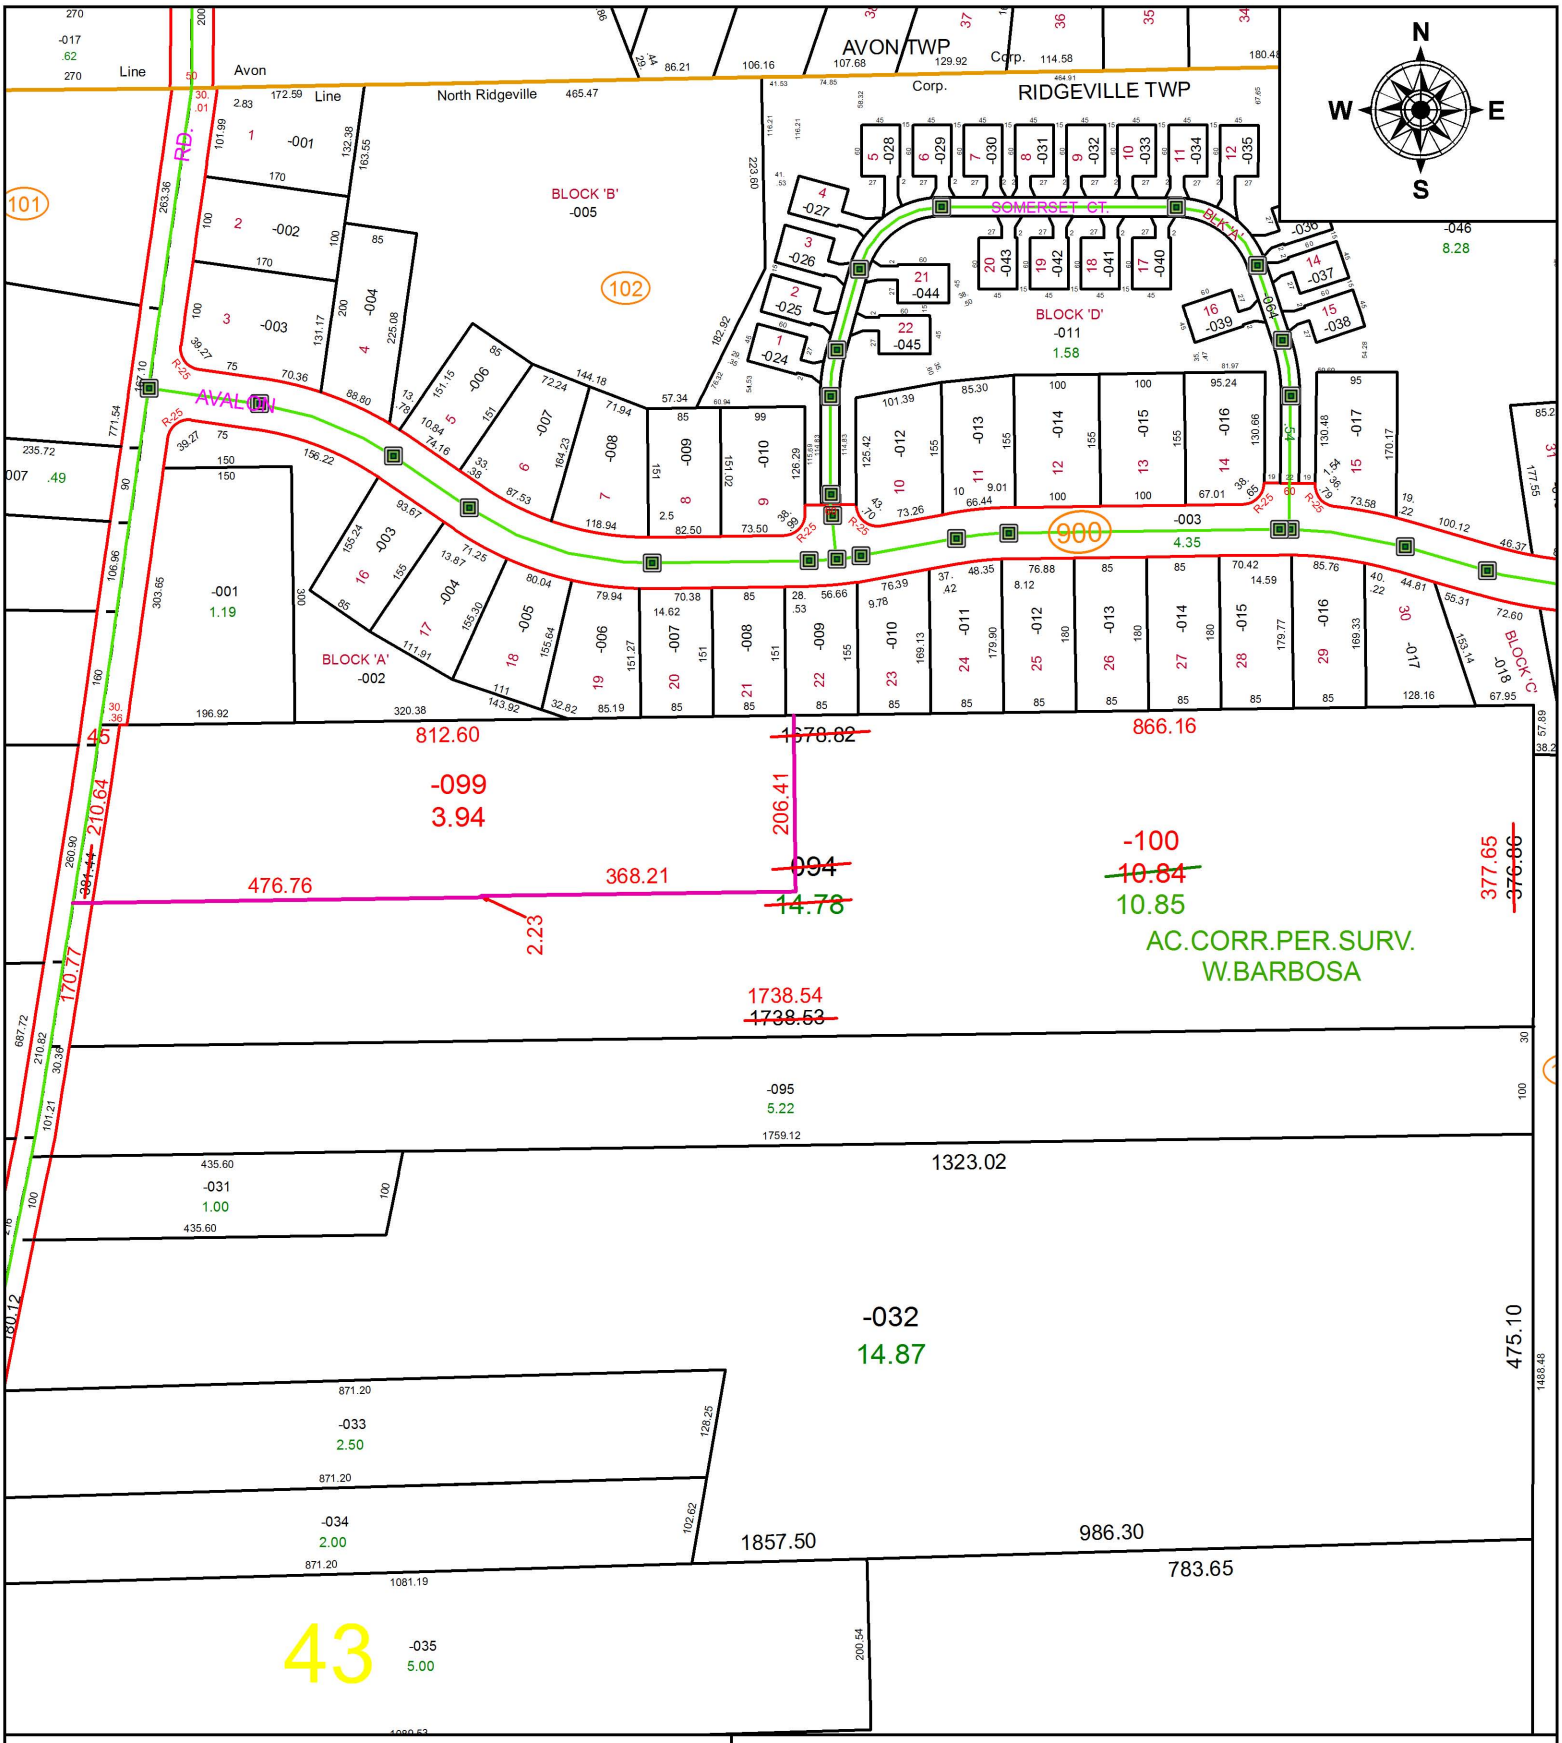

SPLITS/DEEDS PROCESSED

LORAIN COUNTY TAX MAP DEPARTMENT
226 MIDDLE AVE. ELYRIA, OH

SURVEYED BY: WILFREDO BARBOSA
CLOSURE: 1: 512,473
MAP PAGE(S): 7-00-043
APPOVED BY: RRM **DATE:** 10-2-17
SCALE: 1" = 225 **PRIOR INSTRUMENT:** 20170628662