PARENT PARCEL: 10-00-022-000-008, -022
CHILD PARCEL: 10-00-022-000-132
STARTING POINT: INTERSECTION OF C/L OF WHITEHEAD RD. AND C/L OF PARSONS RD.

17-03734-C

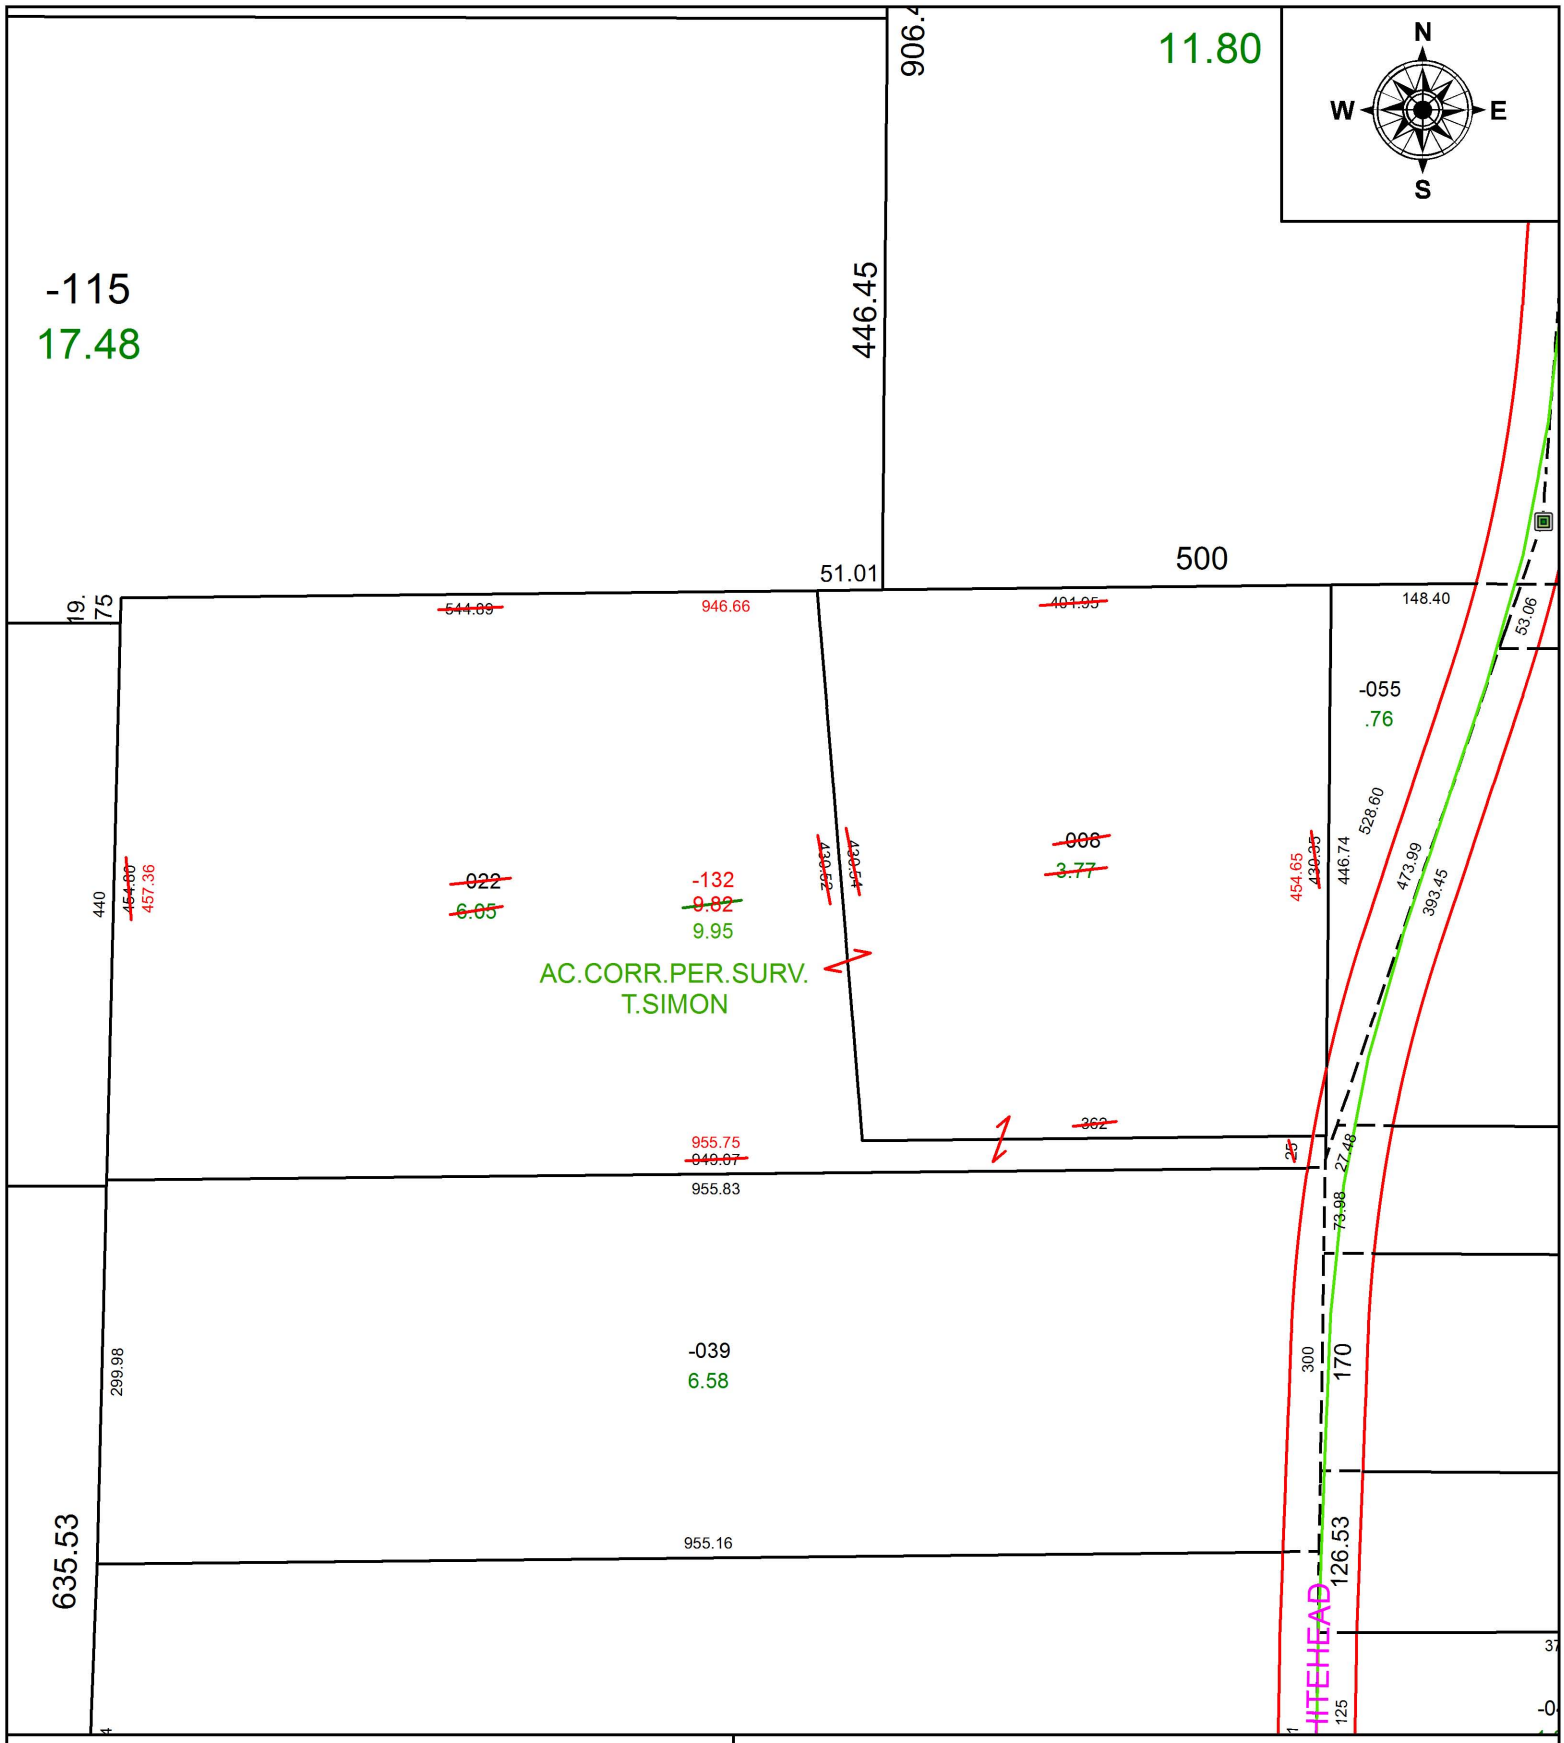

SPLITS/DEEDS PROCESSED

LORAIN COUNTY TAX MAP DEPARTMENT
226 MIDDLE AVE. ELYRIA, OH

SURVEYED BY: THOMAS A. SIMON
CLOSURE: 1: 381,856
MAP PAGE(S): 10-00-022
APPOVED BY: RRM **DATE:** 9-12-17
SCALE: 1" = 150 **PRIOR INSTRUMENT:** 20170626523