PARENT PARCEL: 01-00-061-000-006
CHILD PARCEL: 01-00-061-000-017, -018
STARTING POINT: INTERSECTION OF C/L OF VERMILION RD. AND C/L OF VACATED PEASLEY RD.

17-03738

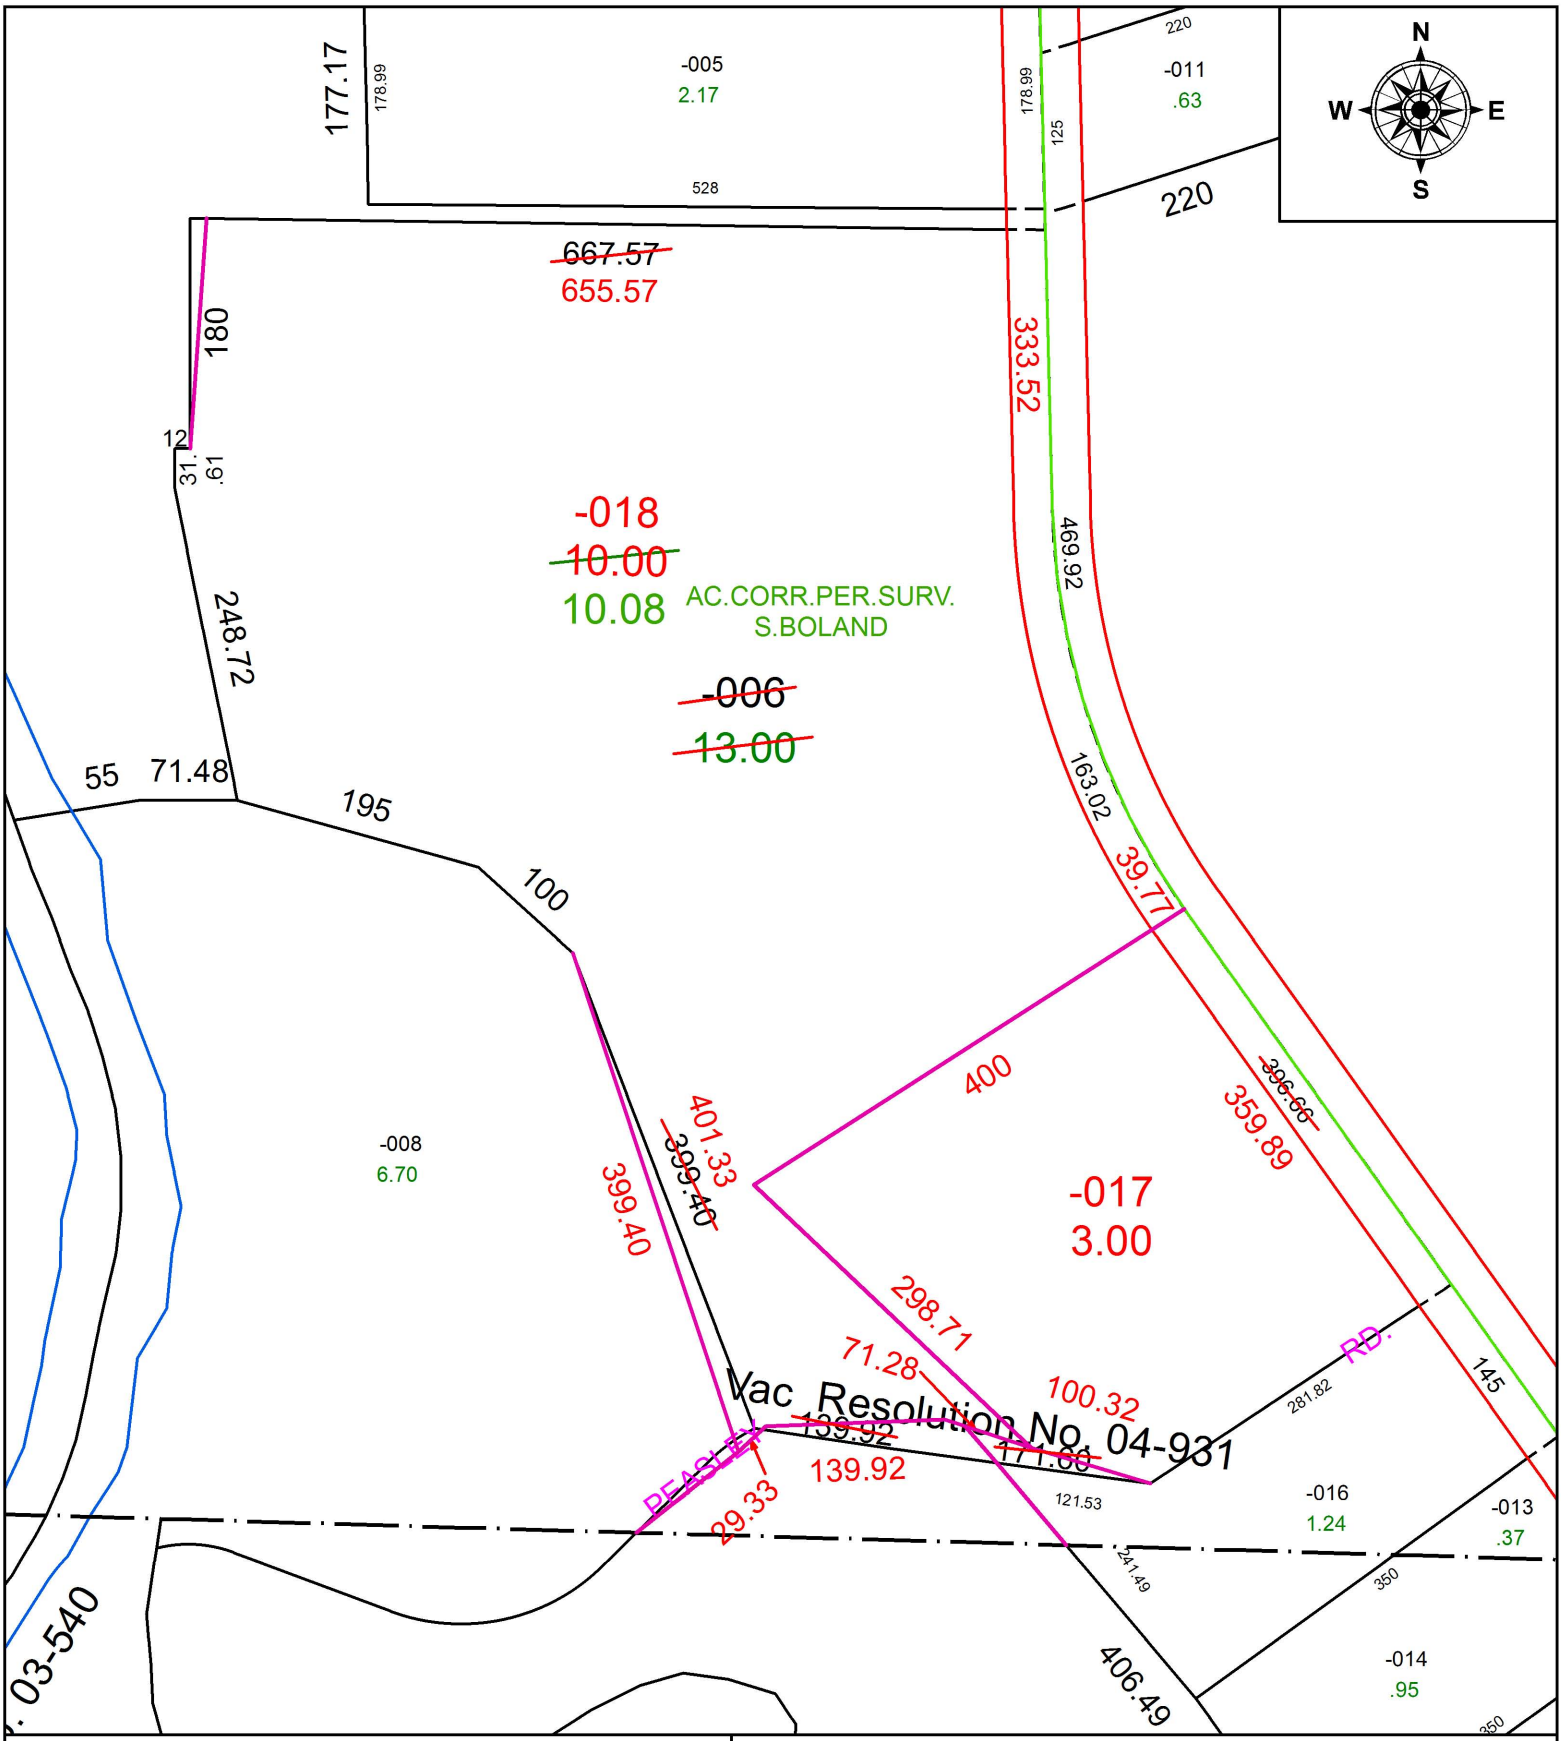

SPLITS/DEEDS PROCESSED
LORAIN COUNTY TAX MAP DEPARTMENT
226 MIDDLE AVE. ELYRIA, OH

SURVEYED BY: SEAN A. BOLAND
CLOSURE: 1: 332,526
MAP PAGE(S): 1-00-061
APPOVED BY: RRM **DATE:** 10-23-17
SCALE: 1" = 150 **PRIOR INSTRUMENT:** 19990608880