PARENT PARCEL: 10-00-003-125-020
CHILD PARCEL: 10-00-003-125-022, -023
STARTING POINT: NORTHEAST CORNER OF LAND CONVEYED TO DORIS F. WINSTON (DV 277/175)

17-03740-U

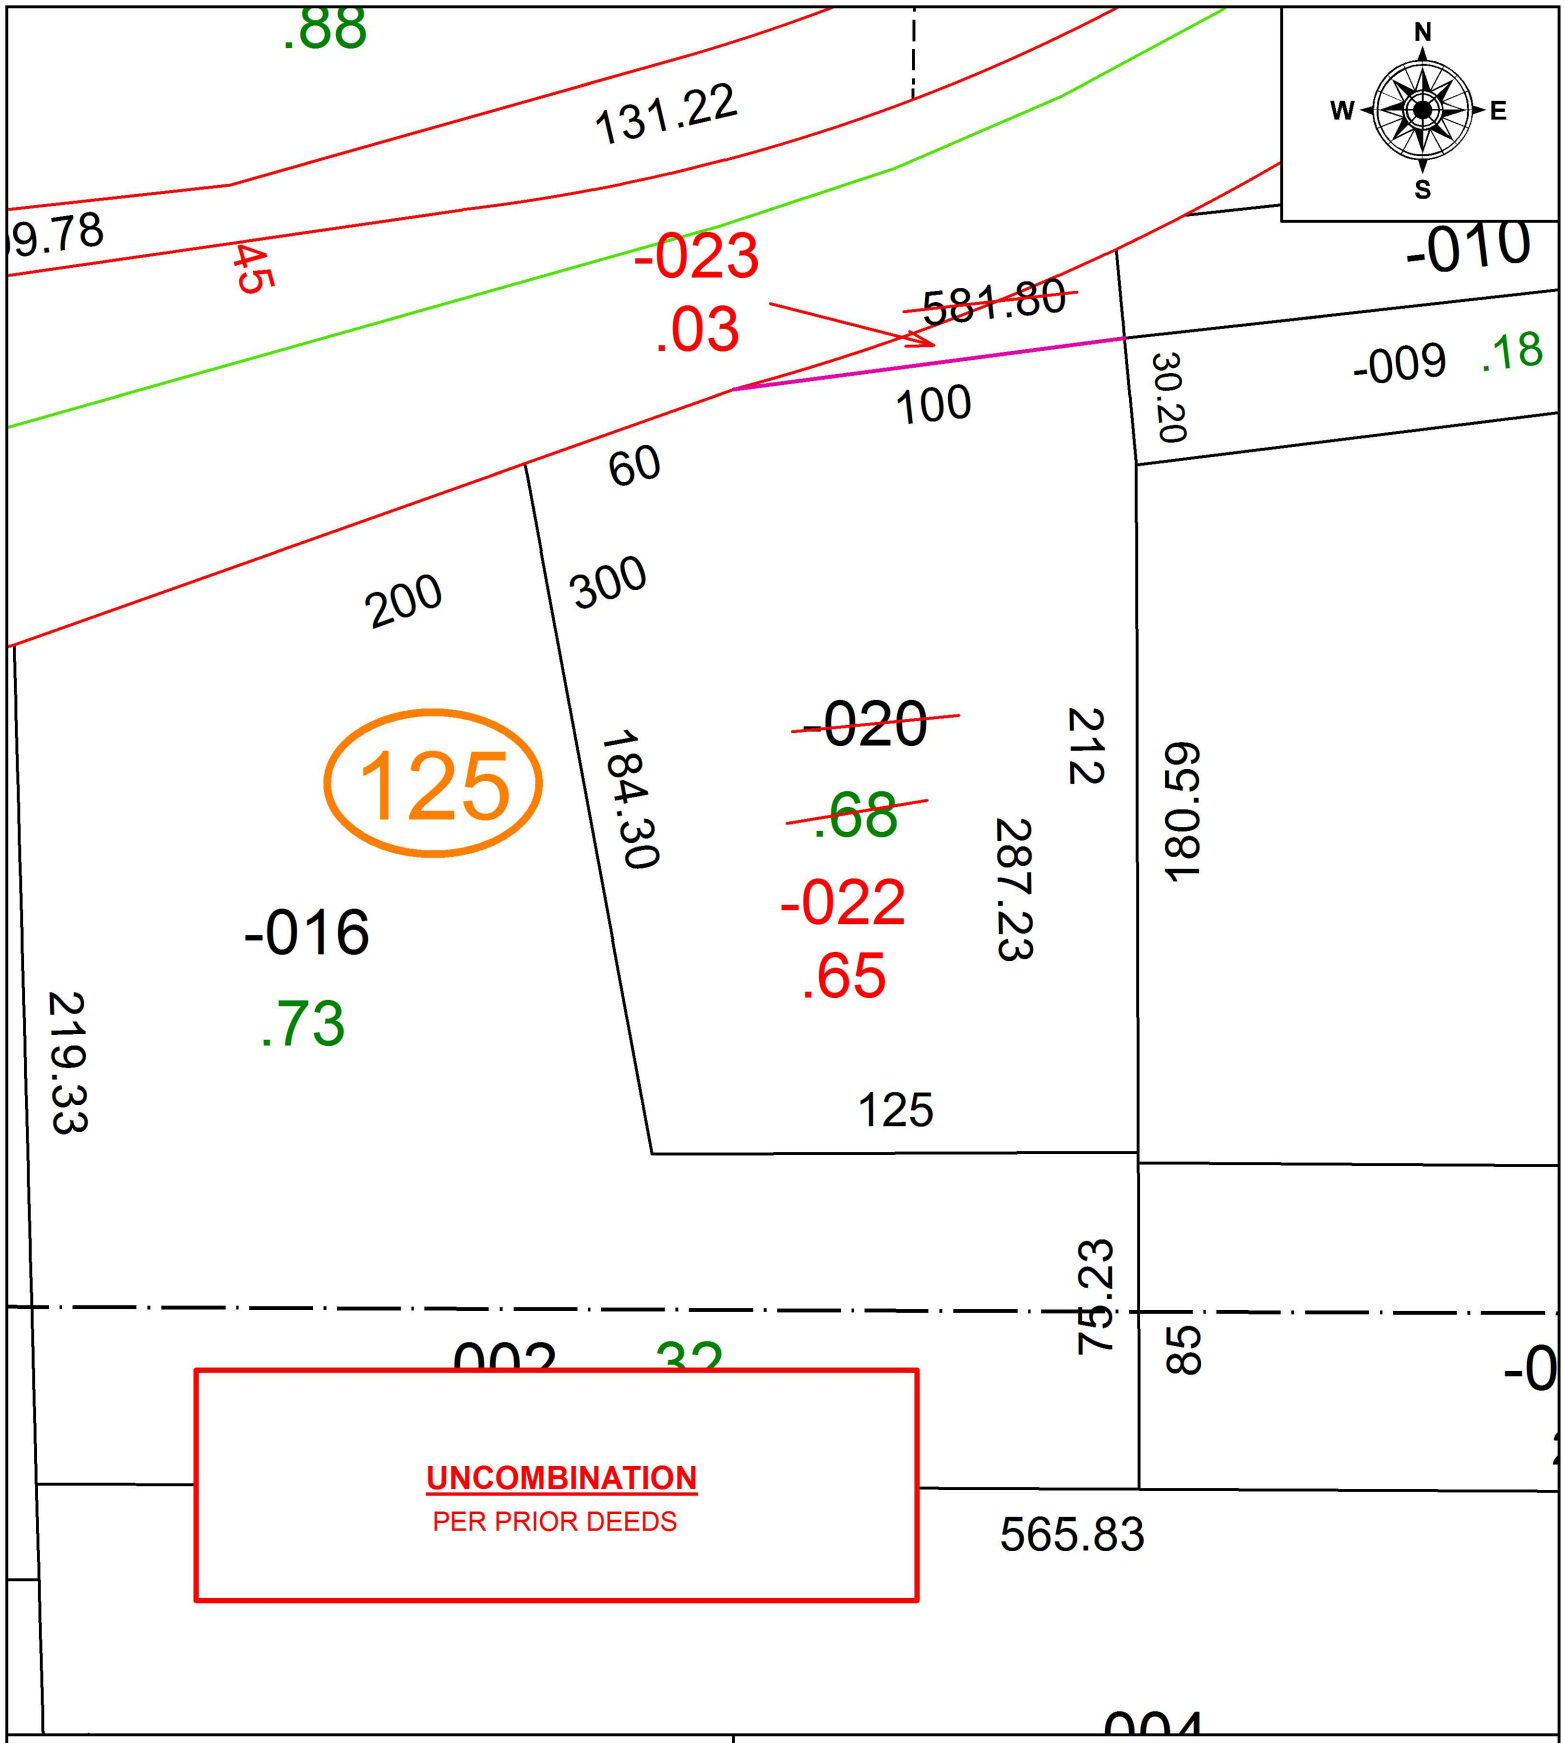

SPLITS/DEEDS PROCESSED
LORAIN COUNTY TAX MAP DEPARTMENT
226 MIDDLE AVE. ELYRIA, OH

SURVEYED BY: D.D. ANDRUS
CLOSURE: 1: 6,655
MAP PAGE(S): 10-00-003
APPOVED BY: RRM **DATE:** 9-13-17
SCALE: 1" = 50 **PRIOR INSTRUMENT:** 20170632578