PARENT PARCEL: 20-06-013-000-003, -007

CHILD PARCEL: 20-05-030-000-013, 20-06-013-000-008 THRU -010

STARTING POINT: INTERSECTION OF C/L OF GORE ORPHANAGE RD. AND C/L OF STOCKING RD.

17-03742

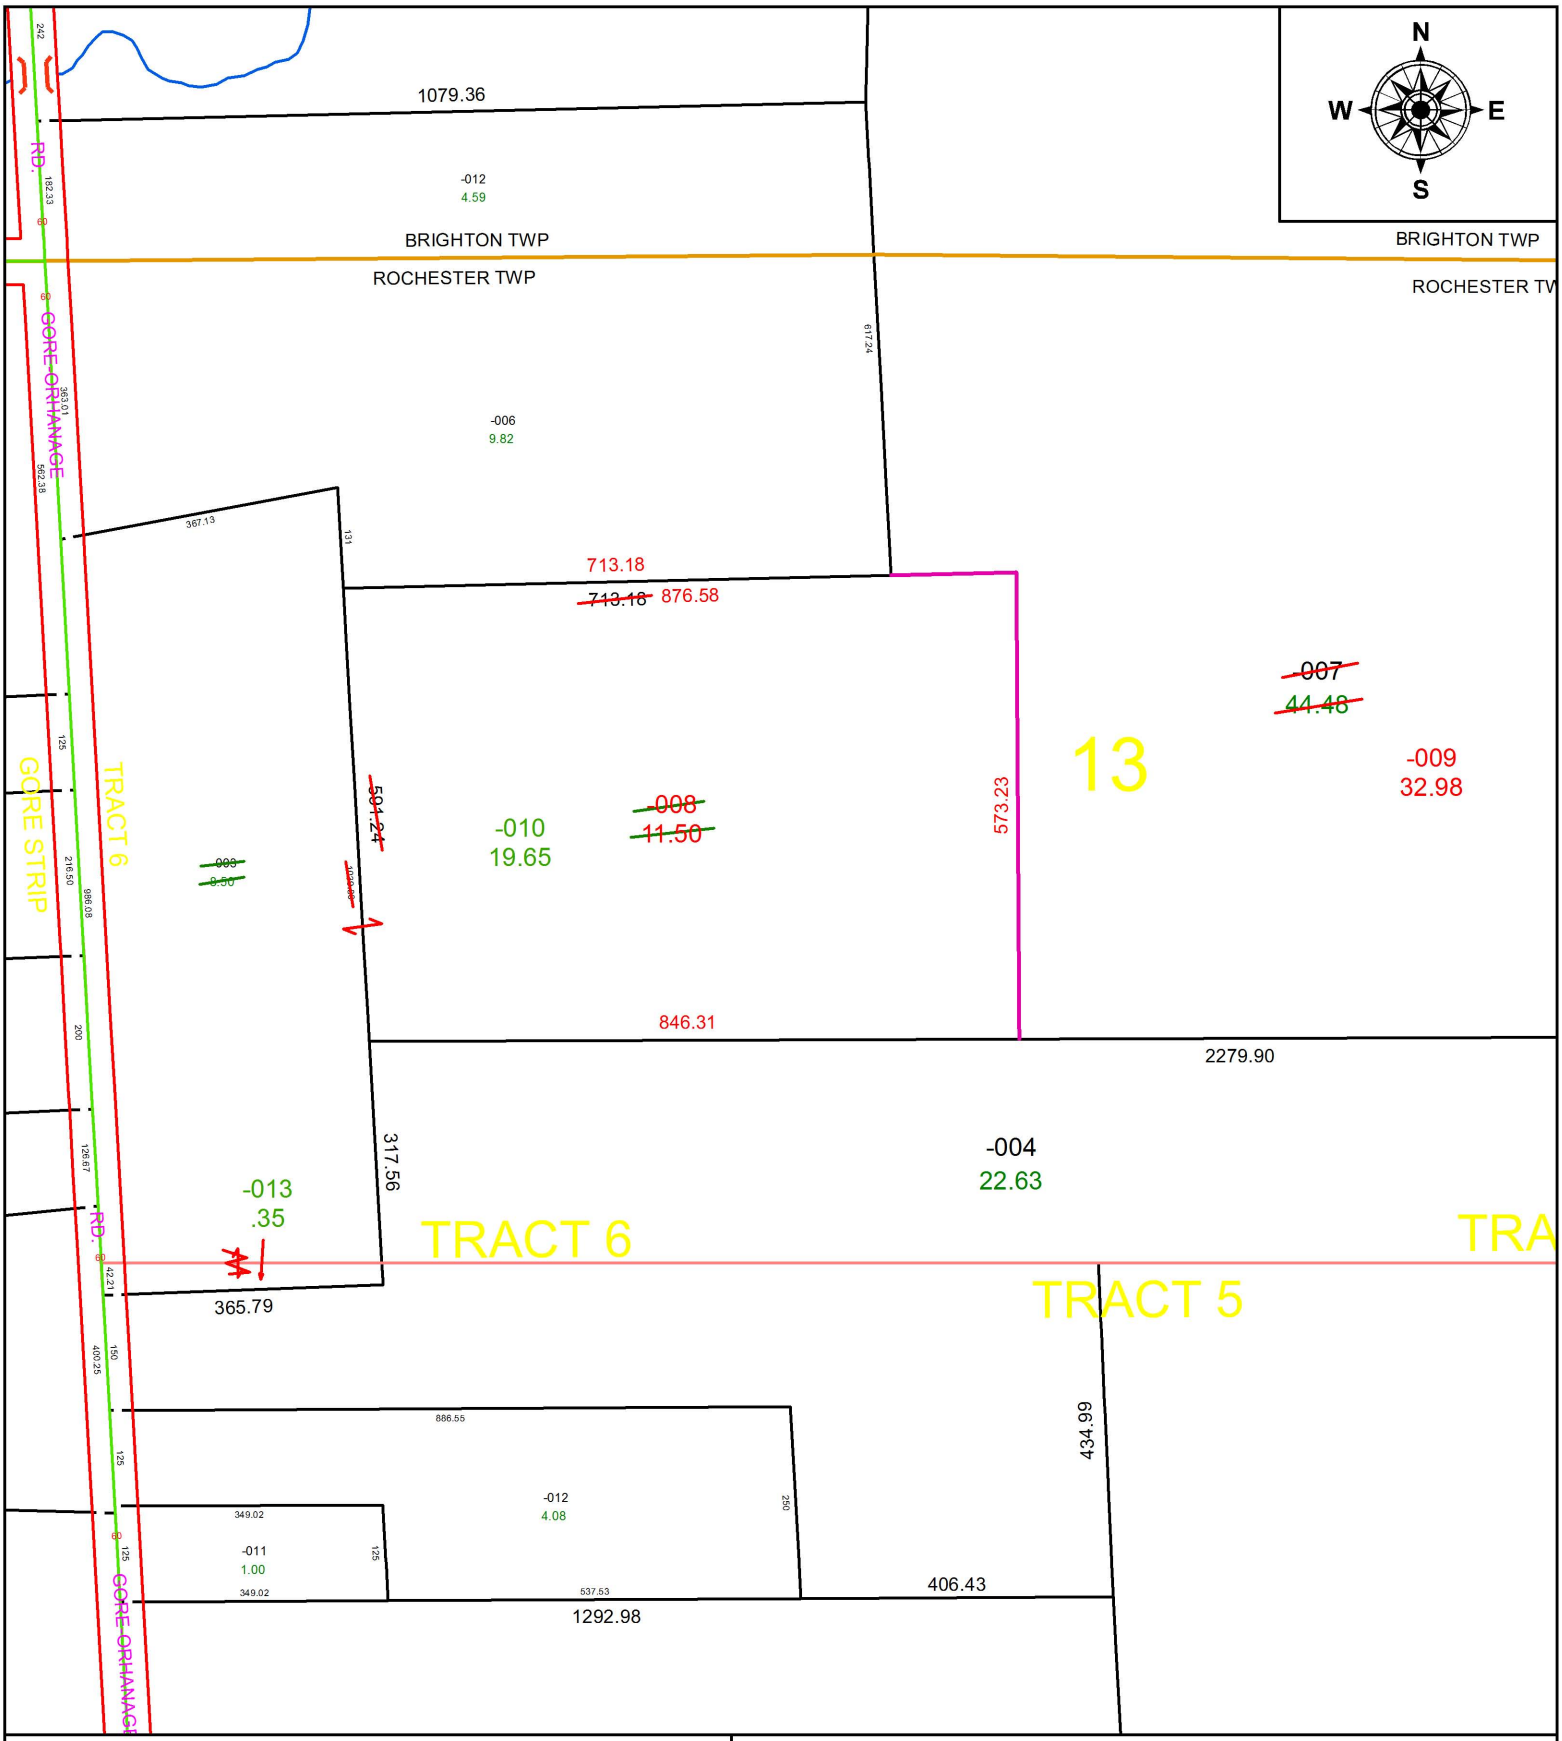

SPLITS/DEEDS PROCESSED

LORAIN COUNTY TAX MAP DEPARTMENT
226 MIDDLE AVE. ELYRIA, OH

SURVEYED BY: JAMES ALLEN COTTRELL
CLOSURE: 1: 74,082
MAP PAGE(S): 20-B
APPOVED BY: RRM **DATE:** 11-9-17
SCALE: 1" = 250 **PRIOR INSTRUMENT:** OR 619/933