PARENT PARCEL: 06-22-015-101-006, 06-23-012-101-039,-043, -050

CHILD PARCEL: 06-22-015-101-012, -013, 06-23-012-101-039, -043, -050

STARTING POINT: INTERSECTION OF C/L OF BEECHWOOD DR. AND WEST LINE OF CITY OF ELYRIA

17-03743

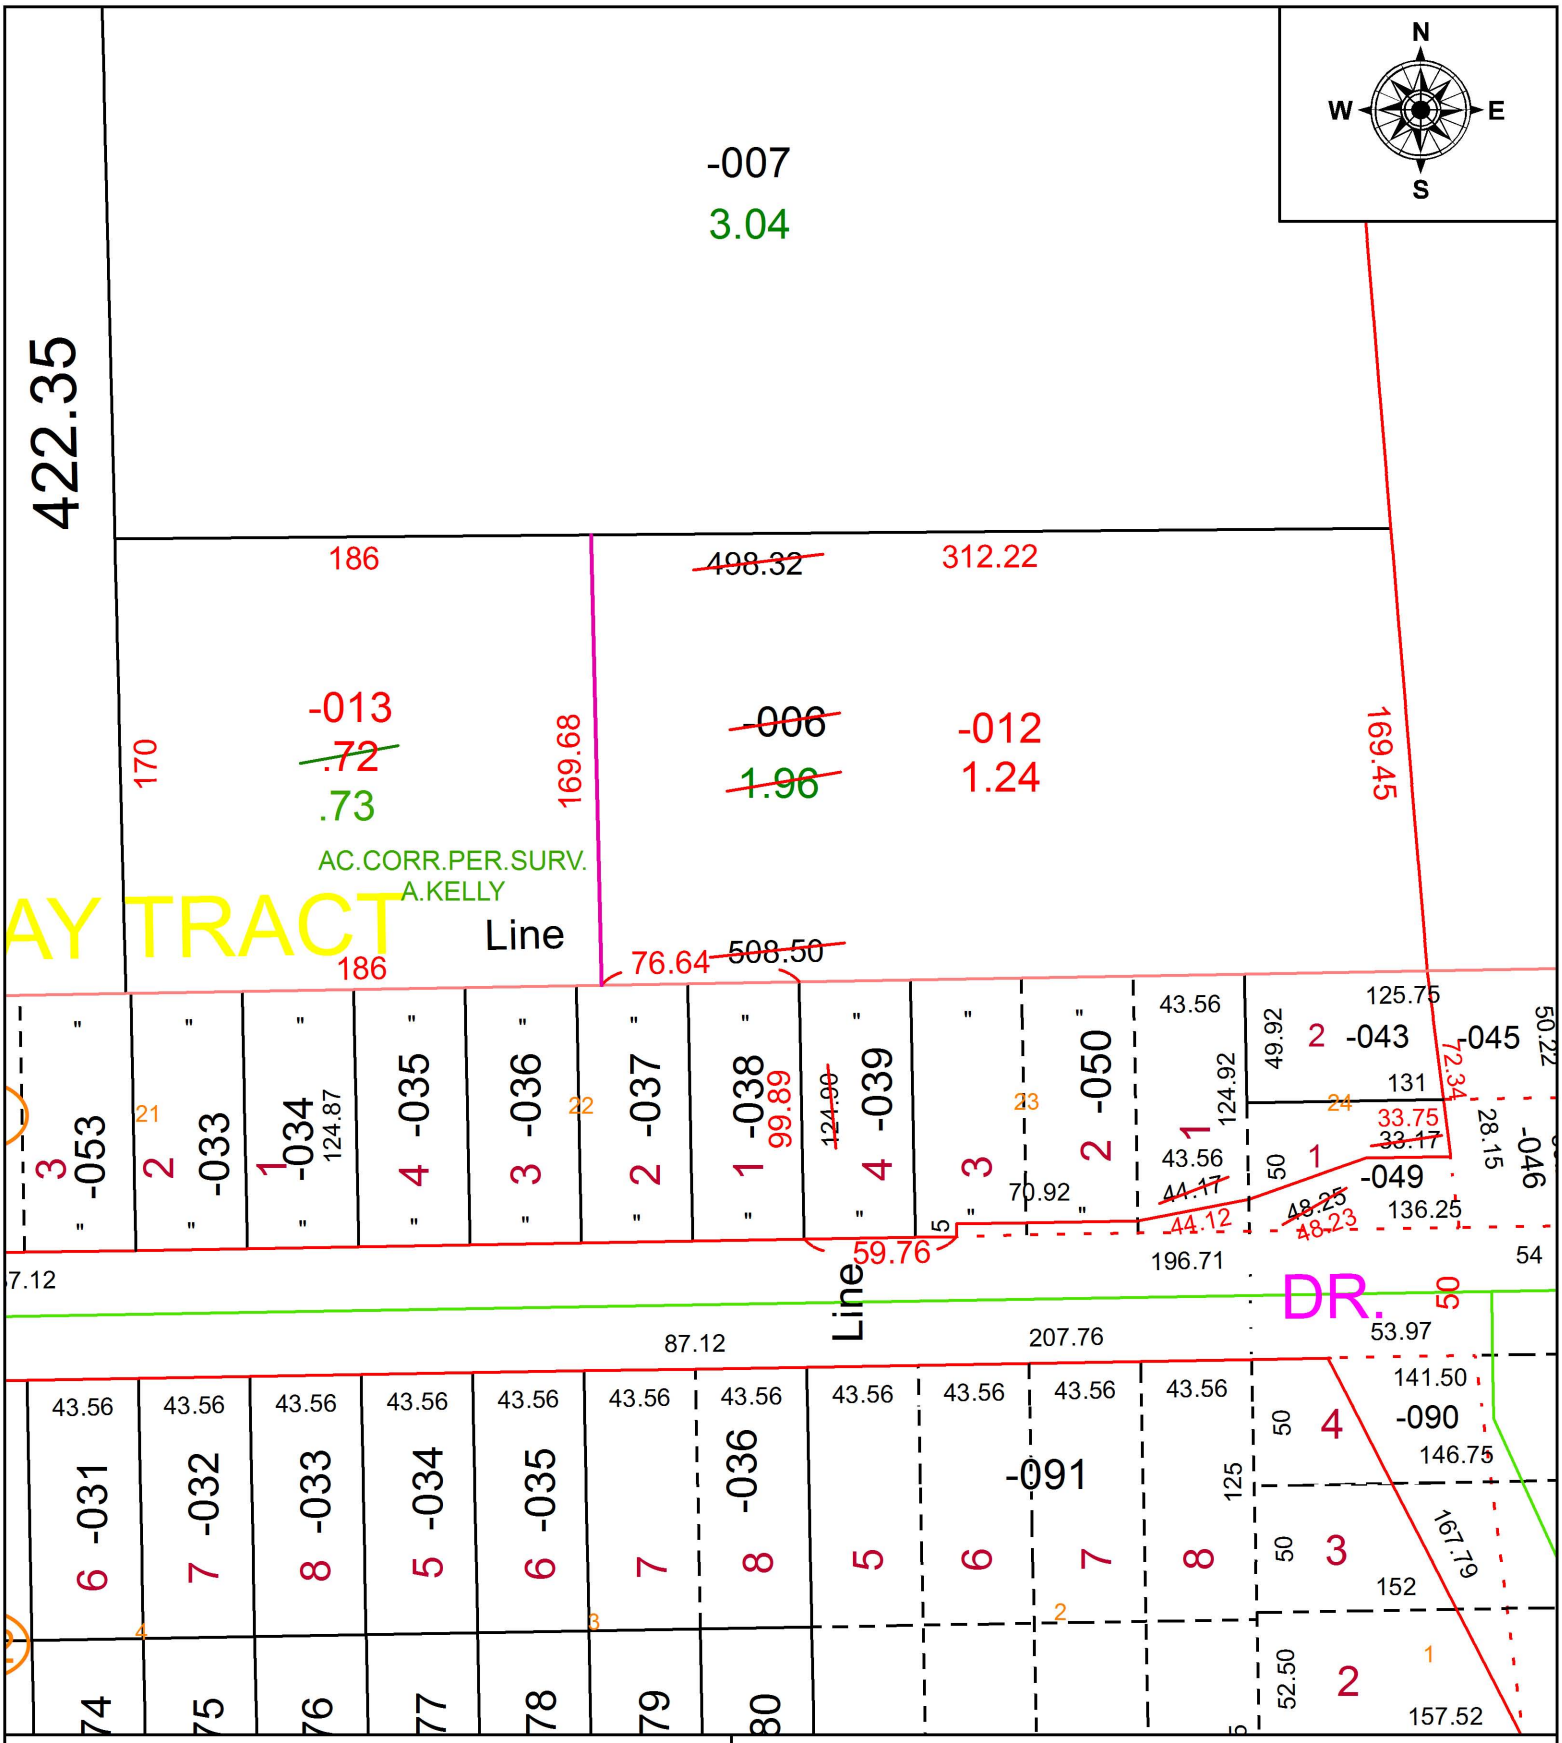

SPLITS/DEEDS PROCESSED

LORAIN COUNTY TAX MAP DEPARTMENT
226 MIDDLE AVE. ELYRIA, OH

SURVEYED BY: AMY M. KELLY
CLOSURE: 1: 178,361
MAP PAGE(S): 6-9
APPOVED BY: RRM **DATE:** 11-13-17
SCALE: 1" = 75 **PRIOR INSTRUMENT:** 20150556669