PARENT PARCEL: 05-00-024-105-017
CHILD PARCEL: XX-XX-XXX-XXX-XXX
STARTING POINT: SOUTHWEST CORNER OF S/L 141 IN M.C. SEELEY ADD.

17-03746-D

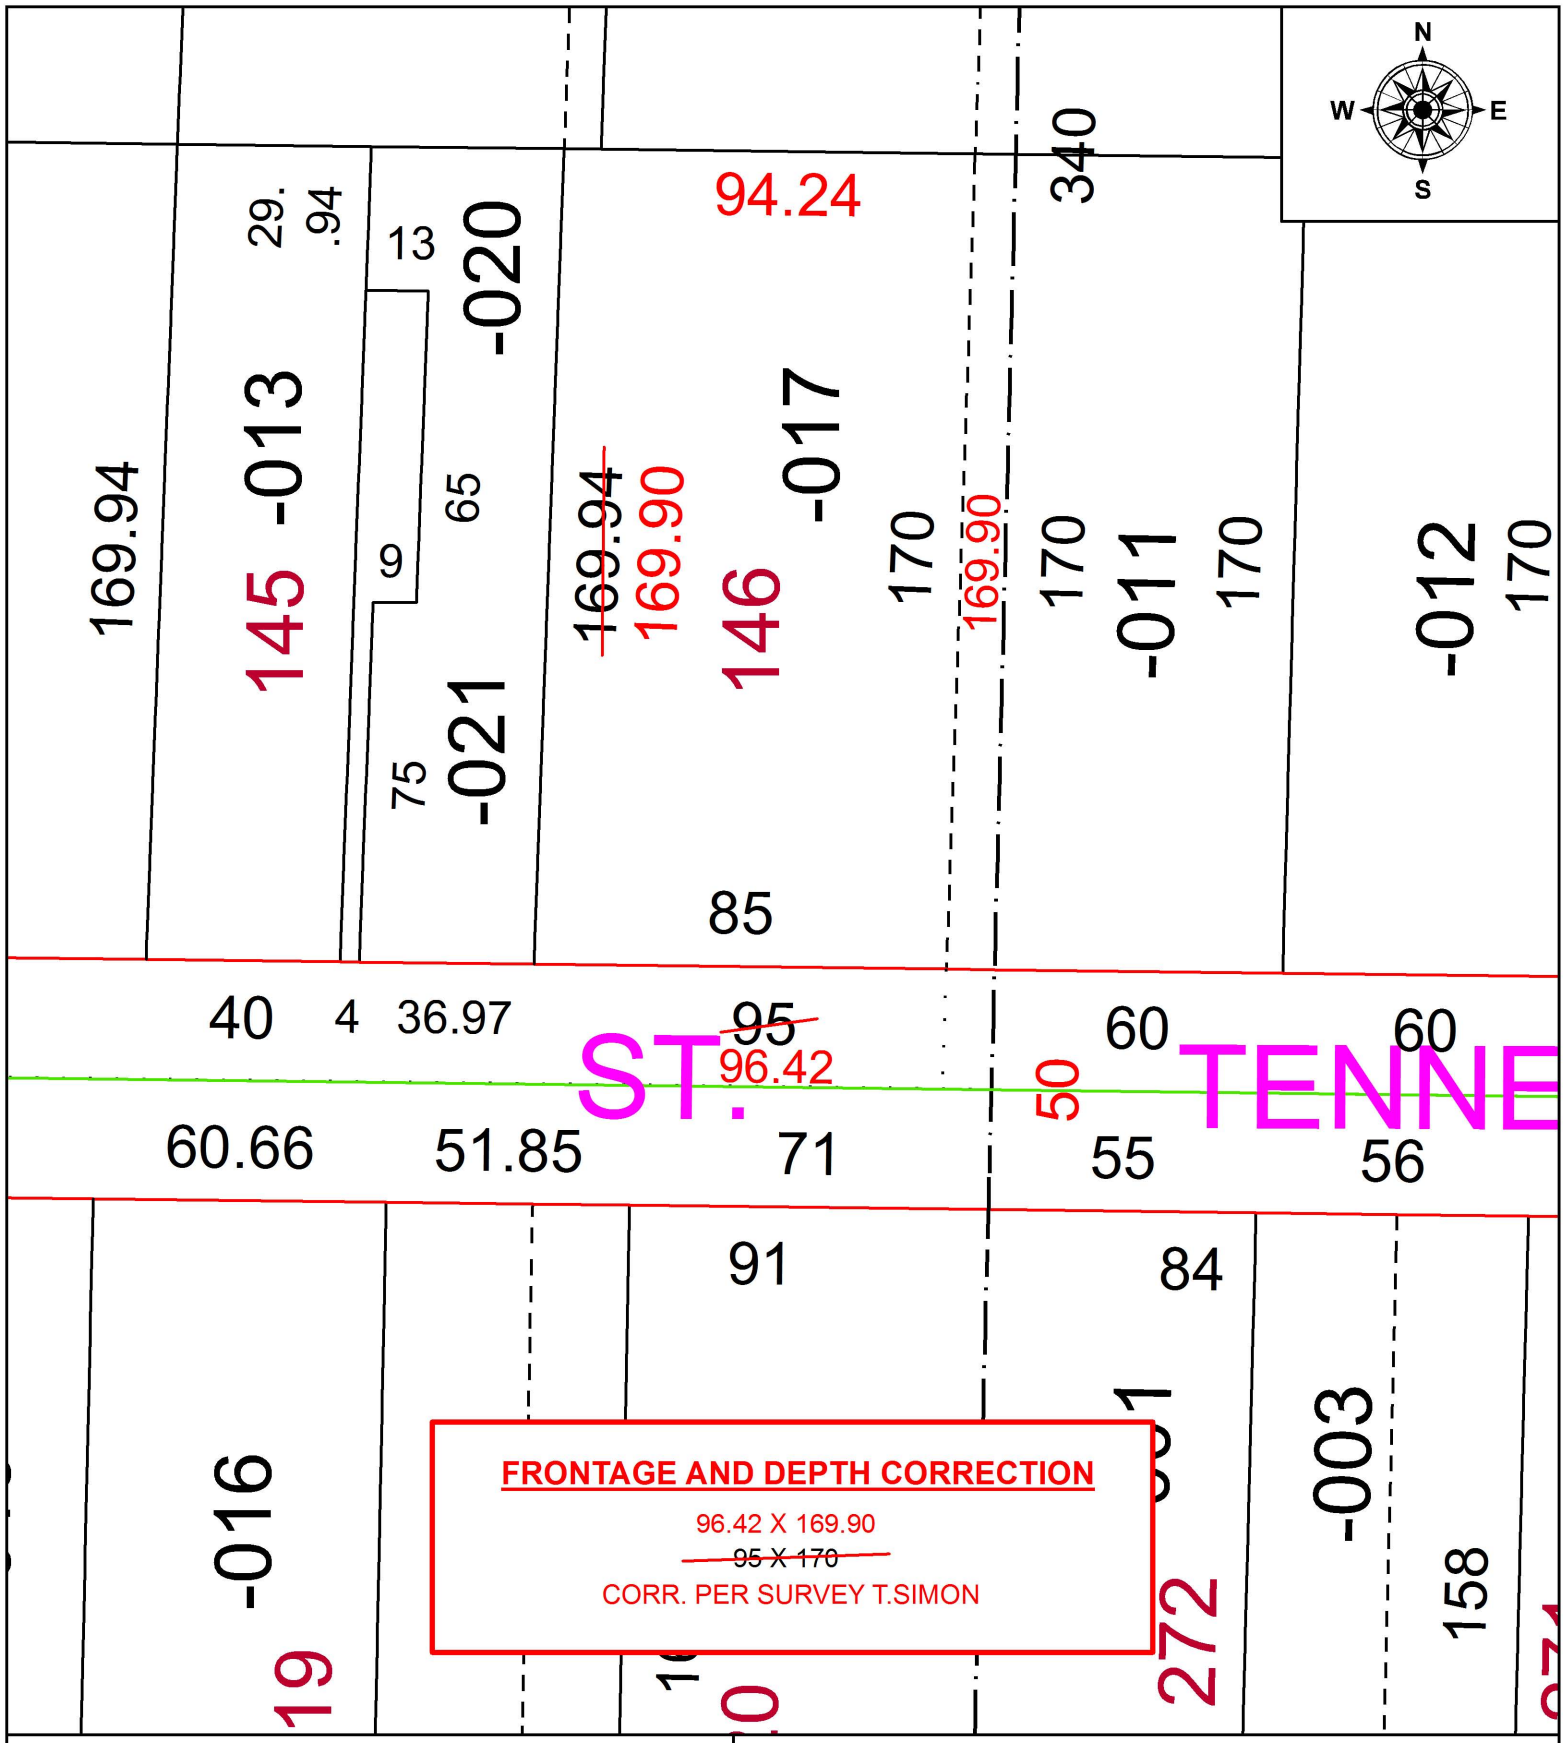

SPLITS/DEEDS PROCESSED
LORAIN COUNTY TAX MAP DEPARTMENT
226 MIDDLE AVE. ELYRIA, OH

SURVEYED BY: THOMAS A. SIMON
CLOSURE: 1: 156,379
MAP PAGE(S): 5-00-024
APPOVED BY: RRM **DATE:** 9-20-17
SCALE: 1" = 40 **PRIOR INSTRUMENT:** 20170616490