PARENT PARCEL: 10-00-006-119-037, -038

CHILD PARCEL: 10-00-006-119-049 THRU -051

STARTING POINT: INTERSECTION OF C/L OF INDIAN HOLLOW RD. AND C/L OF BUTTERNUT RIDGE RD.

17-03746

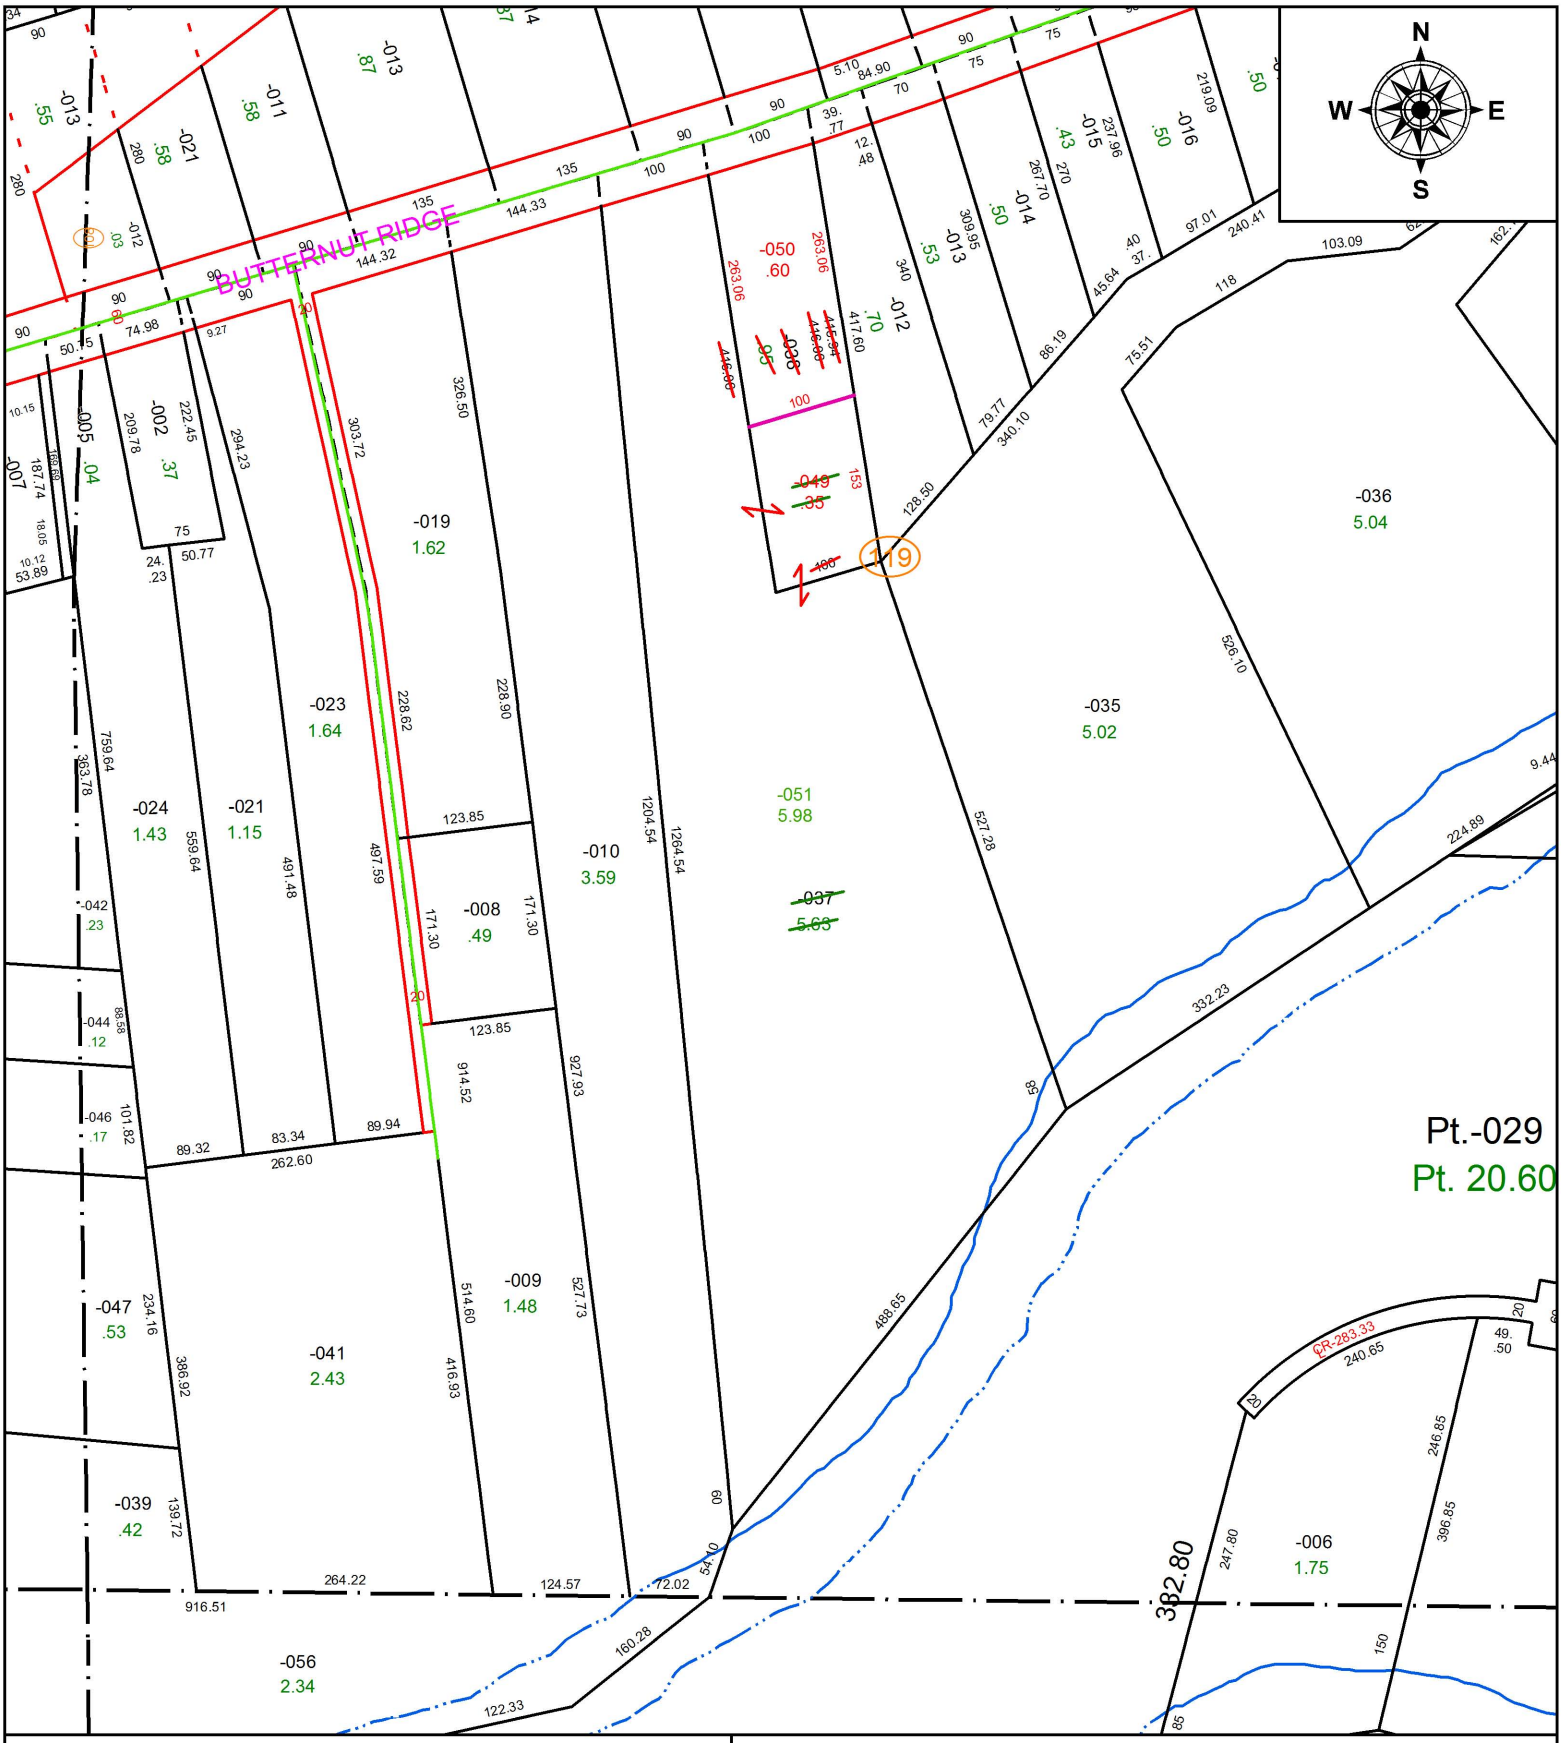

SPLITS/DEEDS PROCESSED

LORAIN COUNTY TAX MAP DEPARTMENT
226 MIDDLE AVE. ELYRIA, OH

SURVEYED BY: RODGER G. SIMON

CLOSURE: 1: 166,414

MAP PAGE(S): 10-00-006

APPOVED BY: RRM **DATE:** 11-17-17

SCALE: 1" = 175 **PRIOR INSTRUMENT:** 20160609560