PARENT PARCEL: 15-00-099-103-104, -110
CHILD PARCEL: 15-00-099-103-104, -164, -165
STARTING POINT: NORTHWEST CORNER OF S/L 108

17-03747

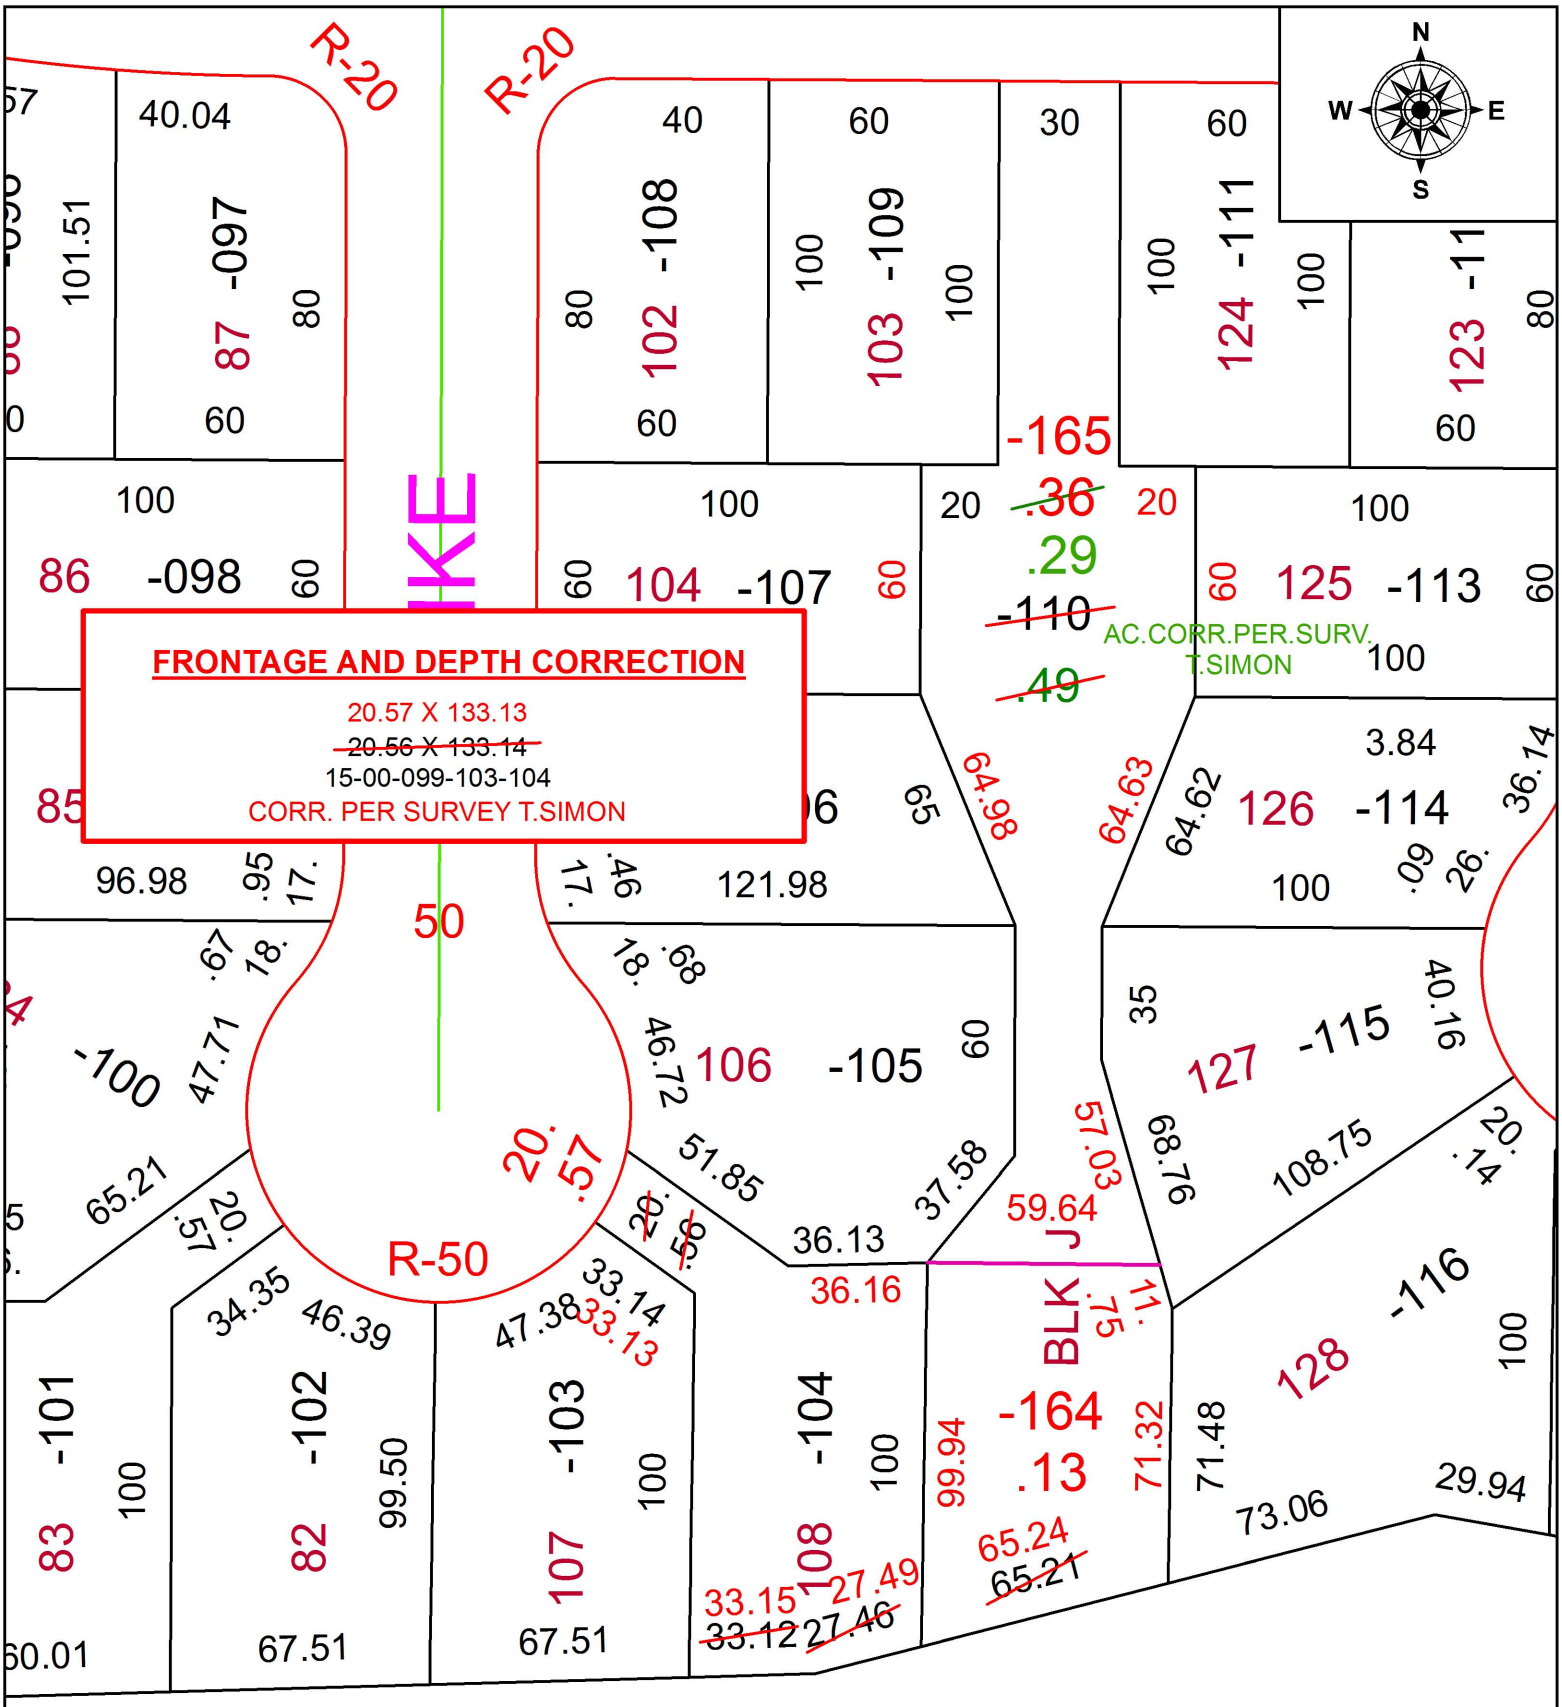

SPLITS/DEEDS PROCESSED
LORAIN COUNTY TAX MAP DEPARTMENT
226 MIDDLE AVE. ELYRIA, OH

SURVEYED BY: THOMAS A. SIMON
CLOSURE: 1: 60,050
MAP PAGE(S): 15-00-099
APPOVED BY: RRM **DATE:** 11-21-17
SCALE: 1" = 50 **PRIOR INSTRUMENT:** 20150554268