PARENT PARCEL: 15-00-060-000-006, -024

CHILD PARCEL: 15-00-060-000-025 THRU -027

STARTING POINT: INTERSECTION OF C/L OF S.R. 303 AND C/L OF NICKLE PLATE DIAGONAL RD.

17-03749

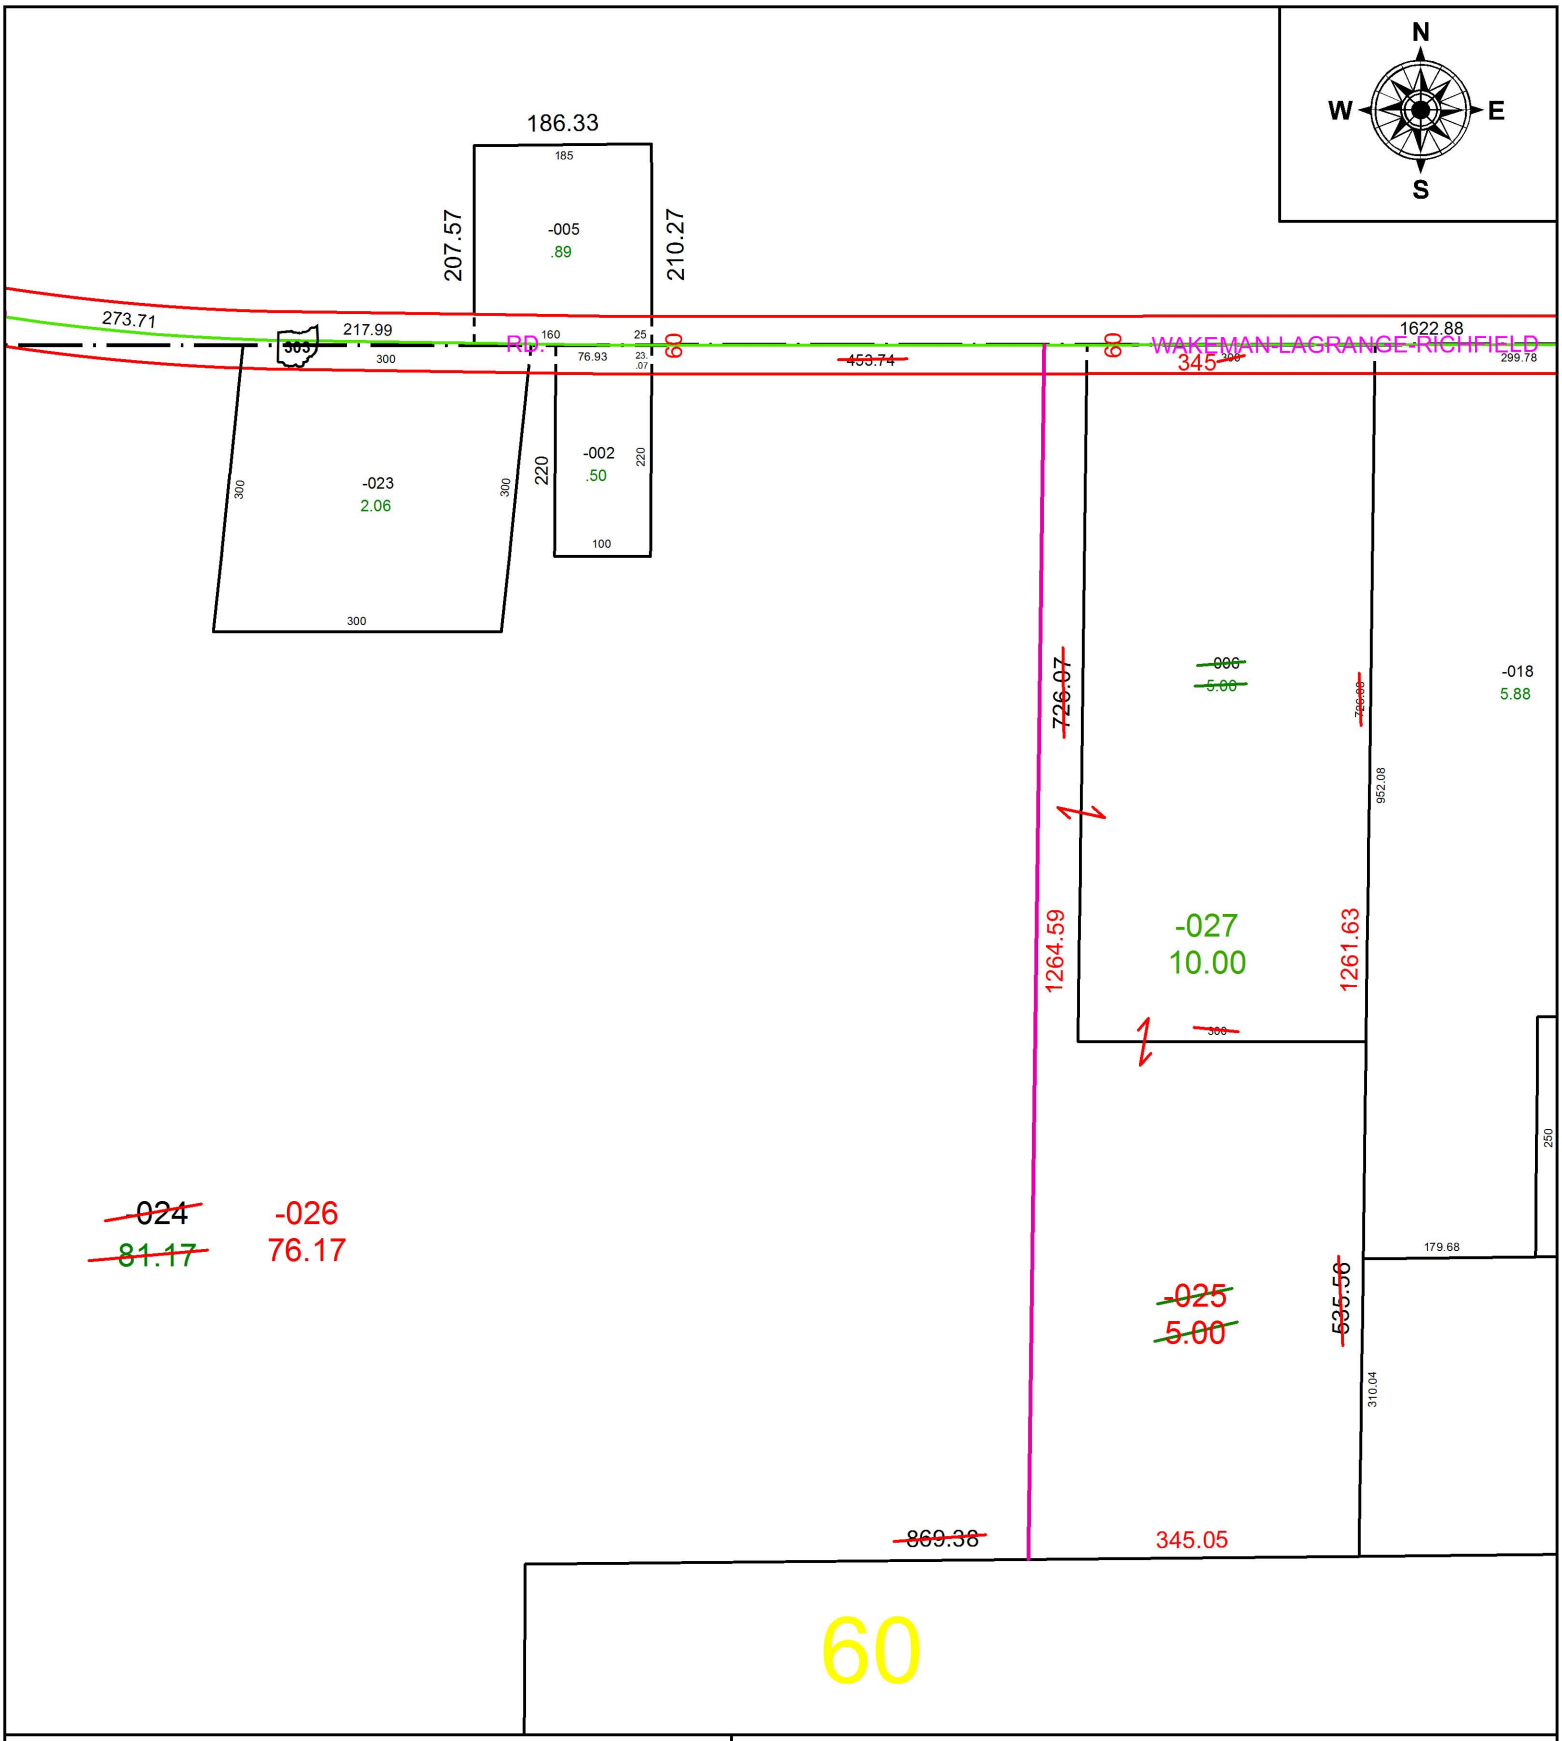

SPLITS/DEEDS PROCESSED

LORAIN COUNTY TAX MAP DEPARTMENT
226 MIDDLE AVE. ELYRIA, OH

SURVEYED BY: THOMAS A. SIMON
CLOSURE: 1: 733,021
MAP PAGE(S): 15-00-060
APPOVED BY: RRM **DATE:** 11-28-17
SCALE: 1" = 200 **PRIOR INSTRUMENT:** 20120442471