PARENT PARCEL: 10-00-008-110-026 THRU -028

CHILD PARCEL: 10-00-008-110-026, -028, -049, -050

STARTING POINT: NORTHWEST CORNER OF S/L 309 IN CARLISLE ESTATES NO. 2

17-03750

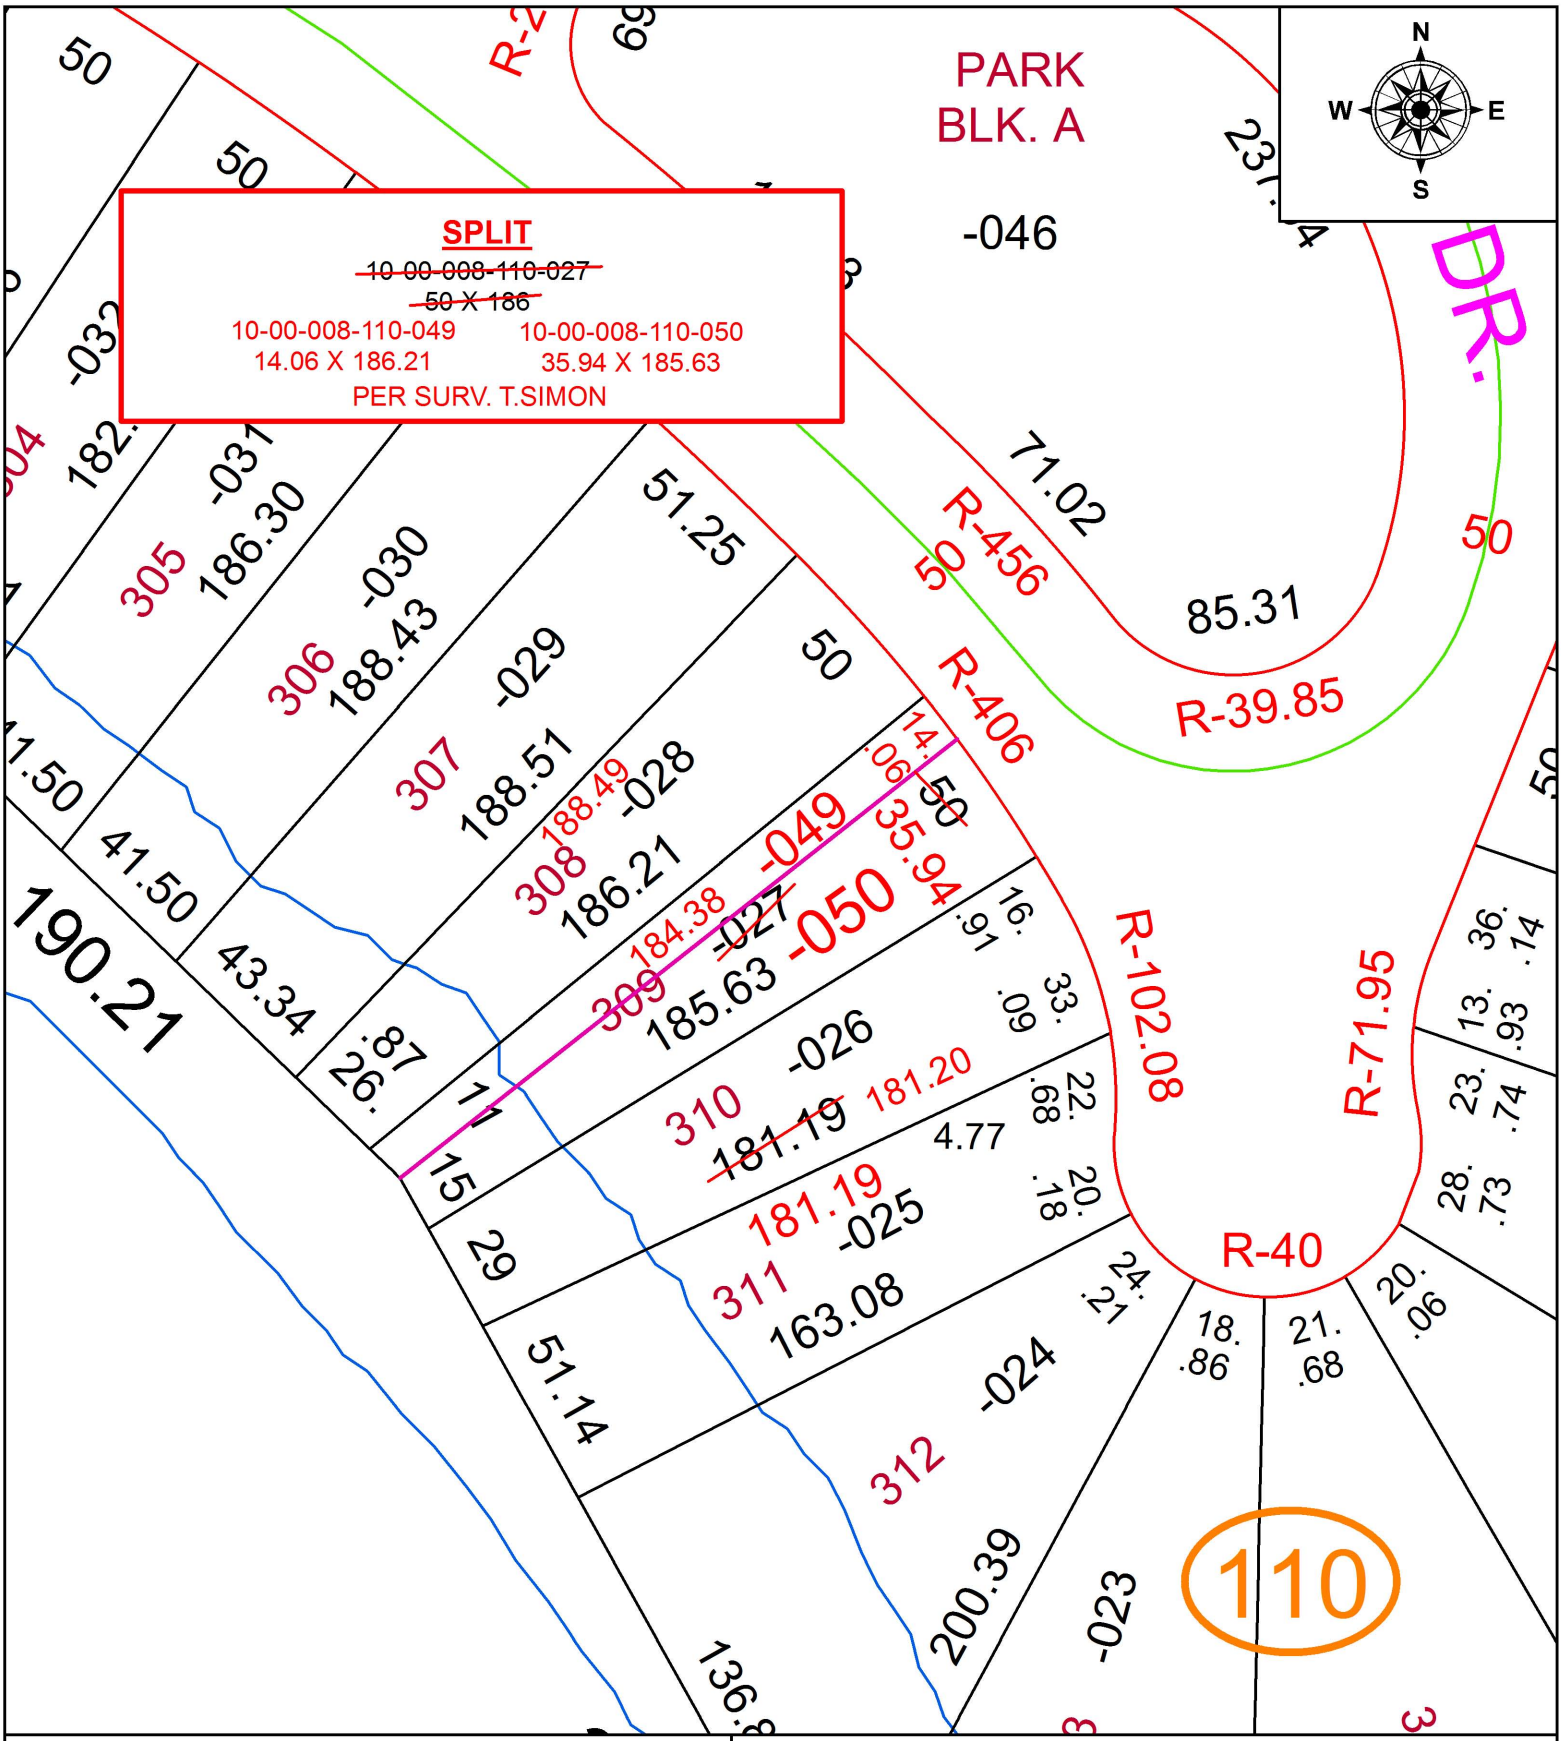

SPLITS/DEEDS PROCESSED

LORAIN COUNTY TAX MAP DEPARTMENT
226 MIDDLE AVE. ELYRIA, OH

SURVEYED BY: THOMAS A. SIMON
CLOSURE: 1: 85,631
MAP PAGE(S): 10-00-008
APPOVED BY: RRM **DATE:** 11-29-17
SCALE: 1" = 50 **PRIOR INSTRUMENT:** 19980571459