PARENT PARCEL: 04-00-020-104-411, -649
CHILD PARCEL: 04-00-020-104-653
STARTING POINT: INTERSECTION OF C/L OF WALKER RD. AND C/L OF LEAR RD.

17-03751

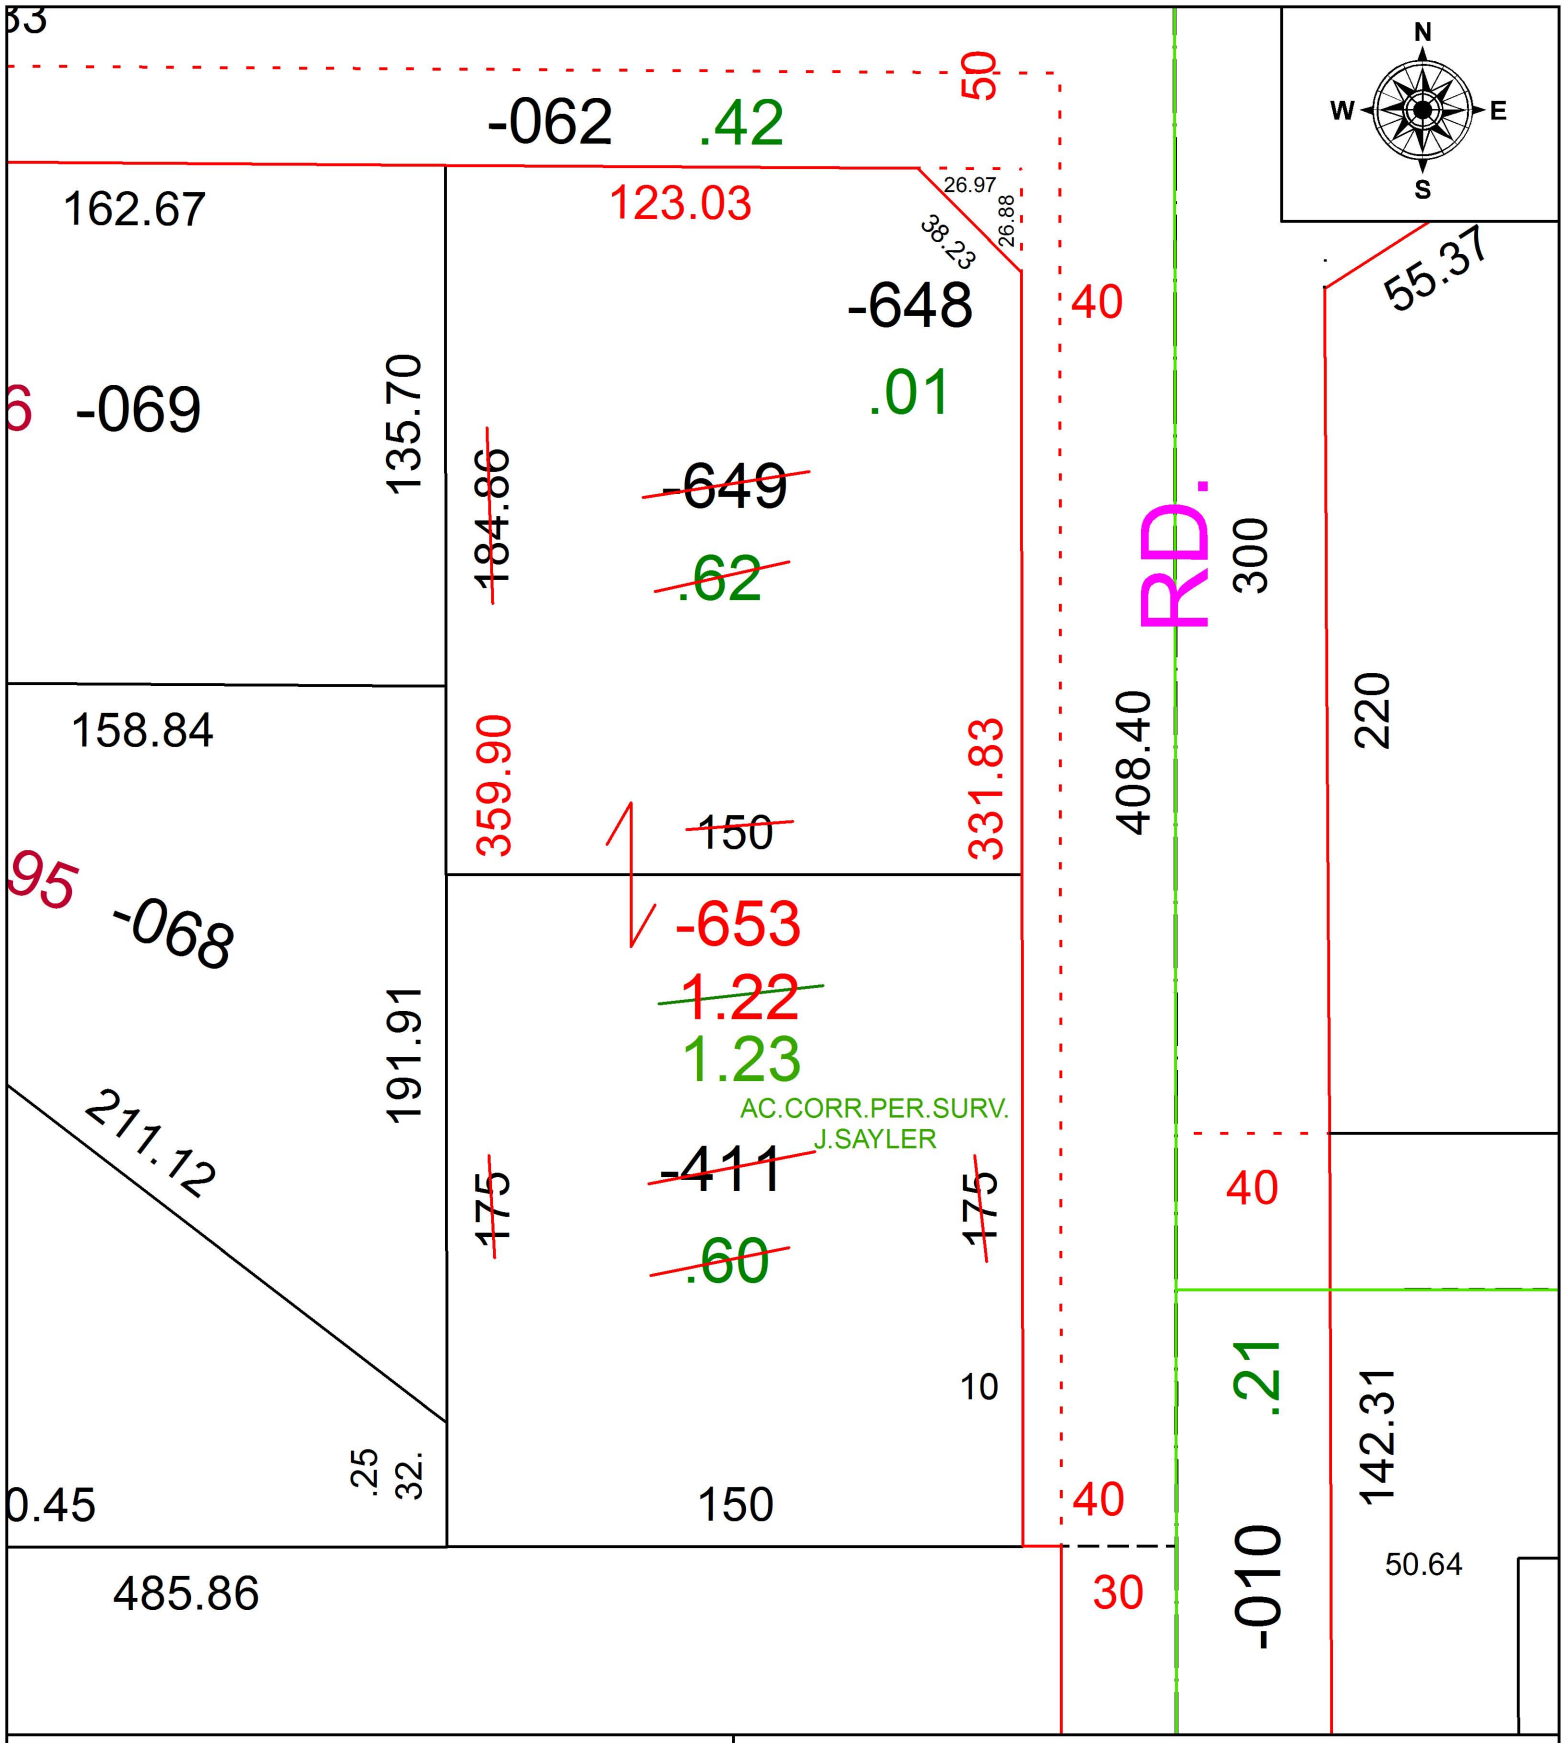

SPLITS/DEEDS PROCESSED
LORAIN COUNTY TAX MAP DEPARTMENT
226 MIDDLE AVE. ELYRIA, OH

SURVEYED BY: JAMES T. SAYLER
CLOSURE: 1: 286,716
MAP PAGE(S): 4-00-020
APPOVED BY: RRM **DATE:** 12-1-17
SCALE: 1" = 50 **PRIOR INSTRUMENT:** 20170647815