PARENT PARCEL: 04-00-018-101-011
CHILD PARCEL: 04-00-018-640-011
STARTING POINT: INTERSECTION OF EAST LINE OF LAND CONVEYED TO CYNTHIA L. DIETRICH & DENNIS P. THATCHER AND NORTH LINE OF LAKE RD.

17-03752

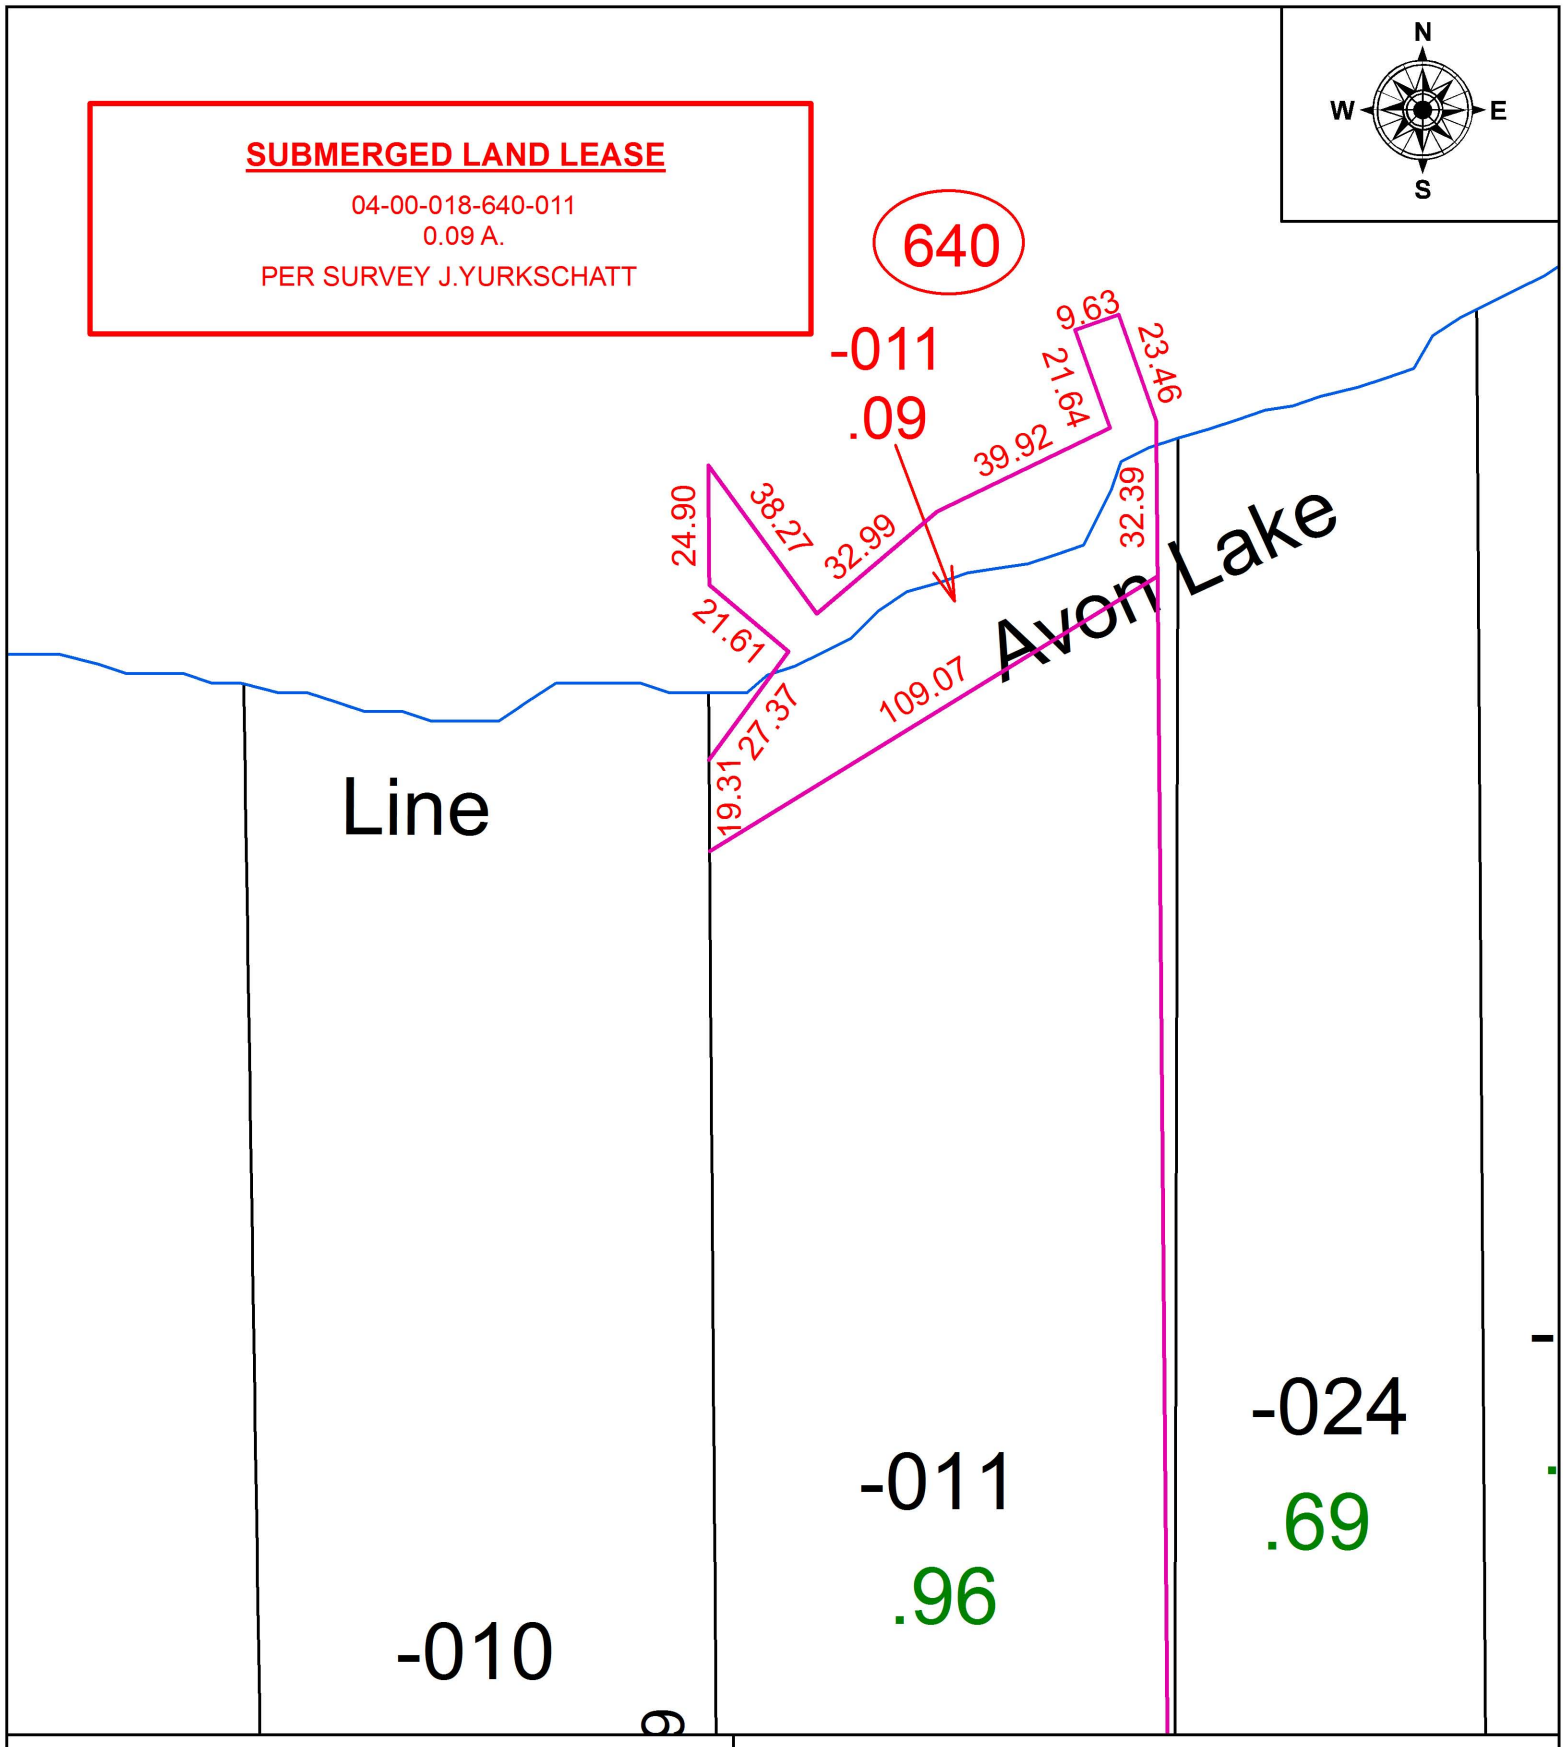

SPLITS/DEEDS PROCESSED
LORAIN COUNTY TAX MAP DEPARTMENT
226 MIDDLE AVE. ELYRIA, OH

SURVEYED BY: JAMES P. YURKSCHATT
CLOSURE: 1: 140,591
MAP PAGE(S): 4-00-018
APPOVED BY: RRM **DATE:** 12-1-17
SCALE: 1" = 40 **PRIOR INSTRUMENT:** 20160587968