PARENT PARCEL: 12-00-096-000-058
CHILD PARCEL: 12-00-096-630-002
STARTING POINT:

17-03755-G

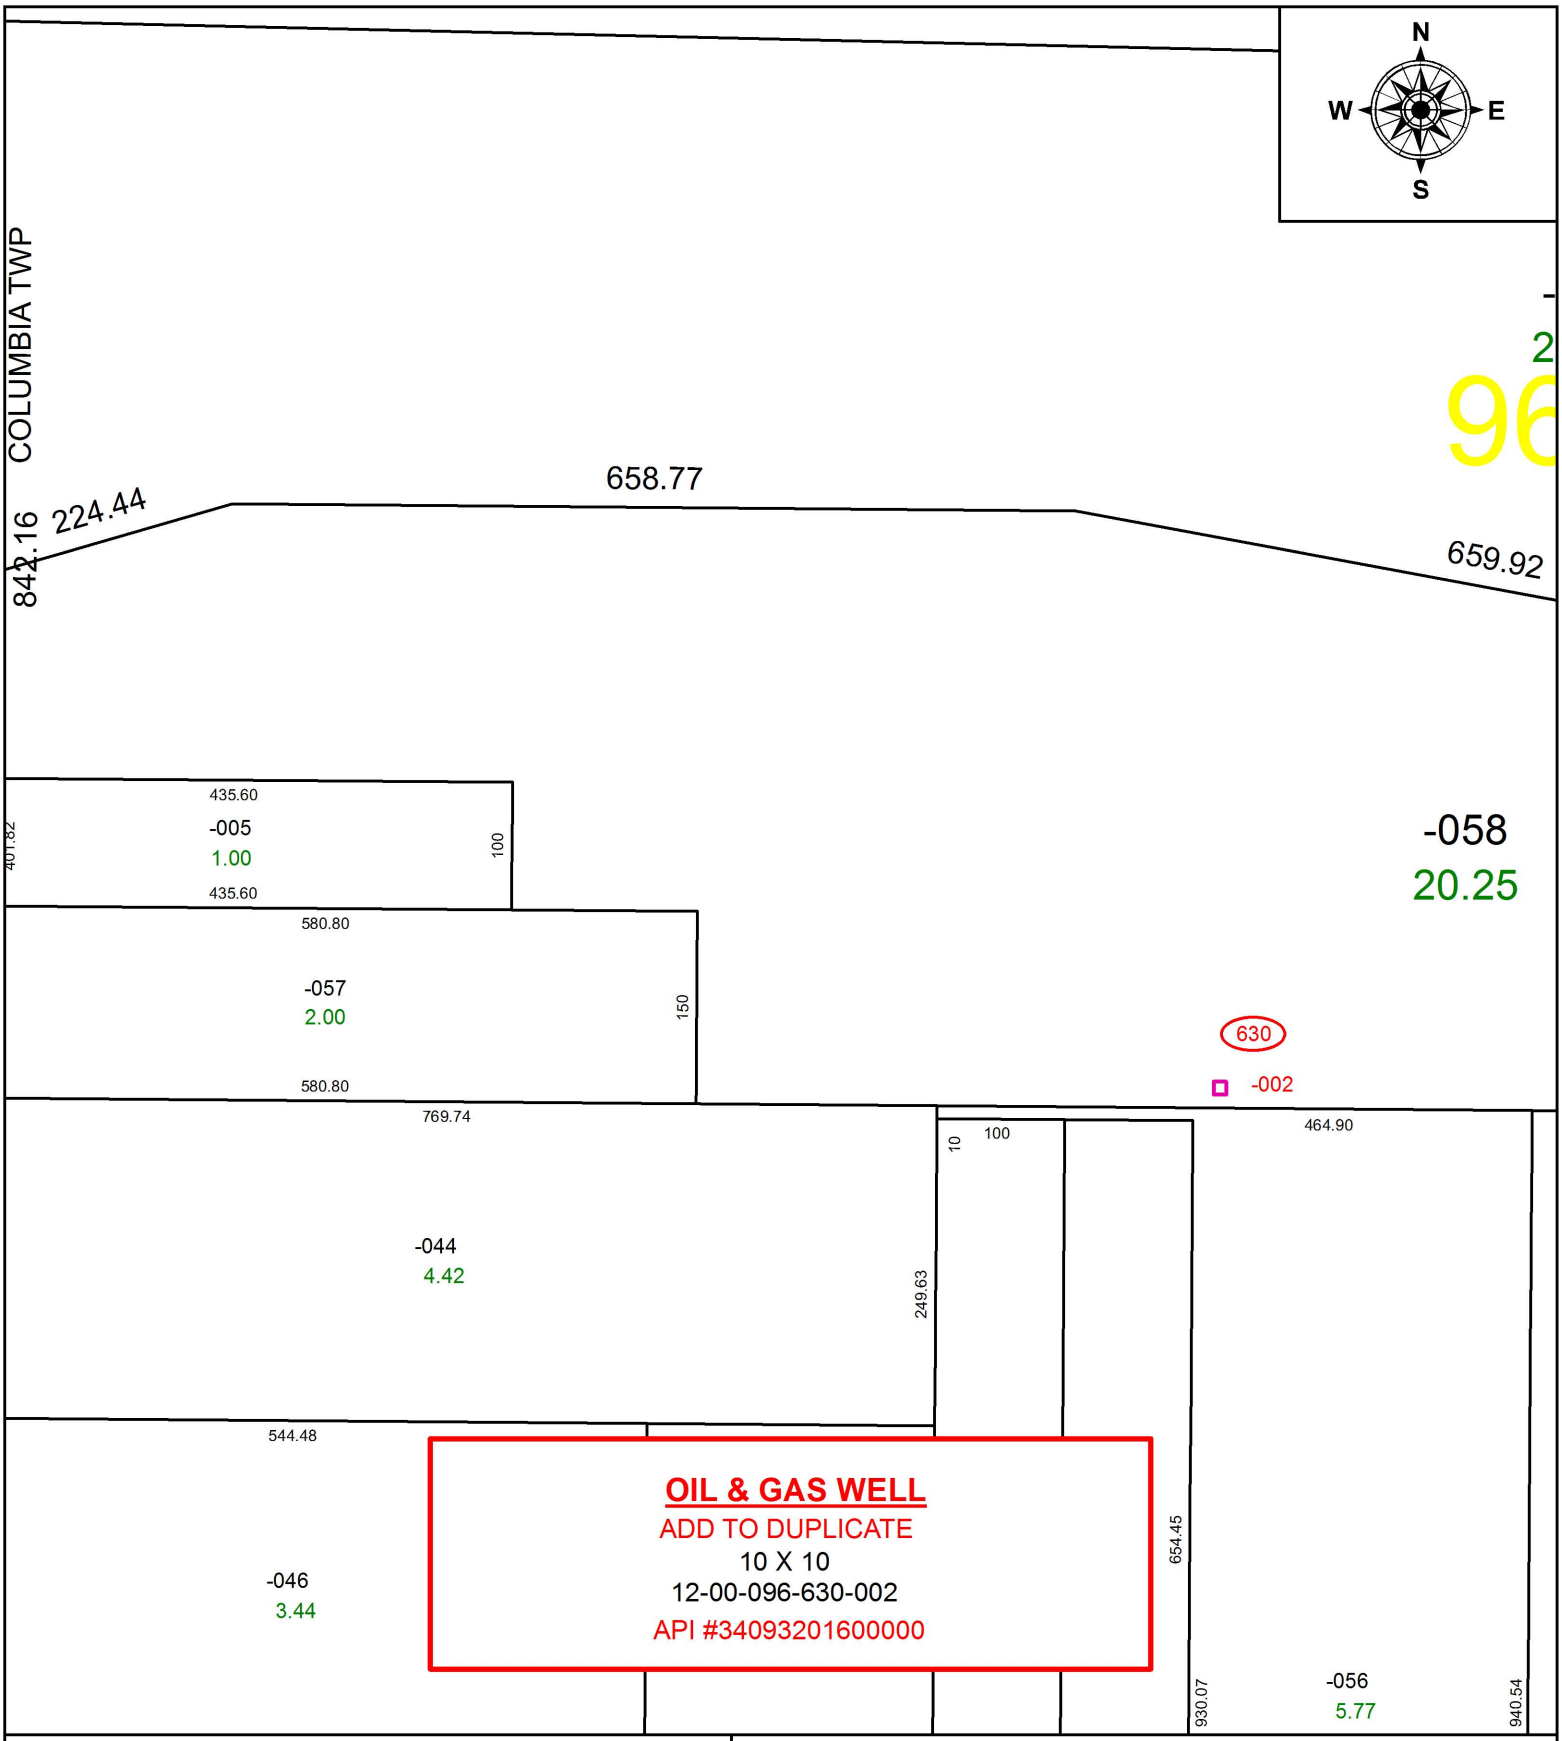

SPLITS/DEEDS PROCESSED

LORAIN COUNTY TAX MAP DEPARTMENT
226 MIDDLE AVE. ELYRIA, OH

SURVEYED BY: N/A
CLOSURE: N/A
MAP PAGE(S): 12-00-096
APPOVED BY: RRM **DATE:** 9-25-17
SCALE: 1" = 150 **PRIOR INSTRUMENT:** N/A