PARENT PARCEL: 12-00-084-102-043
CHILD PARCEL: 12-00-084-630-001
STARTING POINT:

17-03757-G

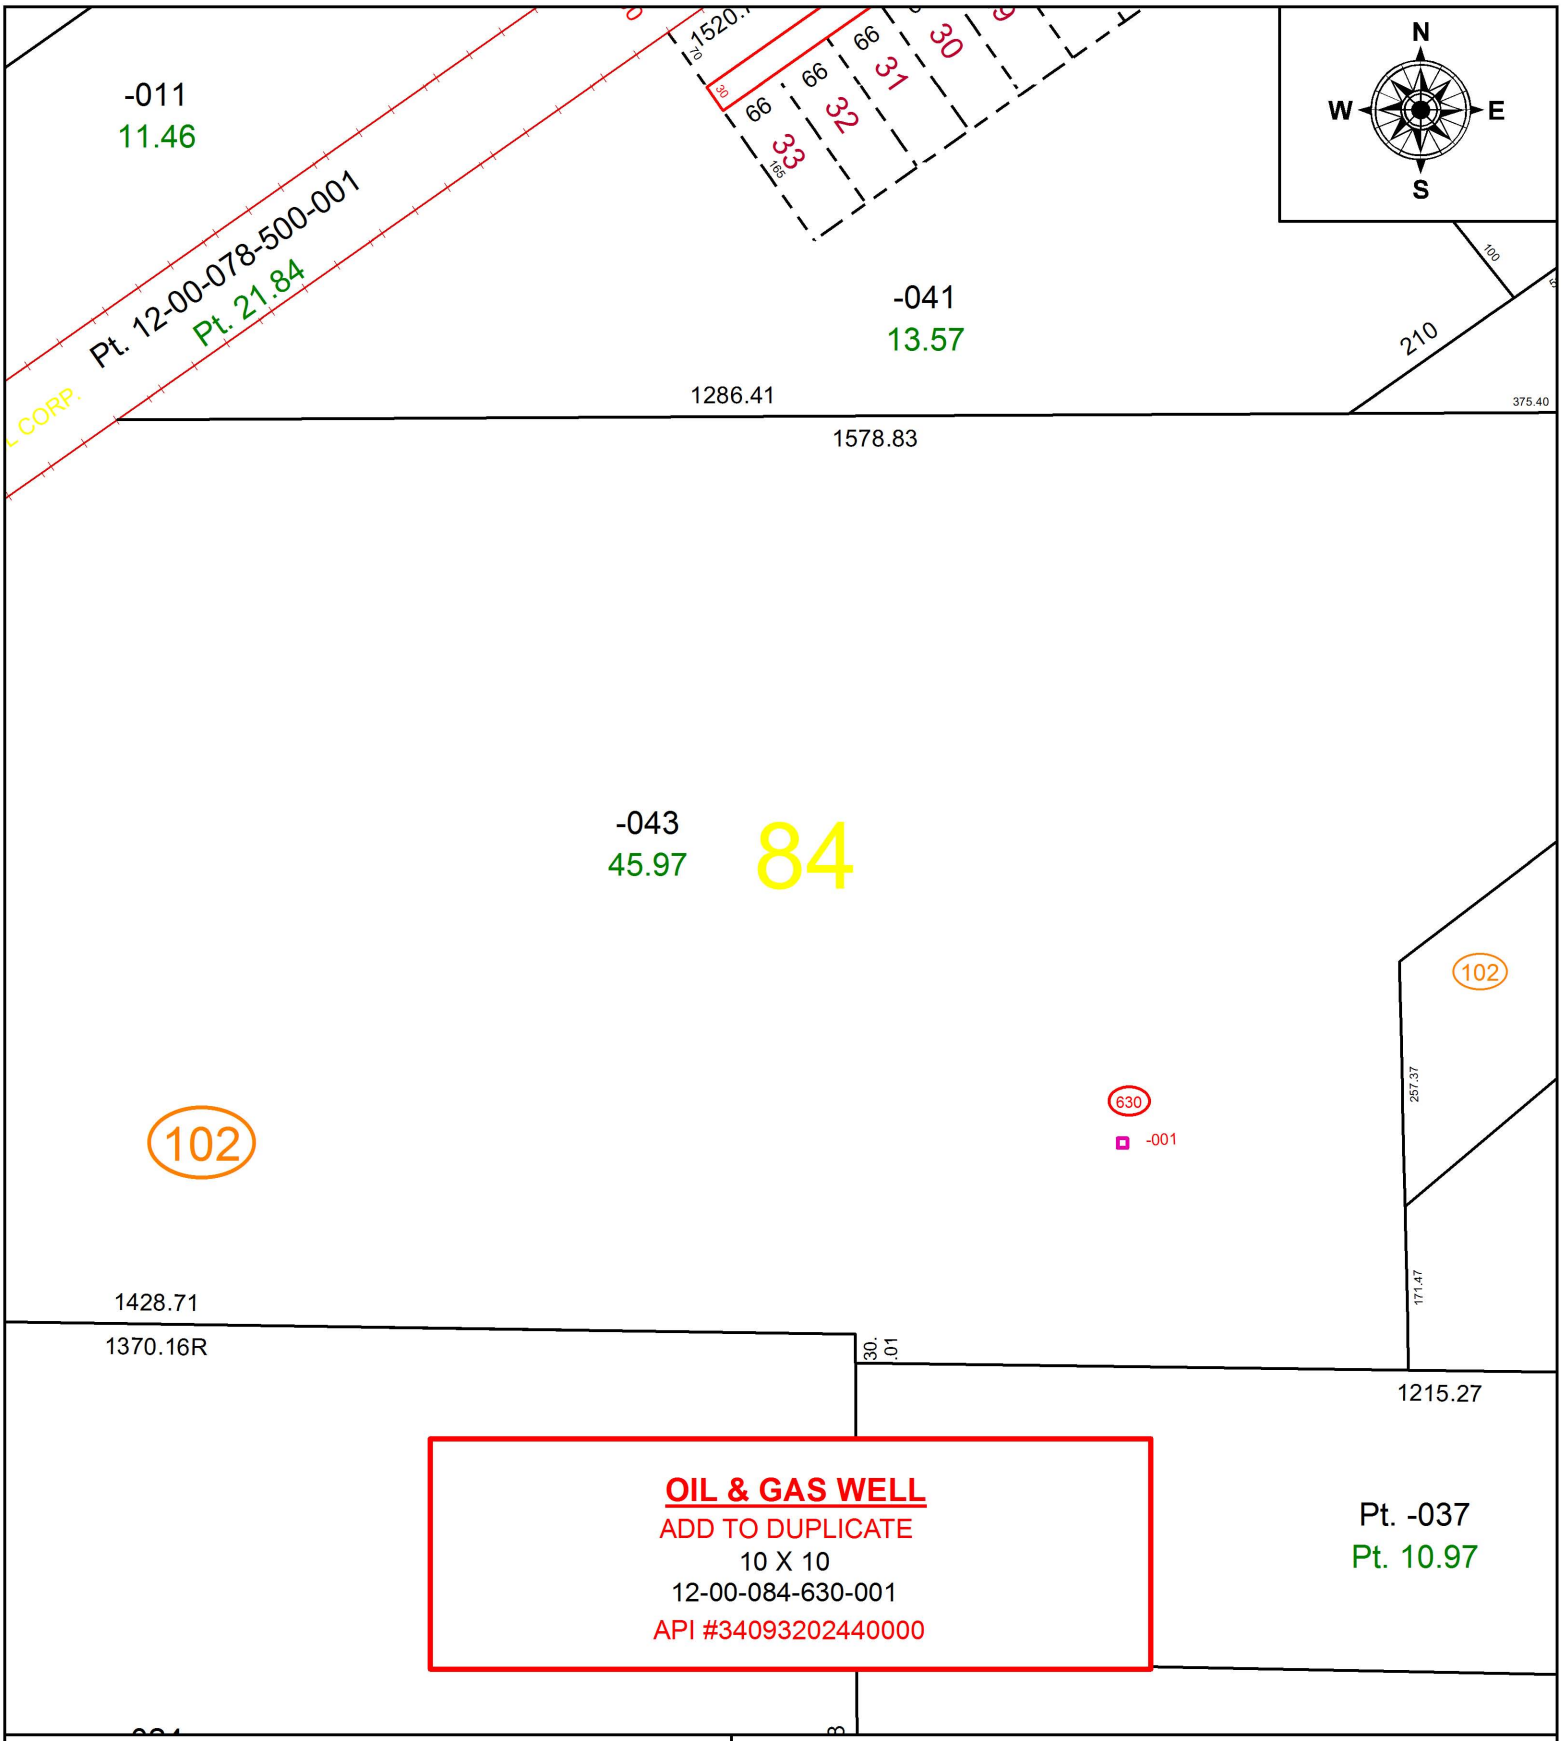

SPLITS/DEEDS PROCESSED
LORAIN COUNTY TAX MAP DEPARTMENT
226 MIDDLE AVE. ELYRIA, OH

SURVEYED BY: N/A
CLOSURE: N/A
MAP PAGE(S): 12-00-084
APPOVED BY: RRM **DATE:** 9-25-17
SCALE: 1" = 200 **PRIOR INSTRUMENT:** N/A