PARENT PARCEL: 12-00-059-000-028
CHILD PARCEL: 12-00-059-630-001
STARTING POINT:

17-03758-G

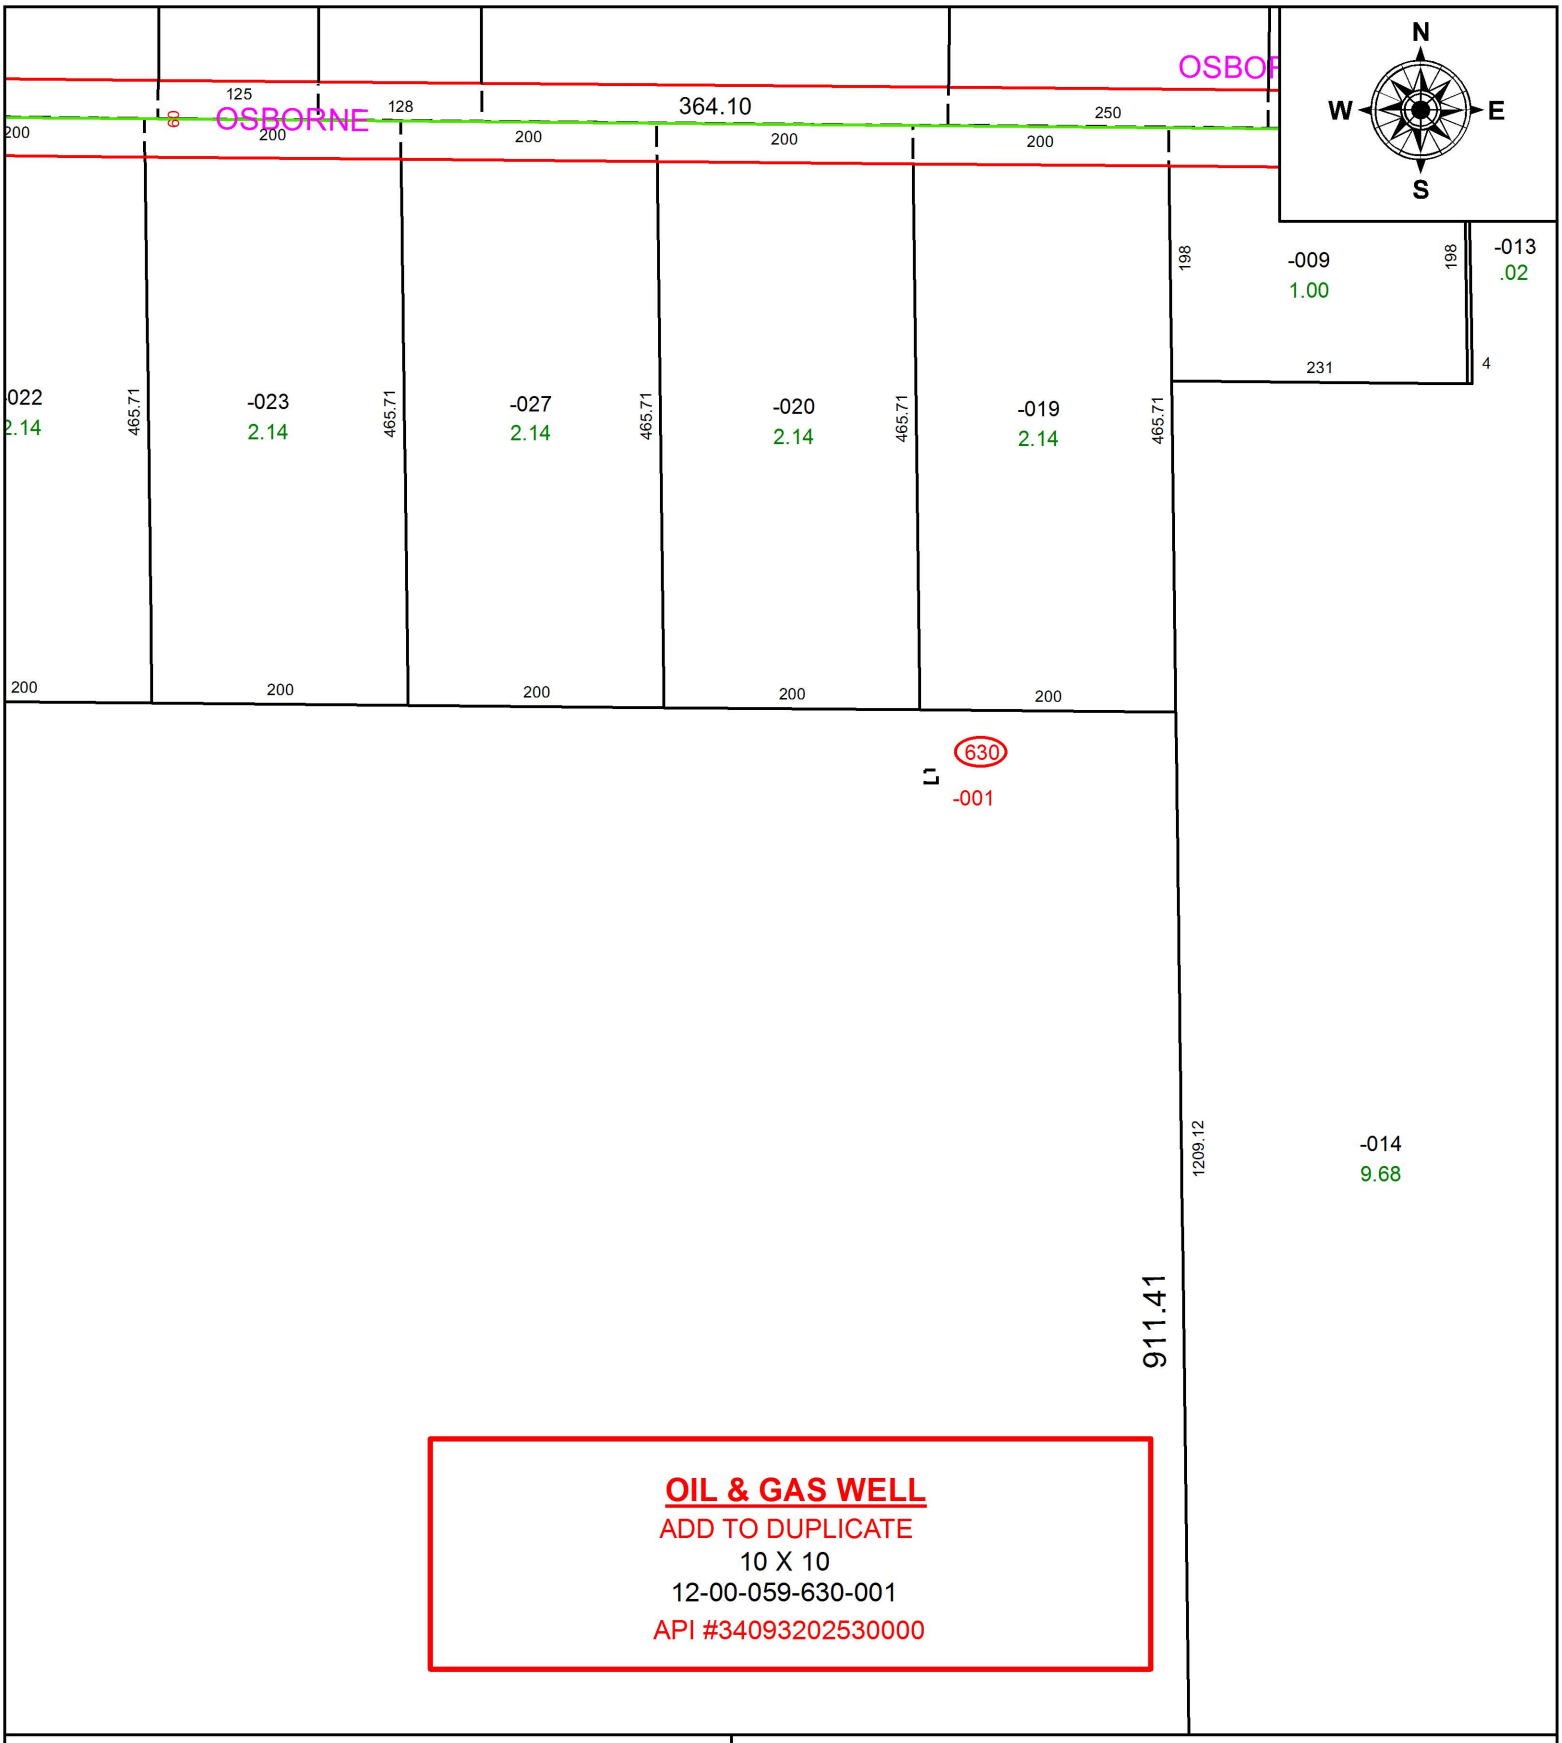

OIL & GAS WELL
ADD TO DUPLICATE
10 X 10
12-00-059-630-001
API #34093202530000

SPLITS/DEEDS PROCESSED
LORAIN COUNTY TAX MAP DEPARTMENT
226 MIDDLE AVE. ELYRIA, OH

SURVEYED BY: N/A
CLOSURE: N/A
MAP PAGE(S): 12-00-059
APPOVED BY: RRM **DATE:** 9-25-17
SCALE: 1" = 150 **PRIOR INSTRUMENT:** N/A