PARENT PARCEL: 13-09-033-000-008, -011

CHILD PARCEL: 13-09-033-000-016 THRU -019

STARTING POINT: SOUTHWEST CORNER OF O.L.33

17-03758

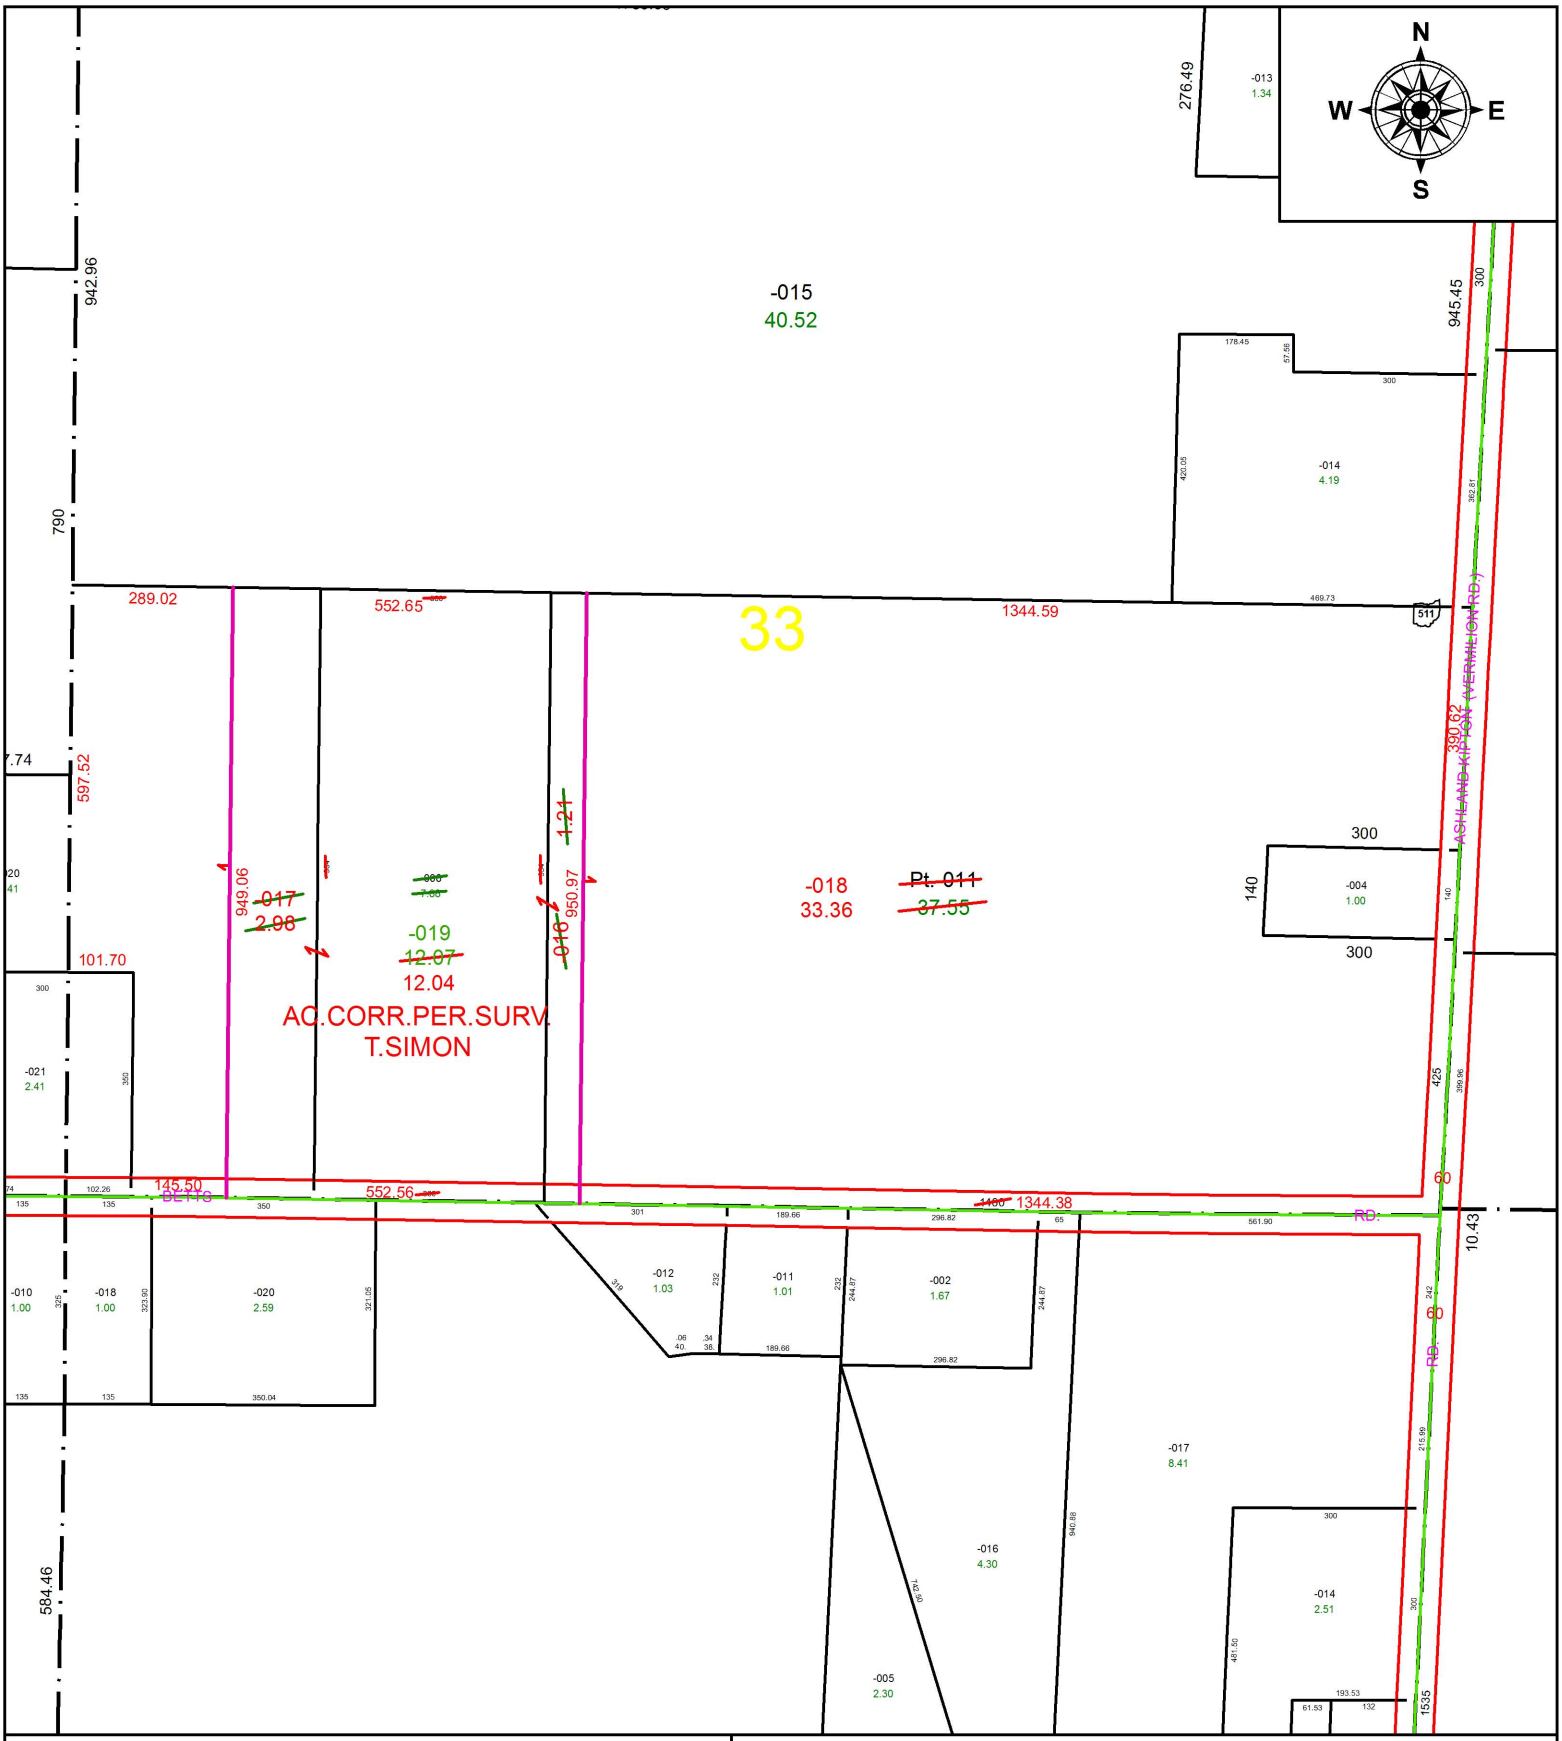

SPLITS/DEEDS PROCESSED

LORAIN COUNTY TAX MAP DEPARTMENT
226 MIDDLE AVE. ELYRIA, OH

SURVEYED BY: THOMAS A. SIMON
CLOSURE: 1: 264,704
MAP PAGE(S): 13-F
APPOVED BY: RRM **DATE:** 12-18-17
SCALE: 1" = 300 **PRIOR INSTRUMENT:** 20170619298